

#124
18-8

21808282000

LA CROSSE COUNTY


U.S. PUBLIC LAND SURVEY MONUMENT RECORD

QUARTER Corner common to Sections 27 & 28

T. 18 N., R. 8 W.

Type of monument NO MONUMENT SET

Location indicated on sketch -  -

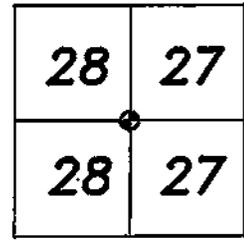

Location Sketch

Describe any record evidence, monument evidence, occupational evidence, testimonial evidence or any other material evidence you considered, and whether the monument was found or placed.

ORIGINAL GOVERNMENT ACCESSORIES WOULD HAVE BEEN SEARCHED FOR BY THE UNITED STATES ENGINEER OFFICE IN 1932, IN CONJUNCTION WITH THE TRAVERSE ALONG THE EAST LINE OF SECTION 28-18-8. U.S.E.O. NOTES INDICATE THAT NO CORNER EVIDENCE WAS FOUND AT THE EAST QUARTER CORNER OF SECTION 28-18-8. HOWEVER, THE NOTES DO SHOW LOCATIONS OF THE BANKS OF THE BLACK RIVER, WHICH APPEAR TO BE CONSISTENT WITH ORIGINAL GOVERNMENT SURVEY NOTES. A POSITION FOR THIS CORNER WAS DETERMINED BY SINGLE PROPORTIONATE MEASUREMENT BETWEEN THE NORTHEAST AND SOUTHEAST CORNERS OF SECTION 28-18-8. THIS POSITION MATCHES WELL WITH THE LOCATION OF THE BLACK RIVER, AS NOTED BY THE U.S.E.O. IN 1932. IT ALSO MATCHES ORIGINAL GOVERNMENT DISTANCE TO BOTH THE NORTHWEST AND NORTHEAST CORNERS BY ABOUT 4 FEET. THEREFORE, BELIEVING THIS POSITION, AS DESCRIBED, TO BE THE BEST AVAILABLE EVIDENCE OF THIS CORNER'S ORIGINAL LOCATION, A COMPUTED POSITION WAS DOCUMENTED AS INDICATED ON THIS SHEET.

Show a plan view drawing depicting the relevant monuments, providing reference ties to at least 4 witness monuments. Describe witness monuments. Show relationship to occupation.

NO MONUMENT WAS SET. POSITION LOCATED IN SWAMPY BACK WATER OF THE BLACK RIVER. PLEASE REFER TO SECTION DATA SHEETS ON FILE AT THE COUNTY SURVEYOR'S OFFICE FOR COORDINATE POSITION OF THIS CORNER.

Corner Identifier number 72-324



no scale

