

TREMPEALEAU COUNTY

U.S. PUBLIC LAND SURVEY MONUMENT RECORD

SECTION Corner common to Sections 28, 29, 32 & 33

T. 18 N., R. 8 W.

Type of monument 7/8" X60" REBAR WITH ALUMINUM CAP

Location indicated on sketch -  -


29	28
32	33

Location Sketch

Describe any record evidence, monument evidence, occupational evidence, testimonial evidence or any other material evidence you considered, and whether the monument was found or placed.

ORIGINAL GOVERNMENT ACCESSORIES WERE SEARCHED FOR, BUT NOTHING WAS FOUND. OTHER MONUMENT EVIDENCE WAS SEARCHED FOR, AND A 2-1/2", OUTSIDE DIAMETER, IRON PIPE APPROXIMATELY 3 FEET ABOVE THE SURFACE IN A SWAMP, WAS FOUND. THIS IRON PIPE WAS CALLED FOR BY G. DECHANT IN HIS 1992 SURVEY. ACCORDING TO G. DECHANT THIS POSITION WAS DETERMINED BY PRORATING DISTANCE BETWEEN THE NORTHEAST CORNER OF SECTION 33-18-8 AND THE NORTHWEST CORNER OF SECTION 32-18-8. IT APPEARS AS THIS METHOD WAS USED BY G. DECHANT TO DETERMINE THE EAST/WEST POSITION OF THIS CORNER. IT APPEARS G. DECHANT DETERMINED THE NORTH/SOUTH POSITION OF THIS CORNER BY HOLDING LINE BETWEEN THE NORTHWEST CORNER OF SECTION 32-18-8 AND EAST/WEST OCCUPATION FOUND AT THE NORTH QUARTER CORNER OF SECTION 33-18-8. APPARENTLY THIS CORNER WAS DETERMINED TO BE LOST BY G. DECHANT IN 1992 AND WAS REESTABLISHED BY A FORM OF SINGLE PROPORTIONATE MEASUREMENT. REESTABLISHING THIS SECTION CORNER BY LOST CORNER METHODS WOULD REQUIRE DOUBLE PROPORTIONATE MEASUREMENT, RATHER THAN SINGLE PROPORTION. THEREFORE, THIS CORNER WAS REESTABLISHED BY DOUBLE PROPORTIONATE MEASUREMENT BETWEEN THE EAST QUARTER CORNER OF SECTION 29-18-8 AND THE SOUTHEAST CORNER OF SECTION 32-18-8 AND BETWEEN THE NORTHWEST CORNER OF SECTION 32-18-8 AND THE NORTH QUARTER CORNER OF SECTION 33-18-8. THIS POSITION IS LOCATED 12.05 FEET SOUTHERLY OF THE FOUND 2-1/2" IRON PIPE. THIS POSITION MATCHES ORIGINAL GOVERNMENT DISTANCE TO THE EAST QUARTER CORNER OF SECTION 29-18-8 BY LESS THAN 3 FEET. IT ALSO MATCHES ORIGINAL GOVERNMENT DISTANCE TO THE SOUTHEAST CORNER OF SECTION 32-18-8 BY ABOUT 5 FEET. THEREFORE, BELIEVING FOUND IRON PIPE TO HAVE BEEN REESTABLISHED INCORRECTLY USING AN INCORRECT PROCEDURE, AND BELIEVING THE DOUBLE PROPORTIONATE POSITION, AS DESCRIBED, TO BE THE BEST AVAILABLE EVIDENCE OF THIS CORNER'S ORIGINAL LOCATION, A 7/8" X60" REBAR WITH AN ALUMINUM CAP WAS SET AS SHOWN BELOW.

Show a plan view drawing depicting the relevant monuments, providing reference ties to at least 4 witness monuments. Describe witness monuments. Show relationship to occupation.

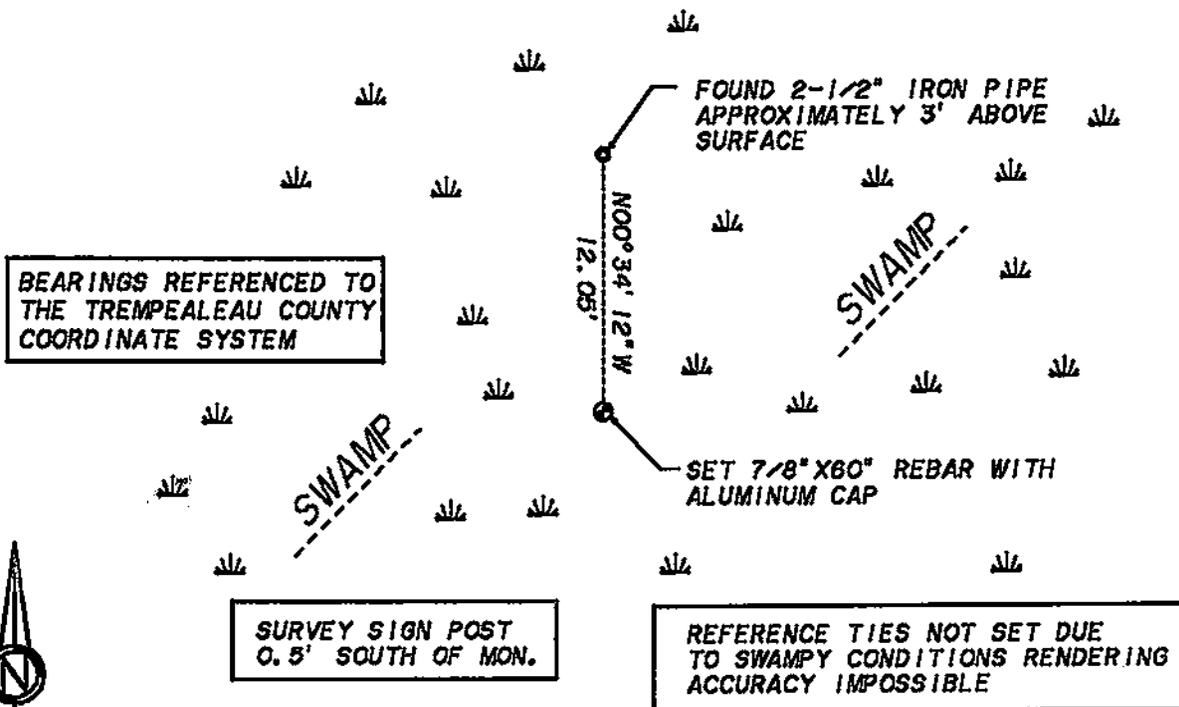

Corner identifier number

80-328

no scale

