

# TREMPEALEAU COUNTY


## U.S. PUBLIC LAND SURVEY MONUMENT RECORD

QUARTER Corner common to Sections 28 & 29

T. 18 N., R. 8 W.

Type of monument 7/8" X30" REBAR WITH ALUMINUM CAP

Location indicated on sketch -  -

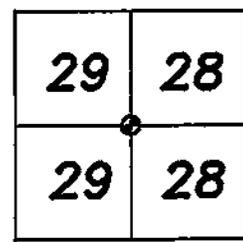

Location Sketch

Describe any record evidence, monument evidence, occupational evidence, testimonial evidence or any other material evidence you considered, and whether the monument was found or placed.

ORIGINAL GOVERNMENT ACCESSORIES WERE SEARCHED FOR, BUT NOTHING WAS FOUND. OTHER MONUMENT EVIDENCE WAS SEARCHED FOR, BUT NONE WAS FOUND. THIS CORNER LOCATION WOULD HAVE BEEN REQUIRED FOR R. CHALSMAS SURVEY OF 1985. THIS SURVEY FIRM WAS CONTACTED AND INFORMATION WAS RECEIVED. THIS INFORMATION INDICATED THAT THIS CORNER POSITION WAS DETERMINED BY HOLDING A SINGLE PROPORTION POSITION BETWEEN THE NORTHEAST CORNER OF SECTION 20-18-8 AND THE SOUTHEAST CORNER OF SECTION 32-18-8. IN 1932 THE U.S.E.O. TRAVERSED THE EAST LINE OF SECTION 29-18-8. ACCORDING TO U.S.E.O. SURVEY NOTES, A FARMER POINTED OUT THE LOCATION, IN A NORTH/SOUTH FENCE LINE, OF THE ORIGINAL QUARTER CORNER TO THEM. THE NOTES ALSO SHOW A MATHEMATICAL LOCATION OF A FOUND WHITE OAK STUMP, WHICH THEY BELIEVED TO BE VERY LIKELY, THE ORIGINAL BEARING TREE. THE MATHEMATICAL POSITION OF THE CORNER LOCATION AS PER THE FARMER AND THE LOCATION OF THE STUMP WERE RECONSTRUCTED BASED ON U.S.E.O. NOTES. THE STUMP LOCATION WAS FOUND TO MATCH THE FARMER'S CORNER LOCATION BY ABOUT 2 FEET NORTH/SOUTH AND BY ABOUT 2 FEET EAST/WEST. A POSITION FOR THIS CORNER WAS DETERMINED BASED ON THE MATHEMATICAL LOCATION OF A FOUND WHITE OAK STUMP, BELIEVED TO BE THE ORIGINAL GOVERNMENT BEARING TREE, BY THE U.S.E.O.. THIS POSITION FALLS APPROXIMATELY ON A REMNANT NORTH/SOUTH FENCE LINE. AN OBVIOUS DEPRESSION WAS FOUND, POSSIBLY FROM A ROTTED OUT STUMP, AT THE COMPUTED LOCATION OF THE U.S.E.O. STUMP. THIS POSITION MATCHES ORIGINAL GOVERNMENT DISTANCE TO THE SOUTHEAST CORNER OF SECTION 32-18-8 BY LESS THAN 8 FEET. IT ALSO MATCHES LINE BETWEEN THE NORTHEAST AND SOUTHEAST CORNERS OF SECTION 29-18-8 BY ABOUT 9 FEET. THEREFORE, BELIEVING THE PROCEDURE UTILIZED BY R. CHALSMAS IN 1985 TO BE AN INAPPROPRIATE METHOD OF REESTABLISHING THIS CORNER AND BELIEVING THE U.S.E.O. POSITION, AS DESCRIBED, TO BE THE BEST AVAILABLE EVIDENCE OF THIS CORNER'S ORIGINAL LOCATION, A 7/8" X30" REBAR WITH AN ALUMINUM CAP WAS SET AND REFERENCED AS SHOWN BELOW.


Show a plan view drawing depicting the relevant monuments, providing reference ties to at least 4 witness monuments. Describe witness monuments. Show relationship to occupation.

o SET 5/8" X24" REBAR WITH PLASTIC CAP

BEARINGS REFERENCED TO THE TREMPEALEAU COUNTY COORDINATE SYSTEM



no scale

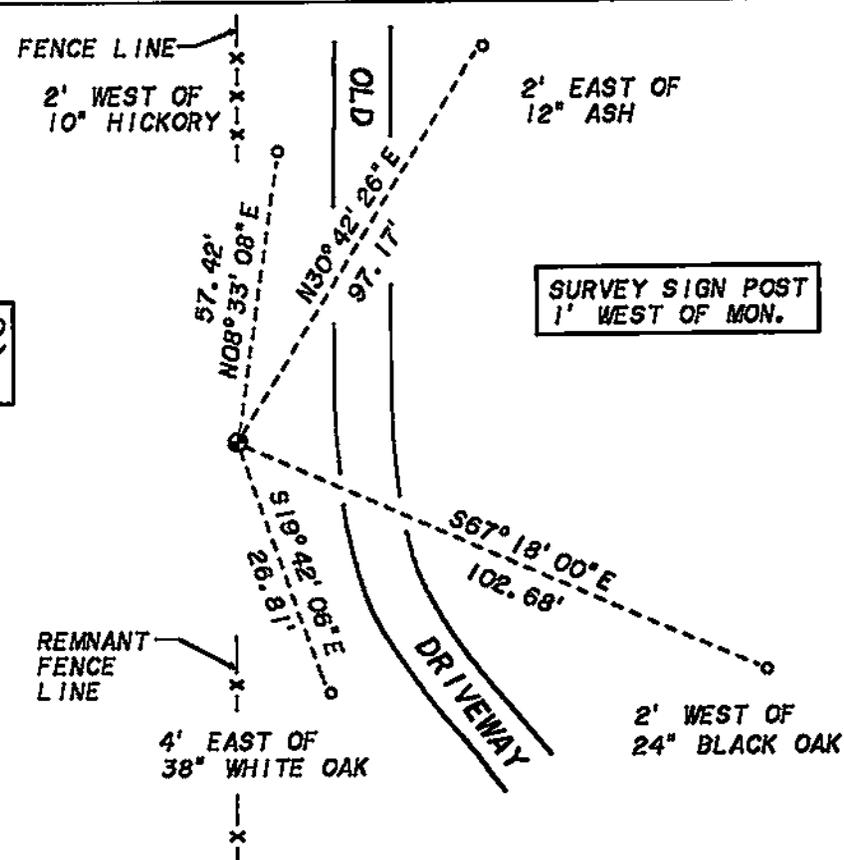

Corner Identifier number

80-324

