

21808320000

# TREMPEALEAU COUNTY

## U.S. PUBLIC LAND SURVEY MONUMENT RECORD

SECTION Corner common to Sections 4, 5, 32 & 33

T. 17 & 18 N., R. 8 W.

Type of monument 7/8" X 60" REBAR WITH ALUMINUM CAP

Location indicated on sketch - ⊕ -

32 T18N	33 T17N
5	4


Location Sketch

Describe any record evidence, monument evidence, occupational evidence, testimonial evidence or any other material evidence you considered, and whether the monument was found or placed.

ORIGINAL GOVERNMENT ACCESSORIES WERE SEARCHED FOR, BUT NOTHING WAS FOUND. OTHER MONUMENT EVIDENCE WAS SEARCHED FOR, AND A CONCRETE, BRONZE CAPPED MONUMENT WAS FOUND. MONUMENT WAS FOUND IN A SMALL, SHALLOW CREEK WITH A SURVEY SIGNPOST WIRED TO IT. FOUND CONCRETE MONUMENT MATCHES THE DESCRIPTION OF A MONUMENT SET BY THE UNITED STATES BIOLOGICAL SURVEY IN 1931 AND FOUND BY AT LEAST FOUR SUBSEQUENT SURVEYORS OF RECORD. ALSO FOUND U.S.B.S. ELM BEARING TREE, NOW A STUMP. THIS POSITION MATCHES THE MATHEMATICAL LOCATION, AS INDICATED BY R. MURPHY SURVEY OF 1996. FOUND MONUMENT IS VERY UNSTABLE, DUE TO BEING LOCATED IN SMALL CREEK BED. THEREFORE, BELIEVING FOUND MONUMENT, AS DESCRIBED, TO BE THE BEST AVAILABLE EVIDENCE OF THIS CORNER'S ORIGINAL LOCATION, A 7/8" X 60" REBAR WITH AN ALUMINUM CAP WAS SET IN ITS PLACE AND REFERENCED AS SHOWN BELOW.

Show a plan view drawing depicting the relevant monuments, providing reference ties to at least 4 witness monuments. Describe witness monuments. Show relationship to occupation.

○ SET 5/8" X 24" REBAR WITH PLASTIC CAP

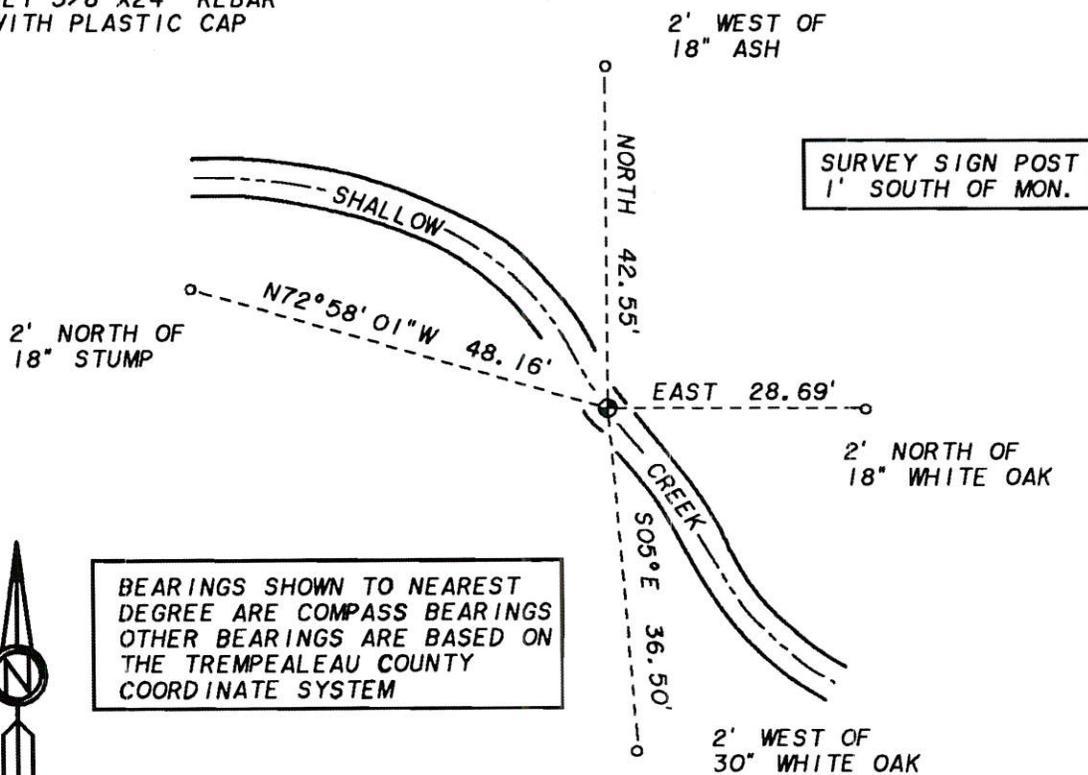

BEARINGS SHOWN TO NEAREST DEGREE ARE COMPASS BEARINGS OTHER BEARINGS ARE BASED ON THE TREMPEALEAU COUNTY COORDINATE SYSTEM



no scale

Corner identifier number 21808320000

Describe any material discrepancy between the location of the corner as restored or reestablished and the location of that corner as previously restored or reestablished by distance and direction. Show the discrepancy on the plan view drawing. Show the distances between the corner as restored or reestablished, and (1) the corner as restored or reestablished, and (2) to at least 2 of the witness monuments shown on the drawing.

**NO MATERIAL DISCREPANCY WAS FOUND.**

Was the corner restored through acceptance of (1) an obliterated evidence location, (2) a found perpetuated location, or (3) an existent corner location?

**A FOUND PERPETUATED LOCATION.**

Was the corner reestablished through lost corner proportionate methods? If so, show the method including the directions and distances to othe public land survey corners used as evidence or used for proportioning in determining the corner location.

**NO.**

Show the corner history of record in chronological order from Original Government Survey to present.

**ORIGINAL GOVERNMENT SURVEY - JAS. FREEMAN - NOVEMBER 1845  
SET POST FOR SECTION CORNER. MARKED TWO BEARING TREES.**

**UNITED STATES BIOLOGICAL SURVEY - CAMPBELL - SEPTEMBER 1931  
SURVEYS FOR WILD LIFE REFUGE NEAR THE MISSISSIPPI RIVER. FOUND THE POINT OF A ROTTED OAK STAKE WITH BURNED ELM AND OAK STUMPS THAT CONFORM TO ORIGINAL GOVERNMENT BEARING TREES. SET A STANDARD CONCRETE POST WITH BRONZE CAP. MARKED TWO BEARING TREES.**

**UNITED STATES ENGINEER OFFICE - L. JENSEN - JULY 1932  
SURVEYS FOR LOCK AND DAM SYSTEM ALONG THE MISSISSIPPI RIVER. CALLS FOR A FOUND 3" DIAMETER CONCRETE MONUMENT WITH A BRONZE CAP AT THE SOUTHEAST CORNER OF SECTION 32-18-8.**

**CERTIFIED SURVEY MAP - G. DECHANT - FEBRUARY 1992  
SURVEYS PARCEL IN SECTION 33-18-8. CALLS FOR A FOUND CONCRETE MARKER WITH A BRASS CAP AT THE SOUTHWEST CORNER OF SECTION 33. ALSO FOUND CAMPBELL'S ELM BEARING TREE.**

**U. S. PUBLIC LAND SURVEY MONUMENT RECORD - W. JUNG - JULY 1992  
FILES TIE SHEET IN LACROSSE COUNTY FOR THE NORTHWEST CORNER OF SECTION 4-17-8. FOUND BRASS CAPPED CONCRETE MARKER, AS CALLED FOR BY J.R. CAMPBELL IN 1931 AND BY G. DECHANT IN 1992. MARKER FALLS IN CREEK. SIGN POST WAS TIED TO IT. ALSO ESTABLISHED FOUR REFERENCE TREES.**

**PRIVATE LAND SURVEYOR'S RECORDS - R. MURPHY - OCTOBER 1996  
SURVEYS FOR THE UNITED STATES DEPARTMENT OF THE INTERIOR. CALLS FOR A FOUND U. S. GOVERNMENT MONUMENT AT THE NORTHEAST CORNER OF SECTION 5-17-8.**

I, JOSEPH P. NELSEN  
certify that the corner location shown on this record was determined by me or under my direction and control and that this U.S. Public Land Survey Monument Record is correct to the best of my knowledge and belief.

Joseph P. Nelsen 7-20-99  
Signature Date

Affix Land Surveyor Seal

