

21808 32 2000

TREMPEALEAU COUNTY


U.S. PUBLIC LAND SURVEY MONUMENT RECORD

QUARTER Corner common to Sections 32 8 33

T. 18 N., R. 8 W.

Type of monument 7/8" X60" REBAR WITH ALUMINUM CAP

Location indicated on sketch - ⊕ -

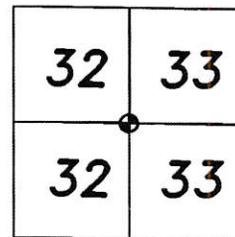


Location Sketch

Describe any record evidence, monument evidence, occupational evidence, testimonial evidence or any other material evidence you considered, and whether the monument was found or placed.

ORIGINAL GOVERNMENT ACCESSORIES WERE SEARCHED FOR, BUT NOTHING WAS FOUND. OTHER MONUMENT EVIDENCE WAS SEARCHED FOR, BUT NONE WAS FOUND. APPARENTLY THE UNITED STATES ENGINEER OFFICE DID NOT FIND ANY EVIDENCE AT THIS CORNER LOCATION, AS INDICATED BY THEIR 1932 SURVEY NOTES. THIS CORNER WAS CONSIDERED AS LOST AND WAS REESTABLISHED BY SINGLE PROPORTIONATE MEASUREMENT BETWEEN THE REESTABLISHED NORTHEAST CORNER OF SECTION 32-18-8 AND THE SOUTHEAST CORNER OF SECTION 32-18-8. G. DECHANT SURVEY OF 1992 REQUIRED THIS CORNER POSITION. HIS SURVEY MAP NOTES NO EVIDENCE WAS FOUND AT THIS CORNER LOCATION, COMPUTED LOCATION ONLY. APPARENTLY G. DECHANT COMPUTED THIS CORNER POSITION BY SINGLE PROPORTIONATE MEASUREMENT BETWEEN THE NORTHEAST AND SOUTHEAST CORNERS OF SECTION 32-18-8. HOWEVER, G. DECHANT POSITION OF THE NORTHEAST CORNER OF SECTION 32-18-8 WAS FOUND TO BE APPROXIMATELY 12 FEET NORTHERLY OF THE REESTABLISHED NORTHEAST CORNER OF SECTION 32-18-8, THEREBY RESULTING IN G. DECHANT COMPUTED POSITION OF THIS QUARTER CORNER BEING APPROXIMATELY 6 FEET NORTHERLY OF THE REESTABLISHED QUARTER CORNER. THIS POSITION MATCHES ORIGINAL GOVERNMENT DISTANCE TO BOTH THE NORTHEAST AND SOUTHEAST CORNERS OF SECTION 32-18-8 BY LESS THAN 3 FEET. THEREFORE, BELIEVING G. DECHANT COMPUTED POSITION TO HAVE BEEN DETERMINED BASED ON AN INCORRECT POSITION OF THE NORTHEAST CORNER OF SECTION 32-18-8, AND BELIEVING THE SINGLE PROPORTIONATE POSITION, AS DESCRIBED, TO BE THE BEST AVAILABLE EVIDENCE OF THIS CORNER'S ORIGINAL LOCATION, A 7/8" X60" REBAR WITH AN ALUMINUM CAP WAS SET AND REFERENCED AS SHOWN BELOW.

Show a plan view drawing depicting the relevant monuments, providing reference ties to at least 4 witness monuments. Describe witness monuments. Show relationship to occupation.

○ SET 5/8" X24" REBAR WITH PLASTIC CAP

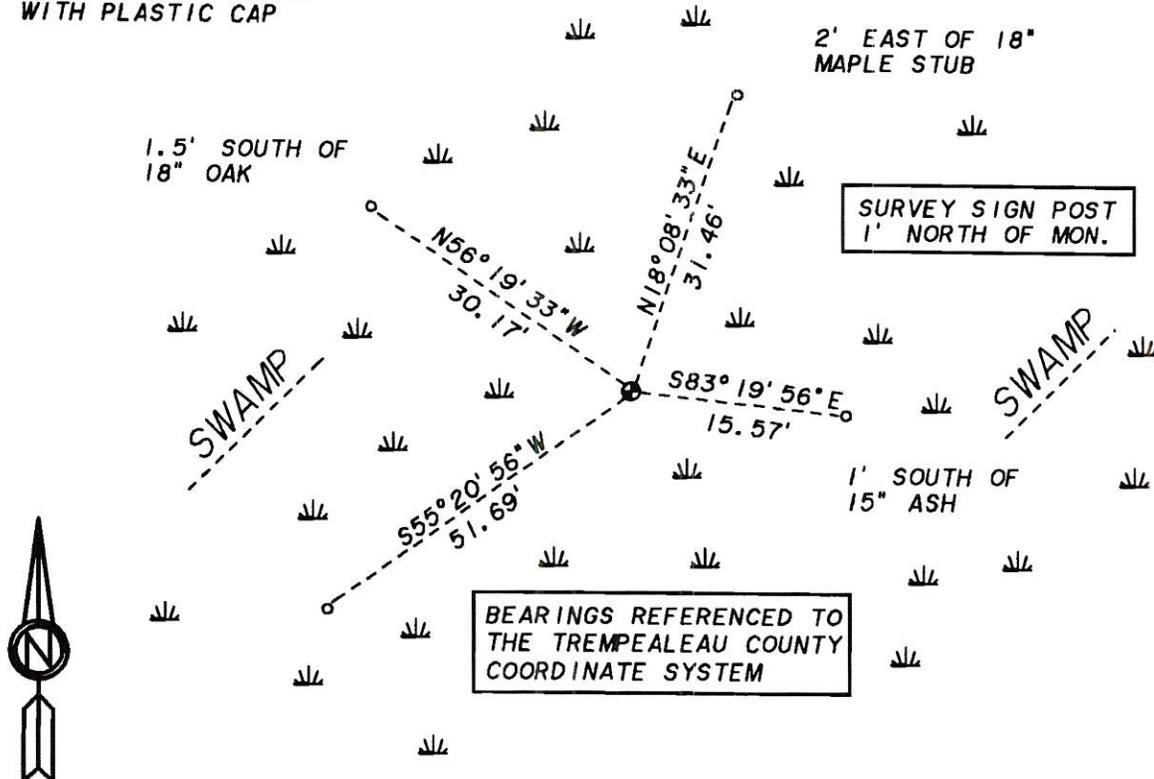

no scale

Corner identifier number 21808 32 2000

Describe any material discrepancy between the location of the corner as restored or reestablished and the location of that corner as previously restored or reestablished by distance and direction. Show the discrepancy on the plan view drawing. Show the distances between the corner as restored or reestablished, and (1) the corner as restored or reestablished, and (2) to at least 2 of the witness monuments shown on the drawing.

NO ACTUAL MONUMENT DISCREPANCY WAS FOUND, ALTHOUGH THIS REESTABLISHED POSITION DOES NOT MATCH A POSITION REQUIRED FOR G. DECHANT SURVEY OF 1992 THIS POSITION IS LOCATED APPROXIMATELY 6 FEET SOUTHERLY OF G. DECHANT POSITION.

Was the corner restored through acceptance of (1) an obliterated evidence location, (2) a found perpetuated location, or (3) an existent corner location?

N/A.

Was the corner reestablished through lost corner proportionate methods? If so, show the method including the directions and distances to othe public land survey corners used as evidence or used for proportioning in determining the corner location.

**YES. SINGLE PROPORTIONATE MEASUREMENT WAS USED BETWEEN THE NORTHEAST AND SOUTHEAST CORNERS OF SECTION 32-18-8.
NORTHEAST CORNER TO EAST QUARTER CORNER = S01°15'33"E, 2637.46 FEET
EAST QUARTER CORNER TO SOUTHEAST CORNER = S01°15'33"E, 2637.46 FEET
(BEARINGS REFERENCED TO THE TREMPALEAU COUNTY COORDINATE SYSTEM)**

Show the corner history of record in chronological order from Original Government Survey to present.

**ORIGINAL GOVERNMENT SURVEY - CYRUS WOODWORTH - SEPTEMBER 1847
SET QUARTER SECTION POST. MARKED TWO BEARING TREES.**

**UNITED STATES ENGINEER OFFICE - L. JENSEN - JULY 1932
SURVEYS FOR LOCK AND DAM SYSTEM ALONG THE MISSISSIPPI RIVER.
TRAVERSES THE EAST LINE OF SECTION 32-18-8. NOTHING NOTED AS BEING FOUND
OR SET AT THE EAST QUARTER CORNER OF SECTION 32.**

**CERTIFIED SURVEY MAP - G. DECHANT - FEBRUARY 1992
SURVEYS PARCEL IN SECTION 33-18-8. SURVEY WOULD REQUIRE THE LOCATION OF
THE WEST QUARTER CORNER OF SECTION 33. NOTES ON MAP THAT NO EVIDENCE WAS
FOUND OF THE WEST QUARTER CORNER OF SECTION 33. COMPUTED LOCATION ONLY.**

I, JOSEPH P. NELSEN
certify that the corner location shown on this record was determined by me or under my direction and control and that this U.S. Public Land Survey Monument Record is correct to the best of my knowledge and belief.

Joseph P. Nelsen 7-20-99
Signature Date

Affix Land Surveyor Seal

