

TREMPEALEAU COUNTY

U.S. PUBLIC LAND SURVEY MONUMENT RECORD

SECTION Corner common to Sections 3, 4, 33 & 34

T. 17 & 18 N., R. 8 W.

Type of monument 7/8" X30" REBAR WITH ALUMINUM CAP

Location indicated on sketch - \odot -

33 T18N	34 T17N
4	3

Location Sketch


Describe any record evidence, monument evidence, occupational evidence, testimonial evidence or any other material evidence you considered, and whether the monument was found or placed.

ORIGINAL GOVERNMENT ACCESSORIES WERE SEARCHED FOR, BUT NOTHING WAS FOUND. OTHER MONUMENT EVIDENCE WAS SEARCHED FOR, AND A 2" PINCHED IRON PIPE WAS FOUND, AS CALLED FOR BY G. DECHANT, W. JUNG AND R. MURPHY. IN 1931 THE U.S.B.S. SET A 3" CONCRETE MONUMENT AT THIS POSITION. THIS CONCRETE MONUMENT WAS FOUND BY THE U.S.E.O. IN 1932 AND AGAIN BY THE U.S.B.S. IN 1934. HAND EXCAVATION AT THIS POSITION UNCOVERED THIS 3" CONCRETE, BRONZE CAPPED MONUMENT, APPROXIMATELY 2 FEET BELOW THE SURFACE. APPARENTLY THIS MONUMENT WAS COVERED WITH SAND BY NEARLY SIXTY YEARS OF SEASONAL FLOODING. CONCRETE MONUMENT WAS FOUND NORTHWESTERLY, 0.55 FEET FROM FOUND 2" IRON PIPE. ALSO FOUND A ROTTEN STUMP OF A TREE NORTHEASTERLY MATCHING U.S.B.S. BEARING TREE CALL BY APPROXIMATELY 2 FEET. FOUND CONCRETE MONUMENT MATCHES FOUND U.S.B.S. MONUMENT AT THE 1/16TH CORNER NORTH OF THIS CORNER BY LESS THAN 0.1 FEET NORTH/SOUTH AND BY LESS THAN 0.2 FEET EAST/WEST. IT MATCHES U.S.B.S. DISTANCE TO THE NORTHEAST CORNER OF SECTION 33-18-8 BY LESS THAN 1 FOOT. IT ALSO MATCHES U.S.B.S. DISTANCE TO THE SOUTH QUARTER CORNER OF SECTION 33-18-8 BY ABOUT 1 FOOT. THEREFORE, BELIEVING FOUND CONCRETE MONUMENT, AS DESCRIBED, TO BE THE BEST AVAILABLE EVIDENCE OF THIS CORNER'S ORIGINAL LOCATION, IT WAS LEFT IN PLACE AND A 7/8" X30" REBAR WITH AN ALUMINUM CAP WAS SET DIRECTLY ABOVE IT AND REFERENCED AS SHOWN BELOW.

Show a plan view drawing depicting the relevant monuments, providing reference ties to at least 4 witness monuments. Describe witness monuments. Show relationship to occupation.

o SET 5/8" X24" REBAR WITH PLASTIC CAP

BEARINGS SHOWN TO THE NEAREST DEGREE ARE COMPASS BEARINGS
OTHER BEARINGS ARE BASED ON THE TREMPEALEAU COUNTY COORDINATE SYSTEM

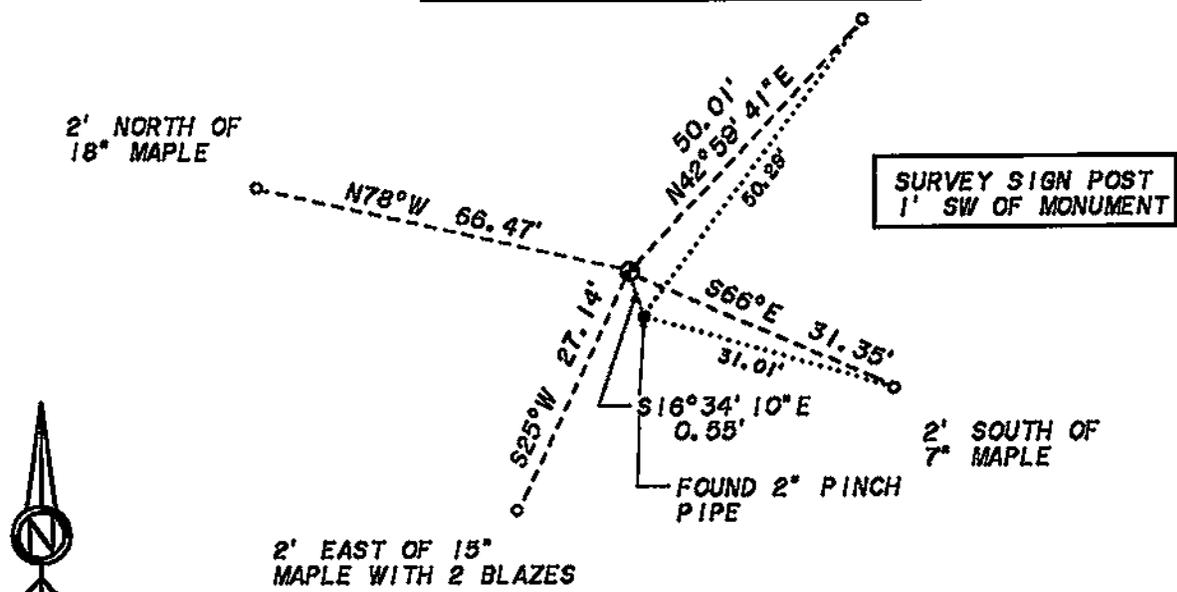

Corner Identifier number 72-336

Describe any material discrepancy between the location of the corner as restored or reestablished and the location of that corner as previously restored or reestablished by distance and direction. Show the discrepancy on the plan view drawing. Show the distances between the corner as restored or reestablished, and (1) the corner as restored or reestablished, and (2) to at least 2 of the witness monuments shown on the drawing.

MATERIAL DISCREPANCY AS FOLLOWS:

**FOUND U.S.B.S. CONCRETE MONUMENT TO FOUND 2" PINCH PIPE -
S18°34' E, 0.55 FEET.
(BEARING REFERENCED TO THE TREMPLEAU COUNTY COORDINATE SYSTEM)**

Was the corner restored through acceptance of (1) an obliterated evidence location, (2) a found perpetuated location, or (3) an existent corner location?

A FOUND PERPETUATED LOCATION.

Was the corner reestablished through lost corner proportionate methods? If so, show the method including the directions and distances to other public land survey corners used as evidence or used for proportioning in determining the corner location.

NO.

Show the corner history of record in chronological order from Original Government Survey to present.

**ORIGINAL GOVERNMENT SURVEY - J.E. FREEMAN - NOVEMBER 1845
SET POST FOR SECTION CORNER. MARKED TWO BEARING TREES.**

**UNITED STATES BIOLOGICAL SURVEY - CAMPBELL - AUGUST 1931
SURVEYS FOR WILDLIFE REFUGE NEAR THE MISSISSIPPI RIVER. NOTES APPEAR TO
INDICATE THAT A STANDARD CONCRETE MONUMENT WAS SET AT THE INTERSECTION OF
MARKED LINES. MARKED TWO BEARING TREES.**

**UNITED STATES ENGINEER OFFICE - L. JENSEN - AUGUST 1932
SURVEYS FOR LOCK AND DAM SYSTEM ALONG THE MISSISSIPPI RIVER. NOTES CALL
FOR A FOUND 3" CONCRETE MONUMENT WITH A BRASS CAP. MARKED TWO BEARING
TREES.**

**UNITED STATES BIOLOGICAL SURVEY - BURRELL - OCTOBER 1934
SURVEYS FOR WILDLIFE REFUGE NEAR THE MISSISSIPPI RIVER. NOTES CALL FOR A
STANDARD U.S.B.S. CONCRETE POST, APPARENTLY FOUND, AT THE SOUTHEAST
CORNER OF SECTION 33-18-8.**

**CERTIFIED SURVEY MAP - G. DECHANT - FEBRUARY 1992
SURVEY PARCEL IN SECTION 33-18-8. MAP NOTES THAT CONCRETE MARKER WAS NOT
FOUND, BUT A 1-1/2" IRON PIPE WAS FOUND. WHICH FIT MEASUREMENTS WELL AND
BEARING TREE TO NORTHEAST.**

**U.S. PUBLIC LAND SURVEY MONUMENT RECORD - W. JUNG - JANUARY 1993
FILES TIE SHEET FOR THE NORTHEAST CORNER OF SECTION 4-17-8. FOUND
EXISTING 2" PINCHED IRON PIPE, AS CALLED FOR BY G. DECHANT. MARKS FOUR
BEARING TREES.**

**PRIVATE LAND SURVEYORS RECORDS - R. MURPHY - OCTOBER 1996
SURVEYS FOR THE UNITED STATES DEPARTMENT OF THE INTERIOR. CALLS FOR A 2"
IRON PIPE FOUND AT THE NORTHEAST CORNER
OF SECTION 4-17-8.**

I, JOSEPH P. NELSEN
certify that the corner location shown on this record
was determined by me or under my direction and control
and that this U.S. Public Land Survey Monument Record
is correct to the best of my knowledge and belief.

Joseph P. Nelsen 8-3-99
Signature Date

Affix Land Surveyor Seal

