


# TREMPEALEAU COUNTY U.S. PUBLIC LAND SURVEY MONUMENT RECORD

QUARTER Corner common to Sections 33 & 34

T. 18 N., R. 8 W.

Type of monument 7/8" X30" REBAR WITH ALUMINUM CAP

Location indicated on sketch -  -

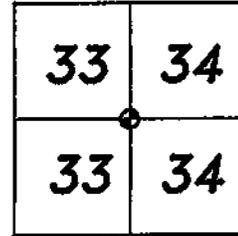

Location Sketch


Describe any record evidence, monument evidence, occupational evidence, testimonial evidence or any other material evidence you considered, and whether the monument was found or placed.

ORIGINAL GOVERNMENT ACCESSORIES WERE SEARCHED FOR, BUT NOTHING WAS FOUND. OTHER MONUMENT EVIDENCE WAS SEARCHED FOR, BUT NOTHING WAS FOUND. IN 1934 THE 1/16TH CORNER SOUTH OF THIS POSITION WAS ESTABLISHED AND MONUMENTED BY THE U.S.B.S.. ACCORDING TO U.S.B.S. NOTES, THIS 1/16TH CORNER WAS DETERMINED BASED ON A SINGLE PROPORTIONATE POSITION FOR THIS QUARTER CORNER. A POSITION FOR THIS QUARTER CORNER WAS REESTABLISHED BASED ON SINGLE PROPORTIONATE MEASUREMENT BETWEEN THE NORTHEAST AND SOUTHEAST CORNERS OF SECTION 33-18-8. THIS POSITION MATCHES U.S.B.S. DISTANCE TO BOTH THE NORTHEAST AND SOUTHEAST CORNERS OF SECTION 33-18-8 BY LESS THAN 1 FOOT. IT ALSO MATCHES THE FOUND U.S.B.S. MONUMENT AT THE 1/16TH CORNER SOUTH OF THIS QUARTER CORNER BY LESS THAN 0.1 FEET NORTH/SOUTH AND BY LESS THAN 0.2 FEET EAST/WEST. THIS POSITION MATCHES THE METHOD UTILIZED BY G. DECHANT IN HIS 1992 SURVEY. THEREFORE, BELIEVING THIS POSITION, AS DESCRIBED, TO BE THE BEST AVAILABLE EVIDENCE OF THIS CORNER'S ORIGINAL LOCATION, A 7/8" X30" REBAR WITH AN ALUMINUM CAP WAS SET AND REFERENCED AS SHOWN BELOW.

Show a plan view drawing depicting the relevant monuments, providing reference ties to at least 4 witness monuments. Describe witness monuments. Show relationship to occupation.

○ SET 5/8" X24" REBAR WITH PLASTIC CAP

BEARINGS REFERENCED TO THE TREMPEALEAU COUNTY COORDINATE SYSTEM

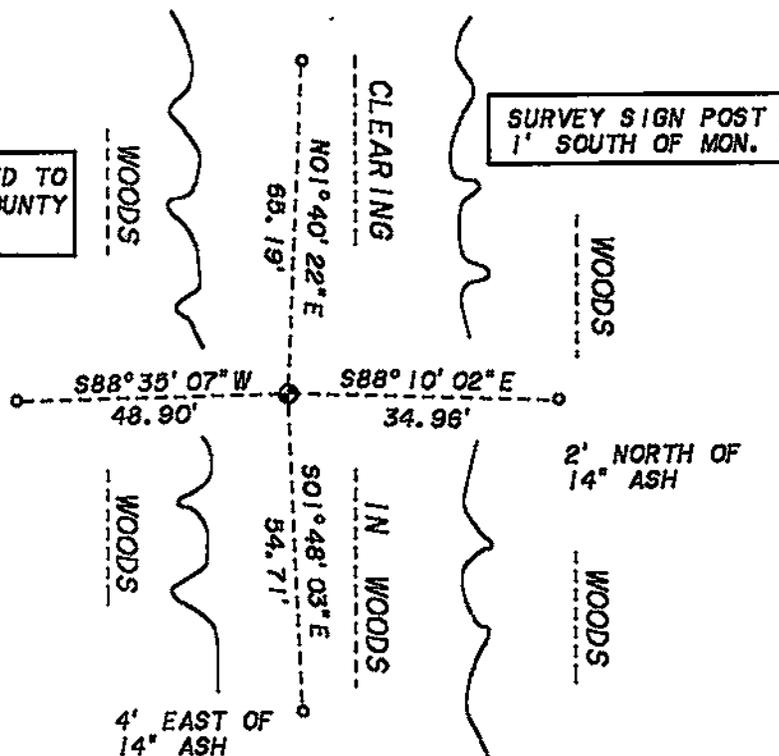

no scale

Corner Identifier number

72-332

Describe any material discrepancy between the location of the corner as restored or reestablished and the location of that corner as previously restored or reestablished by distance and direction. Show the discrepancy on the plan view drawing. Show the distances between the corner as restored or reestablished, and (1) the corner as restored or reestablished, and (2) to at least 2 of the witness monuments shown on the drawing.

**NO MATERIAL DISCREPANCY WAS FOUND.**

Was the corner restored through acceptance of (1) an obliterated evidence location, (2) a found perpetuated location, or (3) an existent corner location?

**N/A.**

Was the corner reestablished through lost corner proportionate methods? If so, show the method including the directions and distances to other public land survey corners used as evidence or used for proportioning in determining the corner location.

**YES. SINGLE PROPORTIONATE MEASUREMENT WAS USED BETWEEN THE NORTHEAST AND SOUTHEAST CORNERS OF SECTION 33-18-8.  
NORTHEAST CORNER TO EAST QUARTER CORNER =  $900^{\circ}56'26''$  E, 2644.19 FEET.  
EAST QUARTER CORNER TO SOUTHEAST CORNER =  $900^{\circ}56'26''$  E, 2644.19 FEET.  
(BEARINGS REFERENCED TO THE TREMPLEAU COUNTY COORDINATE SYSTEM)**

Show the corner history of record in chronological order from Original Government Survey to present.

**ORIGINAL GOVERNMENT SURVEY - CYRUS WOODWORTH - SEPTEMBER 1847  
SET QUARTER SECTION POST. MARKED TWO BEARING TREES.**

**UNITED STATES ENGINEER OFFICE - L. JENSEN - AUGUST 1932  
SURVEY FOR LOCK AND DAM SYSTEM ALONG THE MISSISSIPPI RIVER. TRAVERSES THE EAST LINE OF SECTION 33-18-8. NOTES NOTHING AT THE EAST QUARTER CORNER OF SECTION 33 LOCATION.**

**UNITED STATES BIOLOGICAL SURVEY - BURRELL - OCTOBER 1934  
SURVEYS FOR WILDLIFE REFUGE NEAR THE MISSISSIPPI RIVER. TRAVERSES THE EAST LINE OF SECTION 33-18-8. NOTES INDICATE NOTHING FOUND OR SET AT THE EAST QUARTER CORNER OF SECTION 33. 1/16TH CORNER SOUTH OF THIS QUARTER CORNER WAS SET BASED ON SINGLE PROPORTION BETWEEN THE NORTHEAST AND SOUTHEAST CORNERS OF SECTION 33.**

**CERTIFIED SURVEY MAP - G. DECHANT - FEBRUARY 1992  
SURVEYS PARCEL IN SECTION 33-18-8. MAP STATES THAT NO EVIDENCE WAS FOUND AT THE EAST QUARTER CORNER OF SECTION 33, COMPUTED LOCATION ONLY. IT APPEARS AS THOUGH THIS POSITION WAS COMPUTED BY SINGLE PROPORTION.**

I, JOSEPH P. NELSEN  
certify that the corner location shown on this record was determined by me or under my direction and control and that this U.S. Public Land Survey Monument Record is correct to the best of my knowledge and belief.

Joseph P. Nelsen 8-3-99  
Signature Date

Affix Land Surveyor Seal

