


21808352000

U. S. PUBLIC LAND SURVEY MONUMENT RECORD

SECTION 36 T 18 N, R 8 W, TOWN OF HOLLAND

LA CROSSE COUNTY

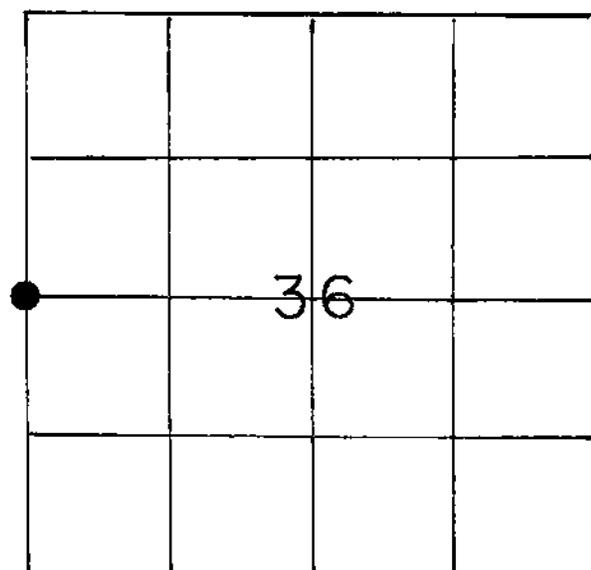

LOCATION OF LANDMARK

Crew: William Jung
 Perry Dahl
 4/10/86

South Zone

WISCONSIN COORDINATE SYSTEM

North 728,563.399

East 1,660,387.981

Theta Angle

Horiz. Order

Vert. Order

TYPE OF LANDMARK
 Berntsen Monument

BEARINGS ARE REFERENCED TO

Grid

Describe any record evidence, monument evidence, testimonial evidence or any other material evidence you considered and whether the monument was found or restored through acceptance of an obliterated evidence location.


I accepted the occupied corner as the best available evidence of the original government corner position and monumented it with a Berntsen monument. The 1976 D.O.T. highway map shows a fence corner at this location. This fence corner has since been torn down.

Describe or show any material discrepancy between the location of the restored corner and that of the corner previously restored or reestablished.

None known.

RECORD OF DURABLE WITNESS MONUMENTS


NO	DESCRIPTION	BEARING	DISTANCE
1	Set 1½" iron pipe	North ±	32.99
2	"	West ±	32.98
3	"	South ±	33.00
4			

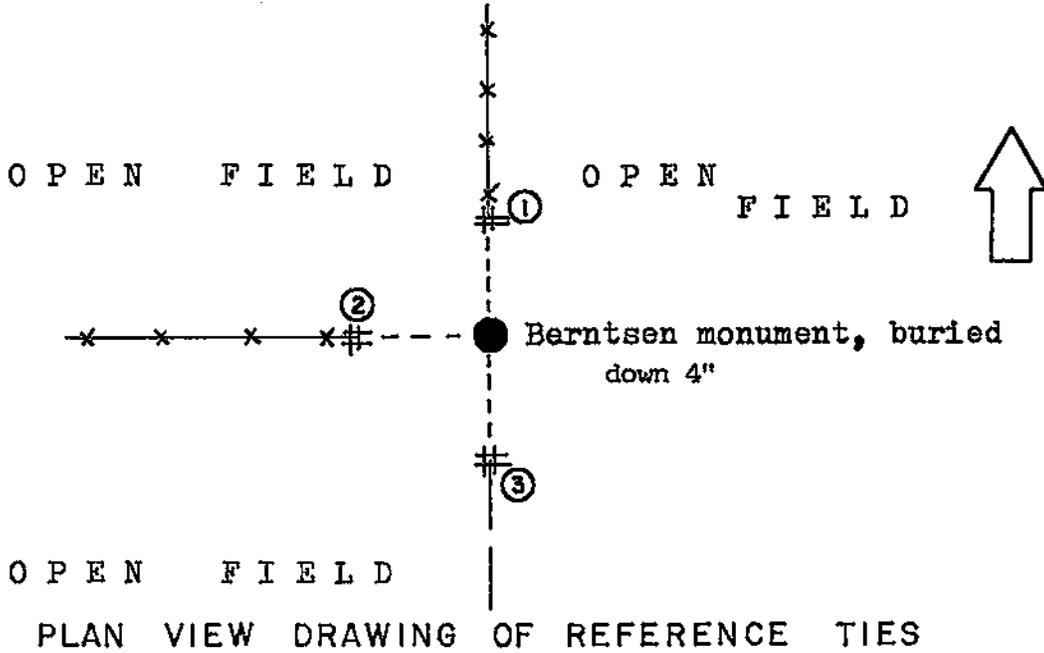

MAP SHOWING DISTANCE AND DIRECTION TO OTHER PUBLIC LAND SURVEY CORNERS USED FOR REESTABLISHING THE CORNER

(not to scale)

Grid bearings and distances

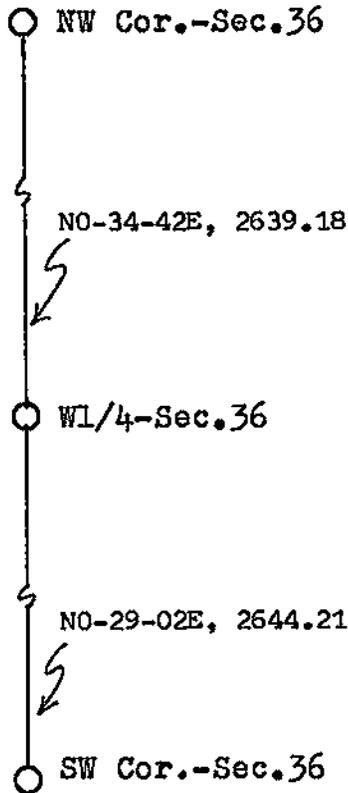

I, William C. Jung, Deputy County Surveyor,
 HEREBY CERTIFY THAT THE CORNER LOCATION SHOWN ON THIS RECORD
 WAS DETERMINED BY ME OR UNDER MY DIRECTION AND CONTROL AND
 THAT THIS U. S. PUBLIC LAND SURVEY MONUMENT RECORD IS CORRECT
 AND COMPLETE TO THE BEST OF MY KNOWLEDGE AND BELIEF.

William C. Jung
 Signature

6/11/86
 Date



Seal