


U. S. PUBLIC LAND SURVEY MONUMENT RECORD

SECTION 36 T 18 N, R 8 W, TOWN OF HOLLAND  
 LA CROSSE COUNTY

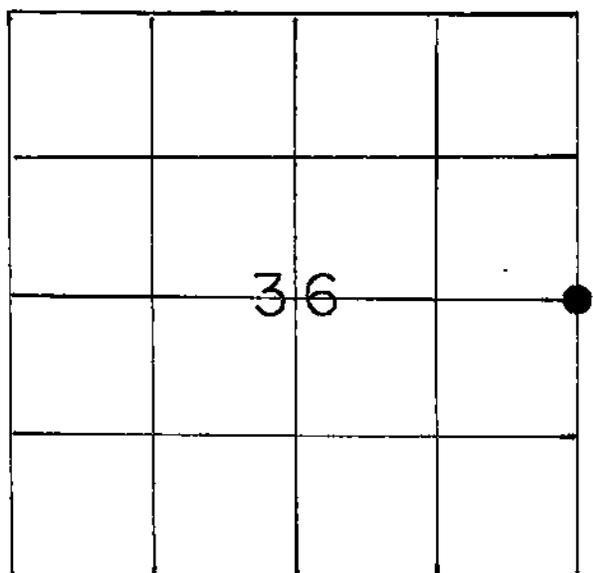

LOCATION OF LANDMARK

Crew: William Jung  
 Perry Dahl

5/29/86

South Zone

WISCONSIN COORDINATE SYSTEM	
North	728,488.591
East	1,665,646.555
Theta Angle	
Horiz. Order	
Vert. Order	
TYPE OF LANDMARK	
Brass Capped Lunde Marker	
BEARINGS ARE REFERENCED TO	
Grid	

Describe any record evidence, monument evidence, testimonial evidence or any other material evidence you considered and whether the monument was found or restored through acceptance of an obliterated evidence location.


I accepted the occupied corner as the best available evidence of the original government corner and monumented this location with a Brass Capped Lunde Marker.

Describe or show any material discrepancy between the location of the restored corner and that of the corner previously restored or reestablished.

None known.

RECORD OF DURABLE WITNESS MONUMENTS  
MAGNETIC

NO	DESCRIPTION	BEARING	DISTANCE
1	To the center of an unblazed 24" oak	North <sub>+</sub>	170'
2	To a P.K. nail in a double blazed 17" oak	S85°W	48.90'
3	To a P.K. nail in a double blazed 12" cherry	S13°E	36.32'
4	To a P.K. nail in a double blazed 12" aspen	S37°E	56.59'

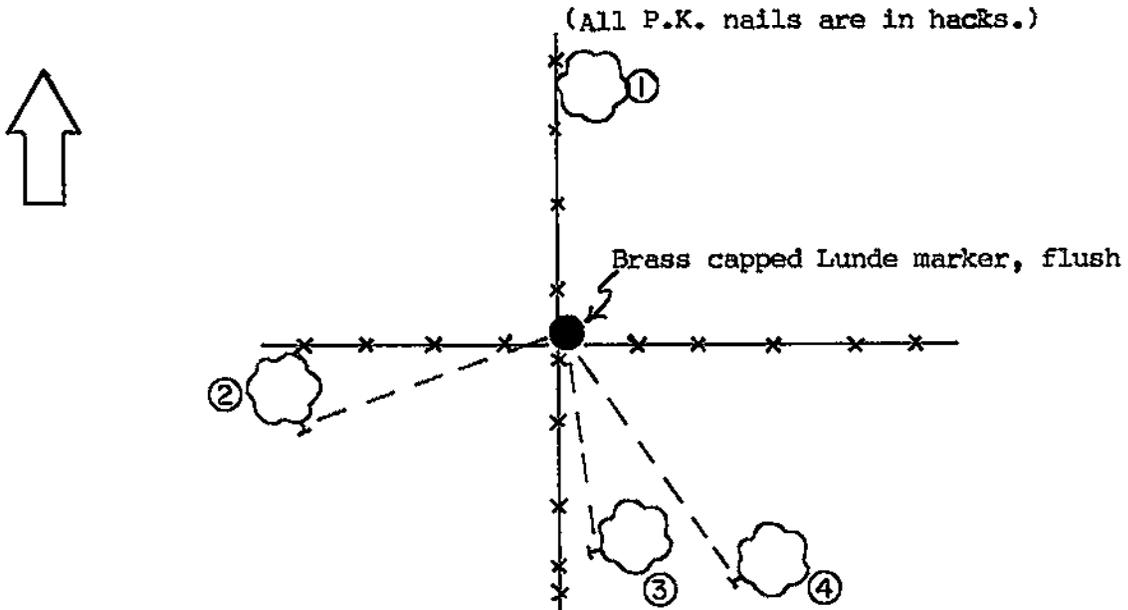


PLAN VIEW DRAWING OF REFERENCE TIES

---

MAP SHOWING DISTANCE AND DIRECTION TO OTHER PUBLIC LAND SURVEY CORNERS USED FOR REESTABLISHING THE CORNER

(not to scale)


Grid bearings and distances

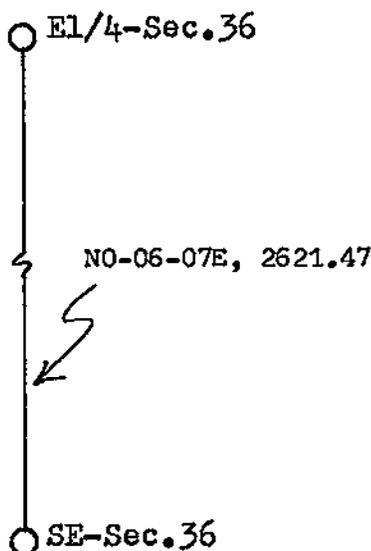

I, William C. Jung, Deputy County Surveyor,  
HEREBY CERTIFY THAT THE CORNER LOCATION SHOWN ON THIS RECORD  
WAS DETERMINED BY ME OR UNDER MY DIRECTION AND CONTROL AND  
THAT THIS U. S. PUBLIC LAND SURVEY MONUMENT RECORD IS CORRECT  
AND COMPLETE TO THE BEST OF MY KNOWLEDGE AND BELIEF.

William C. Jung  
Signature

6/11/86  
Date

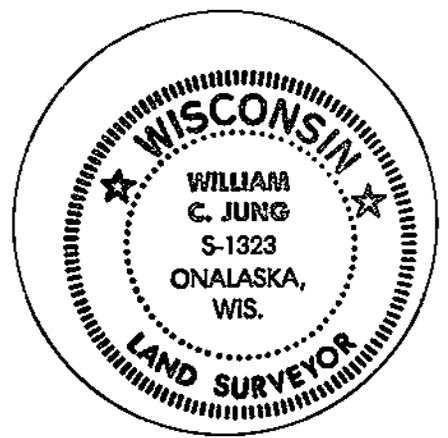

Seal