


U. S. PUBLIC LAND SURVEY MONUMENT RECORD

SECTION 36 T 18 N, R 8 W, TOWN OF HOLLAND
 LA CROSSE COUNTY

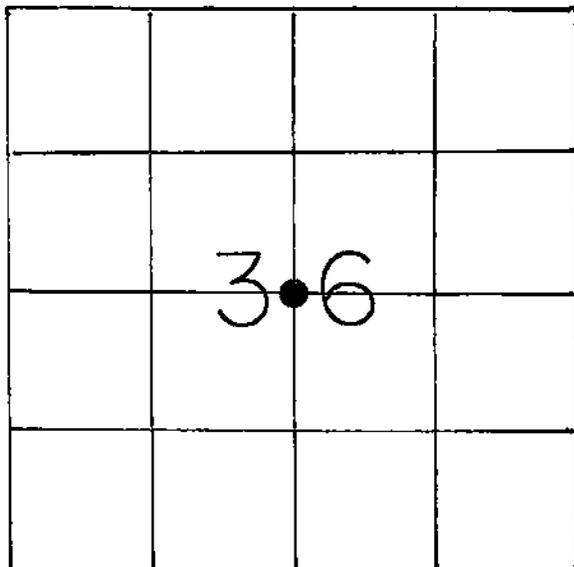

LOCATION OF LANDMARK

Crew: William Jung
 Perry Dahl
 6/2/86

South Zone

WISCONSIN COORDINATE SYSTEM	
North	728,525.836
East	1,663,028.422
Theta Angle	
Horiz. Order	
Vert. Order	
TYPE OF LANDMARK	
Witness markers set East&West of corner	
BEARINGS ARE REFERENCED TO	
Grid North	

Describe any record evidence, monument evidence, testimonial evidence or any other material evidence you considered and whether the monument was found or restored through acceptance of an obliterated evidence location.

The corner is at a computed location at the intersection of the 1/4 lines as "per law". I did not actually set the corner in the highway but did set witness markers. Traffic on this highway is always very busy.
 (This location does not fit the fence going to the East but falls about 5 feet North of it.)

Describe or show any material discrepancy between the location of the restored corner and that of the corner previously restored or reestablished.

In 1978 Clayton Solberg shows the corner as being in the road centerline.

