

21908 330000

# TREMPEALEAU COUNTY

## U.S. PUBLIC LAND SURVEY MONUMENT RECORD

SECTION Corner common to Sections 3, 4, 33 & 34

T. 18 & 19 N., R. 8 W.

Type of monument 7/8" X30" REBAR WITH ALUMINUM CAP

Location indicated on sketch - ⊕ -

33	34
T18N	T19N
4	3

Location Sketch

Describe any record evidence, monument evidence, occupational evidence, testimonial evidence or any other material evidence you considered, and whether the monument was found or placed.

ORIGINAL GOVERNMENT ACCESSORIES WERE SEARCHED FOR, BUT NOTHING WAS FOUND. OTHER MONUMENT EVIDENCE WAS SEARCHED FOR AND AN ALUMINUM CAPPED REBAR WAS FOUND. ALSO FOUND THREE 1" IRON PIPE REFERENCE MONUMENTS. NO RECORD EVIDENCE OF THIS REBAR WAS FOUND. FOUND REBAR IS BELIEVED TO HAVE BEEN SET BY S. SOLBERG IN CONJUNCTION WITH HIS 1987 SURVEY. BASED ON INFORMATION ON S. SOLBERG SURVEY MAP, IT APPEARS AS THOUGH THE INTENT WAS TO SET THIS REBAR AT A COMPUTED POSITION, AS INDICATED IN MISCELLANEOUS SURVEY NOTES ON FILE AT THE COUNTY SURVEYOR'S OFFICE. THIS REBAR WAS FOUND TO BE NORTHEASTERLY 7.09 FEET FROM SAID COMPUTED POSITION. IT APPEARS THAT S. SOLBERG CONTROL SURVEY MAY NOT HAVE BEEN ADEQUATE ENOUGH TO SET THIS CORNER POSITION WITHIN THE REQUIRED TOLERANCES. A POSITION FOR THIS CORNER WAS RESTORED BASED ON SAID COMPUTED POSITION. THIS INFORMATION MATCHES MEASUREMENT INFORMATION AS INDICATED IN MISCELLANEOUS SURVEY NOTES VERY WELL. THIS POSITION MATCHES ORIGINAL GOVERNMENT DISTANCE TO OCCUPATION AT THE EAST QUARTER CORNER OF SECTION 33-19-8 BY ABOUT 4 FEET. THEREFORE BELIEVING THE POSITION OF FOUND REBAR TO NOT BE WITHIN REQUIRED MEASUREMENT TOLERANCES AND BELIEVING THE COMPUTED POSITION, AS DESCRIBED, TO BE THE BEST AVAILABLE EVIDENCE OF THIS CORNER'S ORIGINAL LOCATION, A 7/8" X30" REBAR WITH AN ALUMINUM CAP WAS SET AND REFERENCED AS SHOWN BELOW.


Show a plan view drawing depicting the relevant monuments, providing reference ties to at least 4 witness monuments. Describe witness monuments. Show relationship to occupation.

- SET 5/8" X24" REBAR WITH PLASTIC CAP
- FOUND 1" IRON PIPE

SURVEY SIGN POST  
1' SOUTH OF MON.



no scale

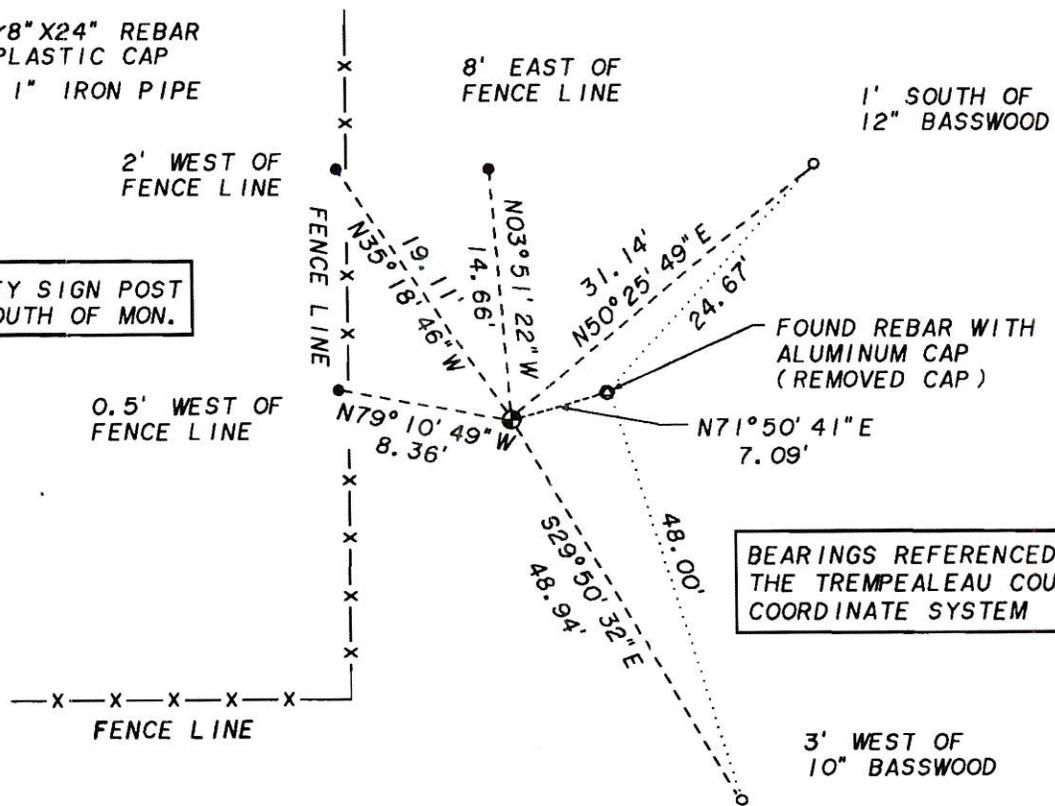

Corner identifier number 21908 330000  
72-238

