

TREMPEALEAU COUNTY

U.S. PUBLIC LAND SURVEY MONUMENT RECORD

SECTION Corner common to Sections 2, 3, 34 & 35
 T. 18 & 19 N., R. 8 W.
 Type of monument 7/8" X 30" REBAR WITH ALUMINUM CAP
 Location indicated on sketch -  -


34 T18N 3	35 T19N 2
-----------------	-----------------

Location Sketch

Describe any record evidence, monument evidence, occupational evidence, testimonial evidence or any other material evidence you considered, and whether the monument was found or placed.

ORIGINAL GOVERNMENT ACCESSORIES FOR BOTH THE 1845 AND THE 1847 SURVEYS WERE SEARCHED FOR, BUT NOTHING WAS FOUND. OTHER MONUMENT EVIDENCE WAS SEARCHED FOR, AND A 1" IRON PIPE WAS FOUND AT THE INTERSECTION OF A SHORT FENCE LINE EAST AND A FENCE LINE SOUTH. NO RECORD EVIDENCE OF THIS IRON PIPE WAS FOUND. MISCELLANEOUS SURVEY NOTES, ON FILE AT THE COUNTY SURVEYOR'S OFFICE, INDICATE A COORDINATE POSITION FOR THIS CORNER. THIS POSITION WAS RESTORED. THIS POSITION FALLS APPROXIMATELY AT THE INTERSECTION OF A SHORT FENCE LINE NORTH AND A SHORT FENCE LINE WEST. A NORTH/SOUTH LINE OF, VERTICALLY PLACED, OLD CAR FRAMES WAS FOUND APPROXIMATELY 4 FEET EAST OF THIS POSITION. THE FOUND IRON PIPE IS LOCATED WESTERLY, APPROXIMATELY 32 FEET FROM THIS POSITION. IT APPEARS AS THOUGH THE IRON PIPE MAY HAVE BEEN SET AS SURVEY CONTROL ONLY, PRIOR TO THE FINAL DETERMINATION OF THIS CORNER LOCATION. THIS POSITION MATCHES THE SPLIT OF DISTANCE BETWEEN THE NORTH QUARTER CORNER OF SECTION 3-18-8 AND THE NORTH QUARTER CORNER OF SECTION 2-18-8 BY ABOUT 3 FEET. IT MATCHES ORIGINAL GOVERNMENT DISTANCE TO THE EAST QUARTER CORNER OF SECTION 3-18-8 BY LESS THAN 4 FEET. SURVEYS FILED IN BOTH LA CROSSE COUNTY AND TREMPEALEAU COUNTY INDICATE UTILIZING CORNER POSITIONS THAT ARE DEPENDENT ON THIS POSITION. THEREFORE, BELIEVING THIS POSITION, AS DESCRIBED, TO BE THE BEST AVAILABLE EVIDENCE OF THIS CORNER'S ORIGINAL LOCATION, A 7/8" X 30" REBAR WITH AN ALUMINUM CAP WAS SET AND REFERENCED AS SHOWN BELOW.

Show a plan view drawing depicting the relevant monuments, providing reference ties to at least 4 witness monuments. Describe witness monuments. Show relationship to occupation.

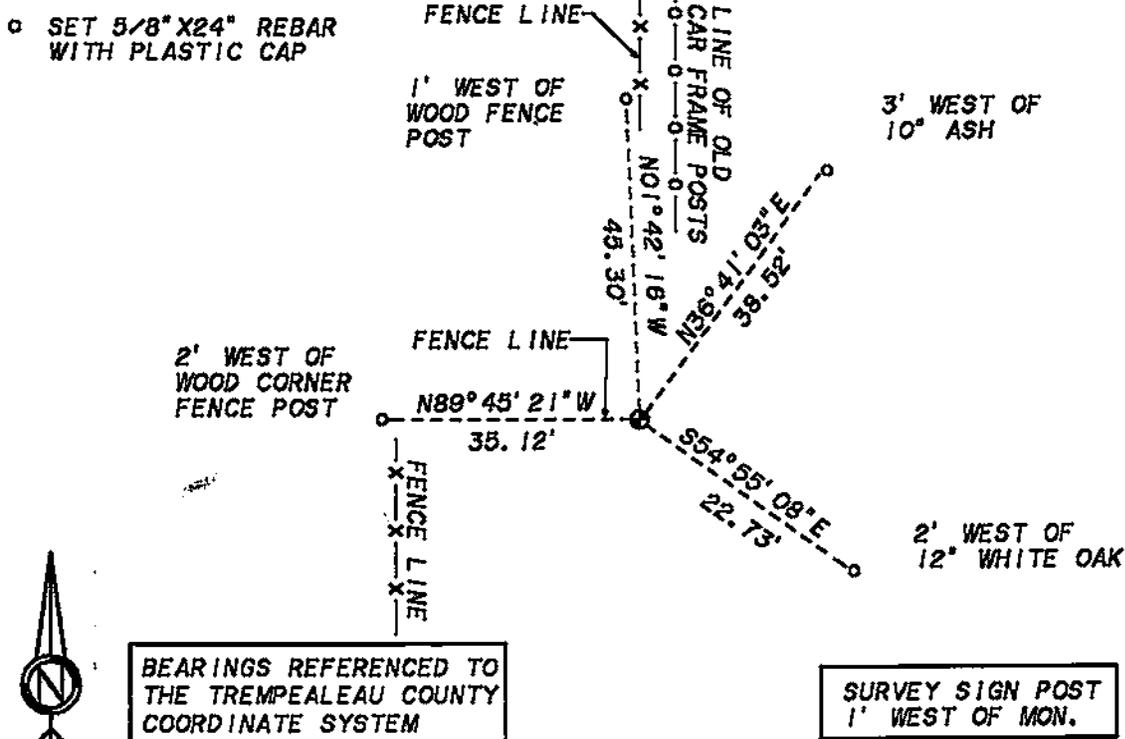

BEARINGS REFERENCED TO THE TREMPEALEAU COUNTY COORDINATE SYSTEM

SURVEY SIGN POST
1' WEST OF MON.

Corner Identifier number 64-288

Describe any material discrepancy between the location of the corner as restored or reestablished and the location of that corner as previously restored or reestablished by distance and direction. Show the discrepancy on the plan view drawing. Show the distances between the corner as restored or reestablished, and (1) the corner as restored or reestablished, and (2) to at least 2 of the witness monuments shown on the drawing.

NO RECORD MONUMENT DISCREPANCY WAS FOUND. A 1" IRON PIPE WAS FOUND APPROXIMATELY 32 FEET WESTERLY, AT THE INTERSECTION OF FENCE LINES EAST AND SOUTH, OF THIS RESTORED POSITION.

Was the corner restored through acceptance of (1) an obliterated evidence location, (2) a found perpetuated location, or (3) an existent corner location?

AN OBLITERATED EVIDENCE LOCATION.

Was the corner reestablished through lost corner proportionate methods? If so, show the method including the directions and distances to other public land survey corners used as evidence or used for proportioning in determining the corner location.

NO.

Show the corner history of record in chronological order from Original Government Survey to present.

**ORIGINAL GOVERNMENT SURVEY - J.E. FREEMAN - NOVEMBER 1845
SET POST TO SECTION CORNER. MARKED TWO BEARING TREES.**

**ORIGINAL GOVERNMENT SURVEY - CYRUS WOODWORTH - SEPTEMBER 1847
NORTH RANDOM BETWEEN SECTIONS 283. INTERSECTED 65 LINKS WEST OF POST.
MARKED TWO ADDITIONAL BEARING TREES.**

**MISC. SURVEY NOTES - COUNTY SURVEYOR'S OFFICE - DATE?
SHOWS COORDINATE VALUES FOR VARIOUS LOCATIONS IN THE SECTION 3-10-8 AREA.**

I, JOSEPH P. NELSEN
certify that the corner location shown on this record was determined by me or under my direction and control and that this U.S. Public Land Survey Monument Record is correct to the best of my knowledge and belief.

Joseph P. Nelsen 10-7-99
Signature Date

Affix Land Surveyor Seal

