

21908340020

TREMPEALEAU COUNTY

U.S. PUBLIC LAND SURVEY MONUMENT RECORD

QUARTER Corner common to Sections 3 8 34

T. 18 8 19 N., R. 8 W.

Type of monument ALUMINUM CAPPED MONUMENT

Location indicated on sketch - \odot -

34	34
T18N	T19N
3	3


Location Sketch

Describe any record evidence, monument evidence, occupational evidence, testimonial evidence or any other material evidence you considered, and whether the monument was found or placed.

ORIGINAL GOVERNMENT ACCESSORIES WERE SEARCHED FOR, BUT NOTHING WAS FOUND. OTHER MONUMENT EVIDENCE WAS SEARCHED FOR AND AN ALUMINUM CAPPED MONUMENT WAS FOUND. FOUND MONUMENT MATCHES THE CALCULATED POSITION INDICATED IN MISCELLANEOUS SURVEY NOTES, ON FILE AT THE COUNTY SURVEYOR'S OFFICE. ACCORDING TO SAID MISCELLANEOUS SURVEY NOTES, THIS POSITION WAS REESTABLISHED BY SINGLE PROPORTIONATE MEASUREMENT BETWEEN THE NORTHWEST AND NORTHEAST CORNERS OF SECTION 3-18-8. THIS POSITION SEEMS TO MATCH THE POSITION INDICATED ON 1994 SURVEY BY T. KERWIN. THEREFORE BELIEVING FOUND MONUMENT, AS DESCRIBED, TO BE THE BEST AVAILABLE EVIDENCE OF THIS CORNER'S ORIGINAL LOCATION, IT WAS LEFT IN PLACE AND REFERENCED AS SHOWN BELOW.

Show a plan view drawing depicting the relevant monuments, providing reference ties to at least 4 witness monuments. Describe witness monuments. Show relationship to occupation.

- o SET 5/8" X24" REBAR WITH PLASTIC CAP

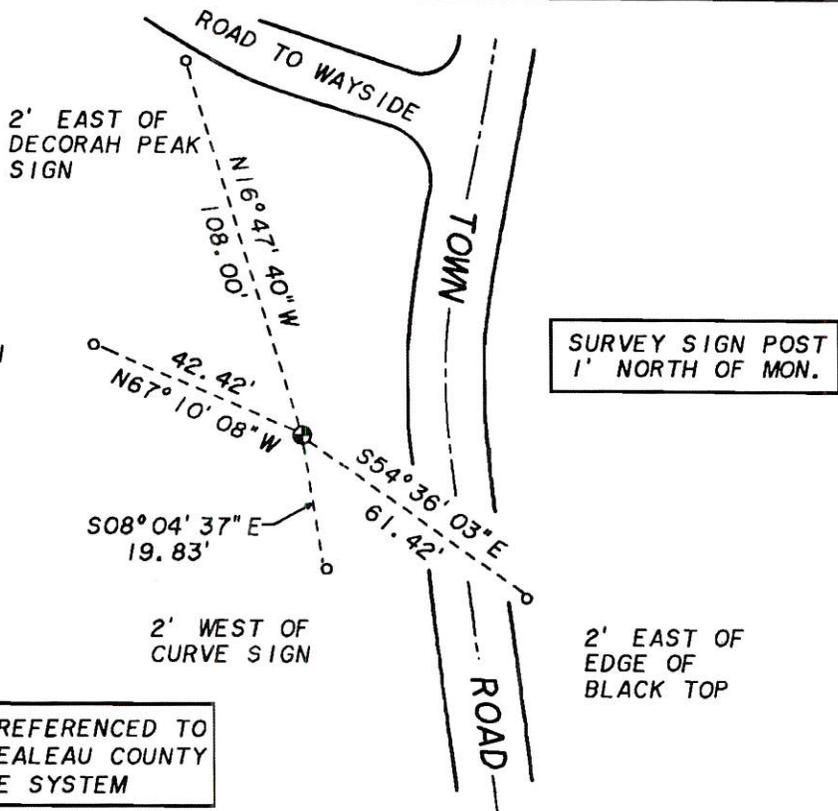

BEARINGS REFERENCED TO THE TREMPEALEAU COUNTY COORDINATE SYSTEM

no scale

Corner identifier number

21908340020

Describe any material discrepancy between the location of the corner as restored or reestablished and the location of that corner as previously restored or reestablished by distance and direction. Show the discrepancy on the plan view drawing. Show the distances between the corner as restored or reestablished, and (1) the corner as restored or reestablished, and (2) to at least 2 of the witness monuments shown on the drawing.

NO ACTUAL MONUMENT DISCREPANCY WAS FOUND, ALTHOUGH THIS FOUND POSITION MAY NOT REFLECT THE EXACT POSITION REQUIRED FOR P. SMITH AND R. CHALSMA SURVEYS IN SECTION 3-18-8.

Was the corner restored through acceptance of (1) an obliterated evidence location, (2) a found perpetuated location, or (3) an existent corner location?

A FOUND PERPETUATED LOCATION.

Was the corner reestablished through lost corner proportionate methods? If so, show the method including the directions and distances to other public land survey corners used as evidence or used for proportioning in determining the corner location.

NO.

Show the corner history of record in chronological order from Original Government Survey to present.

**ORIGINAL GOVERNMENT SURVEY - J.E. FREEMAN - NOVEMBER 1845
SET POST QUARTER SECTION CORNER. MARKED TWO BEARING TREES.**

**MISC. SURVEY NOTES - COUNTY SURVEYOR'S OFFICE - DATE ?
SHOWS COORDINATE VALUES FOR VARIOUS CORNER LOCATIONS IN SECTION 3-18-8.**

**PRIVATE LAND SURVEYOR'S RECORDS - P. SMITH - AUGUST 1976
SURVEYS PARCEL IN SECTION 3-18-8. SHOWS THE LOCATION OF THE CENTER OF SECTION 3. NO MENTION OF HOW THE CENTER WAS ESTABLISHED.**

**PRIVATE LAND SURVEYOR'S RECORDS - P. SMITH - OCTOBER 1977
SURVEYS PARCEL IN SECTION 3-18-8. SHOWS THE LOCATION OF THE NORTHEAST CORNER OF THE NORTHWEST 1/4 OF THE SOUTHWEST 1/4 OF SECTION 3. SHOWS A FOUND IRON PIPE.**

**PRIVATE LAND SURVEYOR'S RECORDS - R. CHALSMA - MAY 1985
SURVEYS PARCEL IN SECTION 3-18-8. SHOWS AN IRON PIPE FOUND AT THE CENTER OF SECTION 3-18-8.**

**PRIVATE LAND SURVEYOR'S RECORDS - T. KERWIN - MAY 1995
SURVEYS A PARCEL IN SECTION 3-18-8. SHOWS A POSITION OF THE NORTH QUARTER CORNER OF SECTION 3. NOTES THAT IT WAS CALCULATED FROM COUNTY SURVEYOR NOTES. NO MENTION OF WHAT WAS SET, IF ANYTHING.**

I, JOSEPH P. NELSEN
certify that the corner location shown on this record was determined by me or under my direction and control and that this U.S. Public Land Survey Monument Record is correct to the best of my knowledge and belief.

Joseph P. Nelsen 1-18-2000
Signature Date

Affix Land Surveyor Seal

