

# TREMPEALEAU COUNTY

## U.S. PUBLIC LAND SURVEY MONUMENT RECORD

QUARTER Corner common to Sections 2 & 35  
 T. 18 & 19 N., R. 8 W.  
 Type of monument 7/8" X30" REBAR WITH ALUMINUM CAP  
 Location indicated on sketch - ⊕ -

35	35
T18N	T19N
2	2


Location Sketch

Describe any record evidence, monument evidence, occupational evidence, testimonial evidence or any other material evidence you considered, and whether the monument was found or placed.

ORIGINAL GOVERNMENT ACCESSORIES WERE SEARCHED FOR, BUT NOTHING WAS FOUND. OTHER MONUMENT EVIDENCE WAS SEARCHED FOR, AND TWO 1" DIAMETER IRON PIPES WERE FOUND. MISCELLANEOUS SURVEY NOTES, ON FILE AT THE COUNTY SURVEYOR'S OFFICE INDICATE A COORDINATE POSITION FOR THIS CORNER. THIS IS THE ONLY SUBSEQUENT RECORD EVIDENCE OF THIS CORNER'S LOCATION. ONE OF THE TWO IRON PIPES MATCHES THIS COORDINATE POSITION. THE OTHER IRON PIPE WAS FOUND S34°20' W, 1.77 FEET FROM THE RESTORED CORNER. THIS RESTORED CORNER LOCATION WAS FOUND APPROXIMATELY ON A CROOKED, EAST/WEST, FENCE LINE TO THE WEST. THIS POSITION MATCHES THE SINGLE PROPORTIONATE POSITION BETWEEN THE NORTHWEST AND NORTHEAST CORNERS OF SECTION 2-18-8 BY LESS THAN 2 FEET NORTH/SOUTH AND BY LESS THAN 7 FEET EAST/WEST. THEREFORE, BELIEVING THIS POSITION, AS DESCRIBED, TO BE THE BEST AVAILABLE EVIDENCE OF THIS CORNER'S ORIGINAL LOCATION, A 7/8" X30" REBAR WITH AN ALUMINUM CAP WAS SET IN PLACE OF FOUND IRON PIPE AND REFERENCED AS SHOWN BELOW.

Show a plan view drawing depicting the relevant monuments, providing reference ties to at least 4 witness monuments. Describe witness monuments. Show relationship to occupation.

○ SET 5/8" X24" REBAR WITH PLASTIC CAP

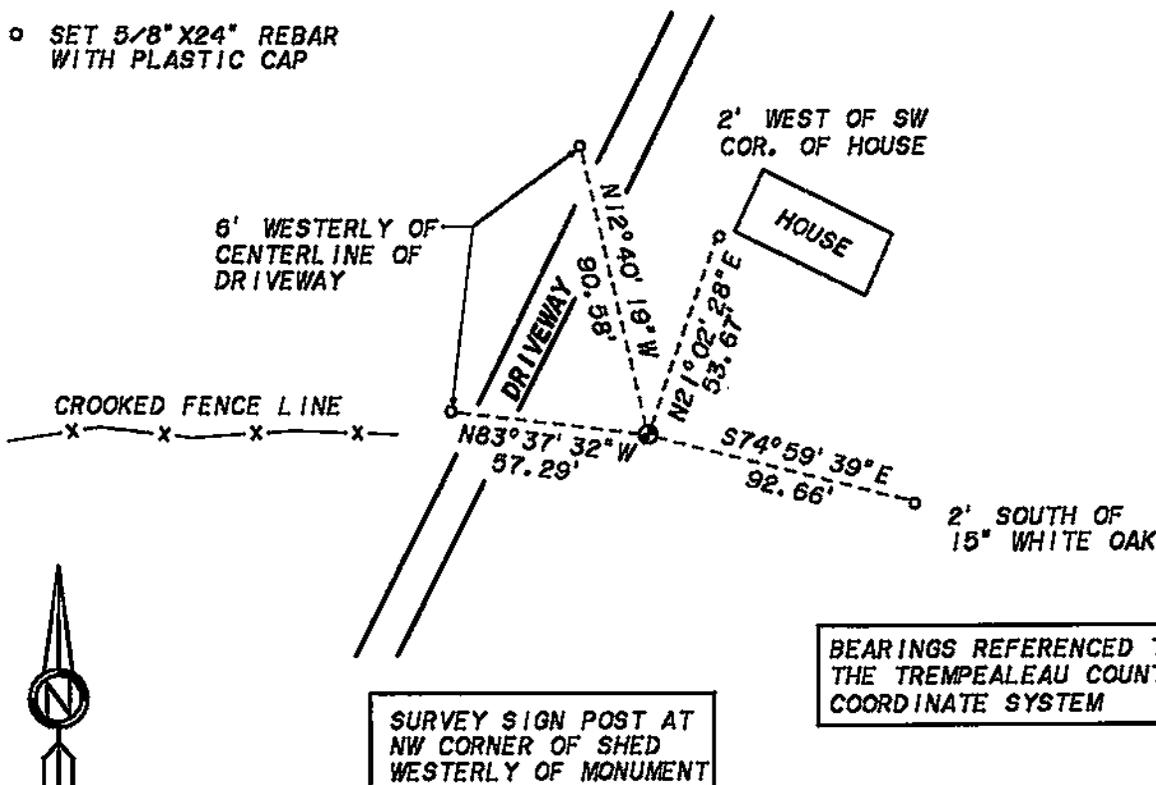

Corner Identifier number 60-288



no scale

BEARINGS REFERENCED TO THE TREMPEALEAU COUNTY COORDINATE SYSTEM

SURVEY SIGN POST AT NW CORNER OF SHED WESTERLY OF MONUMENT

Describe any material discrepancy between the location of the corner as restored or reestablished and the location of that corner as previously restored or reestablished by distance and direction. Show the discrepancy on the plan view drawing. Show the distances between the corner as restored or reestablished, and (1) the corner as restored or reestablished, and (2) to at least 2 of the witness monuments shown on the drawing.

**NO MATERIAL DISCREPANCY OF RECORD WAS FOUND, ALTHOUGH A 1" IRON PIPE WAS FOUND S34°20' E, 1.77 FEET FROM RESTORED CORNER.**

Was the corner restored through acceptance of (1) an obliterated evidence location, (2) a found perpetuated location, or (3) an existent corner location?

**A FOUND PERPETUATED LOCATION.**

Was the corner reestablished through lost corner proportionate methods? If so, show the method including the directions and distances to other public land survey corners used as evidence or used for proportioning in determining the corner location.

**NO.**

Show the corner history of record in chronological order from Original Government Survey to present.

**ORIGINAL GOVERNMENT SURVEY - J.E. FREEMAN - NOVEMBER 1845  
SET POST FOR QUARTER SECTION CORNER. MARKED TWO BEARING TREES.**

**MISC. SURVEY NOTES - COUNTY SURVEYOR'S OFFICE - DATE?  
SHOWS COORDINATE VALUES FOR VARIOUS LOCATIONS IN SECTION 2-18-8 AREA.**

I, JOSEPH P. NELSEN  
certify that the corner location shown on this record was determined by me or under my direction and control and that this U.S. Public Land Survey Monument Record is correct to the best of my knowledge and belief.

Joseph P. Nelsen 10-18-99  
Signature Date

Affix Land Surveyor Seal

