

21908360000

TREMPEALEAU COUNTY

U.S. PUBLIC LAND SURVEY MONUMENT RECORD

SECTION Corner common to Sections 1, 6, 31 & 36
 T. 18 & 19 N., R. 7 & 8 W.
 Type of monument ALUMINUM CAPPED REBAR
 Location indicated on sketch -  -

36	31
T18N	T19N
1	6

Location Sketch


Describe any record evidence, monument evidence, occupational evidence, testimonial evidence or any other material evidence you considered, and whether the monument was found or placed.

ORIGINAL GOVERNMENT ACCESSORIES WERE SEARCHED FOR, BUT NOTHING WAS FOUND. OTHER MONUMENT EVIDENCE WAS SEARCHED FOR, AND AN ALUMINUM CAPPED REBAR, AS CALLED FOR BY N. HURLBURT WAS FOUND. ALSO FOUND FOUR REFERENCE MONUMENTS CALLED FOR BY N. HURLBURT. NO OTHER CORNER EVIDENCE WAS FOUND. FOUND MONUMENT MATCHES THE MATHEMATICAL POSITION INDICATED BY N. HURLBURT VERY WELL. THIS POSITION WAS DETERMINED BY HOLDING ORIGINAL GOVERNMENT DISTANCE (AS INDICATED IN THE TOWNSHIP SUBDIVISION) FROM THE SOUTHWEST CORNER OF SECTION 36-19-8 AND BY HOLDING THE ORIGINAL GOVERNMENT DISTANCE FROM THE SOUTHWEST CORNER OF SECTION 6-18-7. THIS POSITION MATCHES ORIGINAL GOVERNMENT DISTANCE TO OCCUPATION AT THE NORTHWEST CORNER OF SECTION 31-19-7 BY LESS THAN 1 FOOT. IT MATCHES THE PROJECTION OF NORTH/SOUTH OCCUPATION AT THE NORTHWEST AND WEST QUARTER CORNERS OF SECTION 31-19-7 BY ABOUT 7 FEET. IT ALSO MATCHES THE PROJECTION OF NORTH/SOUTH OCCUPATION AT THE SOUTHWEST AND WEST QUARTER CORNERS OF SECTION 6-18-7 BY LESS THAN 4 FEET. THEREFORE, BELIEVING FOUND MONUMENT, AS DESCRIBED, TO BE THE BEST AVAILABLE EVIDENCE OF THIS CORNER'S ORIGINAL LOCATION, IT WAS LEFT IN PLACE AND REFERENCED AS SHOWN BELOW.

Show a plan view drawing depicting the relevant monuments, providing reference ties to at least 4 witness monuments. Describe witness monuments. Show relationship to occupation.

- FOUND 1" IRON PIPE WITH PLASTIC CAP

SURVEY SIGN POST
7' WEST OF MON.

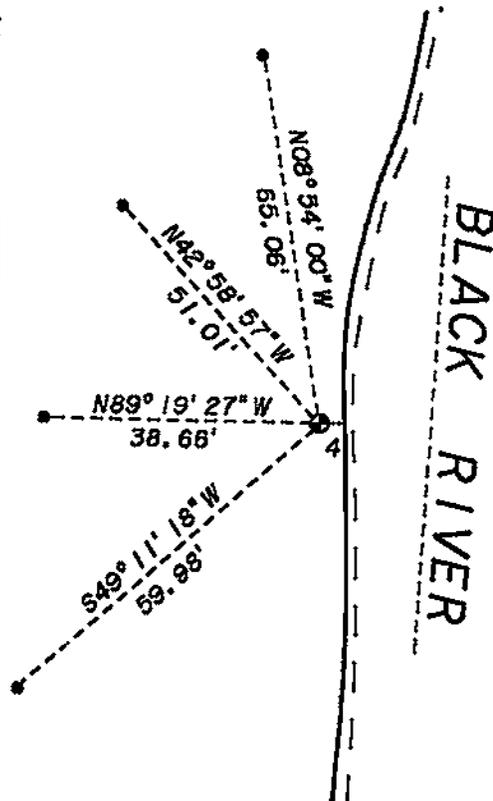

NOTE: BEARINGS AND DISTANCES AS SHOWN ON N. HURLBURT RECORD FORM WERE UTILIZED FOR THE SHOWN REFERENCE MONUMENTS. BEARINGS WERE ROTATED TO REFLECT THE TREMPEALEAU COUNTY COORDINATE SYSTEM.

BEARINGS REFERENCED TO THE TREMPEALEAU COUNTY COORDINATE SYSTEM



no scale

Corner identifier number 48-288

