

21908360020

TREMPEALEAU COUNTY

U.S. PUBLIC LAND SURVEY MONUMENT RECORD

QUARTER Corner common to Sections 1 & 36

T. 18 & 19 N., R. 8 W.

Type of monument 7/8" X30" REBAR WITH ALUMINUM CAP

Location indicated on sketch - -

36	36
T18N	T19N
1	1

Location Sketch

Describe any record evidence, monument evidence, occupational evidence, testimonial evidence or any other material evidence you considered, and whether the monument was found or placed.

ORIGINAL GOVERNMENT ACCESSORIES WERE SEARCHED FOR, BUT NOTHING WAS FOUND. OTHER MONUMENT EVIDENCE WAS SEARCHED FOR, AND A 5"X8"X11" STONE MONUMENT WAS FOUND, IN THE VERTICAL POSITION, APPROXIMATELY 8" BELOW THE GROUND SURFACE. IT APPEARS AS THOUGH THE TOP PORTION OF THE STONE MAY HAVE BEEN BROKEN OFF. DISTURBED TOP SOIL WAS FOUND UNDER THE STONE, INDICATING THE STONE WAS PLACED AT THE LOCATION. THIS STONE WAS THE ONLY STONE FOUND IN THIS GENERAL AREA. STONE WAS FOUND APPROXIMATELY ON THE FENCE LINE TO THE NORTH AND APPROXIMATELY 1-FOOT SOUTH OF THE FENCE LINE TO THE EAST. FOUND STONE MATCHES ORIGINAL GOVERNMENT DISTANCE TO THE NORTHWEST CORNER OF SECTION 1-18-8 BY LESS THAN 3 FEET. THEREFORE, BELIEVING FOUND STONE, AS DESCRIBED, TO BE THE BEST AVAILABLE EVIDENCE OF THIS CORNER'S ORIGINAL LOCATION, A 7/8" X30" REBAR WITH AN ALUMINUM CAP WAS SET IN PLACE OF FOUND STONE, APPROXIMATELY 16" BELOW THE SURFACE, AND REFERENCED AS SHOWN BELOW.


Show a plan view drawing depicting the relevant monuments, providing reference ties to at least 4 witness monuments. Describe witness monuments. Show relationship to occupation.

o SET 5/8" X24" REBAR WITH PLASTIC CAP

1' WEST OF STEEL FENCE POST

20" BELOW SURFACE IN CULTIVATION-ON PROJECTION OF FENCE LINE FROM EAST NO CAP

BEARINGS REFERENCED TO THE TREMPEALEAU COUNTY COORDINATE SYSTEM

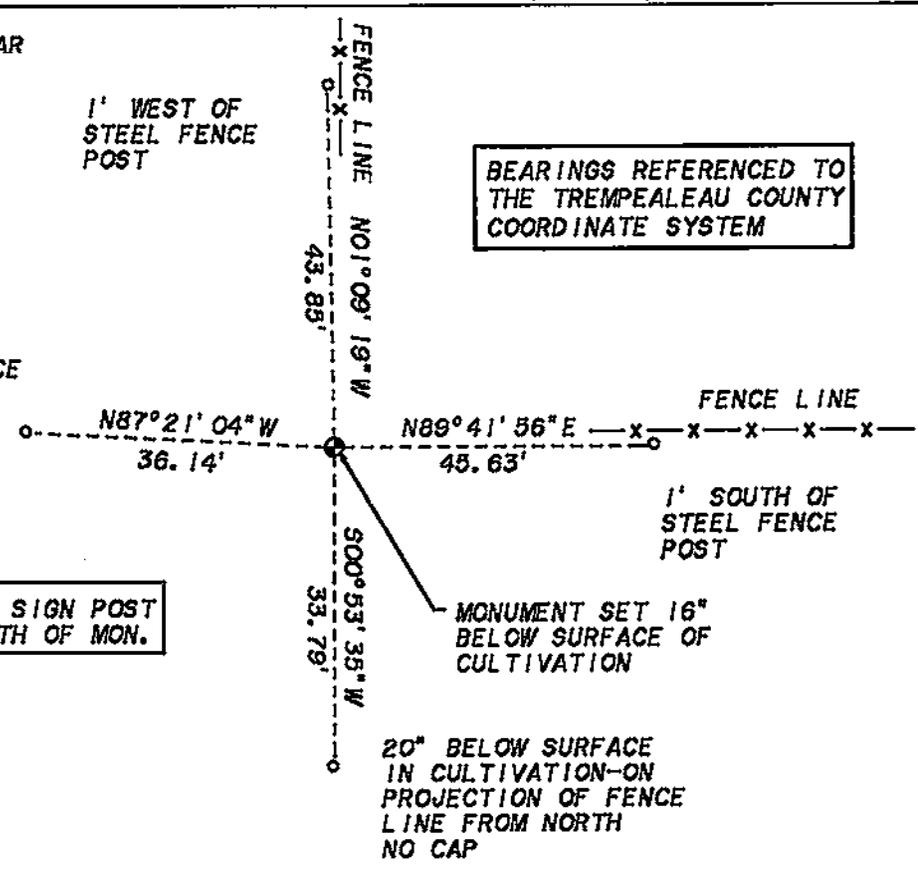

SURVEY SIGN POST
1' NORTH OF MON.



no scale

Corner Identifier number 52-288

