

21907250000

# TREMPEALEAU COUNTY


## U.S. PUBLIC LAND SURVEY MONUMENT RECORD

SECTION Corner common to Sections 25, 30, 31 & 36

T. 19 N., R. 6 & 7 W.

Type of monument 7/8" X 30" REBAR WITH ALUMINUM CAP

Location indicated on sketch - ⊕ -

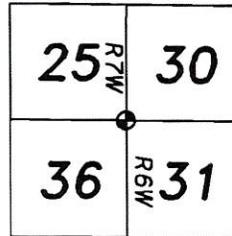

Location Sketch

Describe any record evidence, monument evidence, occupational evidence, testimonial evidence or any other material evidence you considered, and whether the monument was found or placed.


ORIGINAL GOVERNMENT ACCESSORIES WERE SEARCHED FOR, BUT NONE WERE FOUND. OTHER MONUMENT EVIDENCE WAS SEARCHED FOR, BUT NONE WAS FOUND. THE EAST/WEST POSITION OF THIS CORNER WAS RESTORED BY HOLDING OCCUPATIONAL EVIDENCE, CONSISTING OF A NORTH/SOUTH FENCE LINE. THE NORTH/SOUTH POSITION OF THIS CORNER WAS REESTABLISHED BY HOLDING THE PROPORTIONAL SPLIT OF DISTANCE BETWEEN THE NORTHEAST CORNER OF SECTION 25-19-7 AND THE SOUTHEAST CORNER OF SECTION 36-19-7. THIS POSITION IS LOCATED IN THE BOTTOM OF A SMALL RAVINE. THE SMALL RAVINE MAY EXPLAIN THE LACK OF CORNER EVIDENCE. THIS POSITION MATCHES OCCUPATION NEAR THE 1/16TH CORNER TO THE WEST BY ABOUT 4 FEET EAST/WEST AND BY LESS THAN 4 FEET NORTH/SOUTH. IT ALSO MATCHES PROPORTIONALLY WITH ORIGINAL GOVERNMENT DISTANCE TO THE SOUTH BANK OF THE BLACK RIVER BY ABOUT 1 FOOT. THEREFORE, BELIEVING THIS POSITION, AS DESCRIBED, TO BE THE BEST AVAILABLE EVIDENCE OF THE LOCATION OF THE ORIGINAL GOVERNMENT CORNER, A MONUMENT WAS SET AND REFERENCED AS SHOWN BELOW.

Show a plan view drawing depicting the relevant monuments, providing reference ties to at least 4 witness monuments. Describe witness monuments. Show relationship to occupation.

- SET 5/8" X 24" REBAR WITH PLASTIC CAP

SURVEY SIGN POST  
6' NORTH OF MON.

BEARINGS REFERENCED TO  
THE TREMPEALEAU COUNTY  
COORDINATE SYSTEM

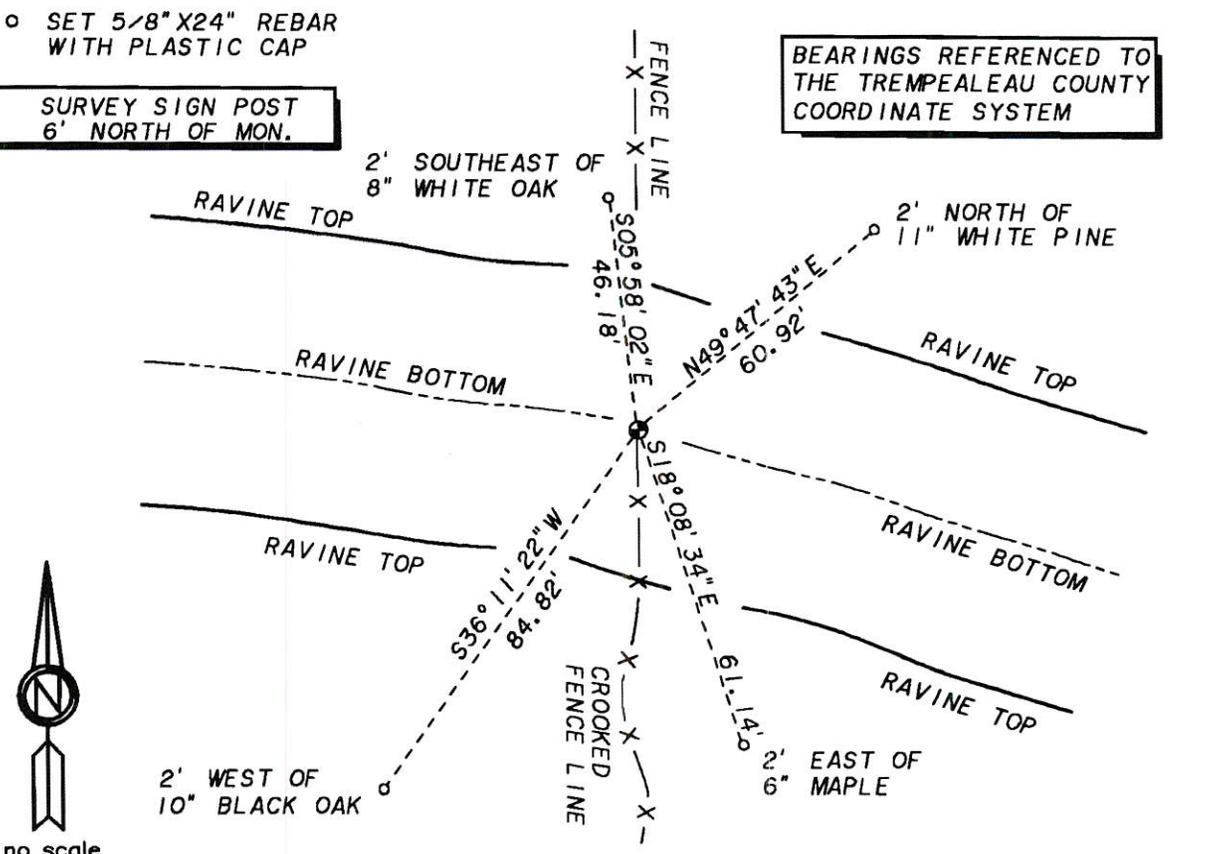

Corner identifier number

21907250000  
00-280

Describe any material discrepancy between the location of the corner as restored or reestablished and the location of that corner as previously restored or reestablished by distance and direction. Show the discrepancy on the plan view drawing. Show the distances between the corner as restored or reestablished, and (1) the corner as restored or reestablished, and (2) to at least 2 of the witness monuments shown on the drawing.

**NO MATERIAL DISCREPANCY WAS FOUND.**

Was the corner restored through acceptance of (1) an obliterated evidence location, (2) a found perpetuated location, or (3) an existent corner location?

**THE EAST/WEST POSITION OF THIS CORNER WAS DETERMINED BY AN OBLITERATED EVIDENCE LOCATION.**

Was the corner reestablished through lost corner proportionate methods? If so, show the method including the directions and distances to other public land survey corners used as evidence or used for proportioning in determining the corner location.

**YES. THE PROPORTIONAL SPLIT OF DISTANCE WAS USED BETWEEN THE NORTHEAST CORNER OF SECTION 25-19-7 AND THE SOUTHEAST CORNER OF SECTION 36-19-7.  
NE COR. SEC. 25 TO EAST QUARTER COR. SEC. 25 = S00°25'44"E, 2624.90 FEET  
EAST QUARTER COR. SEC. 25 TO NE COR. SEC. 36 = S00°01'24"W, 2624.90 FEET  
NE COR. SEC. 36 TO SE COR. SEC. 36 = S00°34'05"E, 5249.78 FEET  
(BEARINGS REFERENCED TO THE TREMPLEAU COUNTY COORDINATE SYSTEM)**

Show the corner history of record in chronological order from Original Government Survey to present.

**ORIGINAL GOVERNMENT SURVEY - J.E. FREEMAN - DECEMBER 1845  
SET POST FOR SECTION CORNER. MARKED TWO BEARING TREES.**

**ORIGINAL GOVERNMENT SURVEY - J. TURNER - OCTOBER 1847  
SUBDIVIDED T19N R6W. MARKED TWO ADDITIONAL BEARING TREES.**

**JACKSON CO. GOVERNMENT LAND CORNER CERTIFICATE - J. ELLINGSON - OCT. 1988  
FILES TIE SHEET FOR THE WEST QUARTER CORNER OF SECTION 30-19-6.  
INDICATES A NORTH/SOUTH FENCE LINE TO BE ON THE COUNTY LINE NEAR THE  
SOUTHWEST CORNER OF SECTION 30-19-6.**

I, JOSEPH P. NELSEN  
certify that the corner location shown on this record was determined by me or under my direction and control and that this U.S. Public Land Survey Monument Record is correct to the best of my knowledge and belief.

  
Signature

11-7-02  
Date

Affix Land Surveyor Seal

