

21907310000

TREMPEALEAU COUNTY


U.S. PUBLIC LAND SURVEY MONUMENT RECORD

SECTION Corner common to Sections 5, 6, 31 & 32

T. 18 & 19 N., R. 7 W.

Type of monument ALUMINUM CAPPED REBAR

Location indicated on sketch - ⊕ -

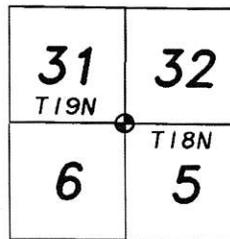

Location Sketch


Describe any record evidence, monument evidence, occupational evidence, testimonial evidence or any other material evidence you considered, and whether the monument was found or placed.

ORIGINAL GOVERNMENT ACCESSORIES WERE SEARCHED FOR, BUT NONE WERE FOUND. A. ARNOLD 1904 BEARING TREES WERE SEARCHED FOR, BUT ALSO NOT FOUND. OTHER MONUMENT EVIDENCE WAS SEARCHED FOR AND AN ALUMINUM CAPPED MONUMENT, AS CALLED FOR BY N. HURLBURT IN 1989, WAS FOUND APPROXIMATELY ON A REMNANT EAST/WEST FENCE LINE. THIS POSITION WAS DETERMINED, BY N. HURLBURT, BY INTERSECTING THE ORIGINAL GOVERNMENT DISTANCES FROM THE SOUTHWEST AND EAST QUARTER CORNERS OF SECTION 31-19-7. N. HURLBURT STATES THAT A STONE WAS FOUND, SIMILAR TO THE STONE FOUND AT THE EAST QUARTER CORNER OF SECTION 31-19-7, LYING LOOSE ON THE GROUND, NEAR THIS POSITION. NO OTHER MONUMENT EVIDENCE WAS FOUND. THIS POSITION MATCHES ORIGINAL GOVERNMENT DISTANCE TO THE EAST QUARTER CORNER OF SECTION 31-19-7 BY LESS THAN 1 FOOT. IT MATCHES ORIGINAL GOVERNMENT DISTANCE TO THE NORTH QUARTER CORNER OF SECTION 5-18-7 BY LESS THAN 10 FEET. IT MATCHES ORIGINAL GOVERNMENT DISTANCE TO THE NORTH QUARTER CORNER OF SECTION 6-18-7 BY LESS THAN 1 FOOT. IT MATCHES ORIGINAL GOVERNMENT DISTANCE TO THE EAST QUARTER CORNER OF SECTION 6-18-7 BY LESS THAN 1 FOOT. IT MATCHES THE PROJECTION OF LINE BETWEEN THE NORTHEAST AND EAST QUARTER CORNERS OF SECTION 31-19-7 BY LESS THAN 1 FOOT. IT ALSO MATCHES LINE BETWEEN THE NORTH QUARTER CORNER OF SECTION 6-18-7 AND THE NORTH QUARTER CORNER OF SECTION 5-18-7 BY LESS THAN 7 FEET. THEREFORE, BELIEVING FOUND MONUMENT, AS DESCRIBED, TO BE THE BEST AVAILABLE EVIDENCE OF THE LOCATION OF THE ORIGINAL GOVERNMENT CORNER, IT WAS LEFT IN PLACE AND REFERENCED AS SHOWN BELOW.

Show a plan view drawing depicting the relevant monuments, providing reference ties to at least 4 witness monuments. Describe witness monuments. Show relationship to occupation.

- FOUND 1" O.D. IRON PIPE W/PLASTIC PLUG

SURVEY SIGN POSTS
1' E. & 2' N. OF MON.

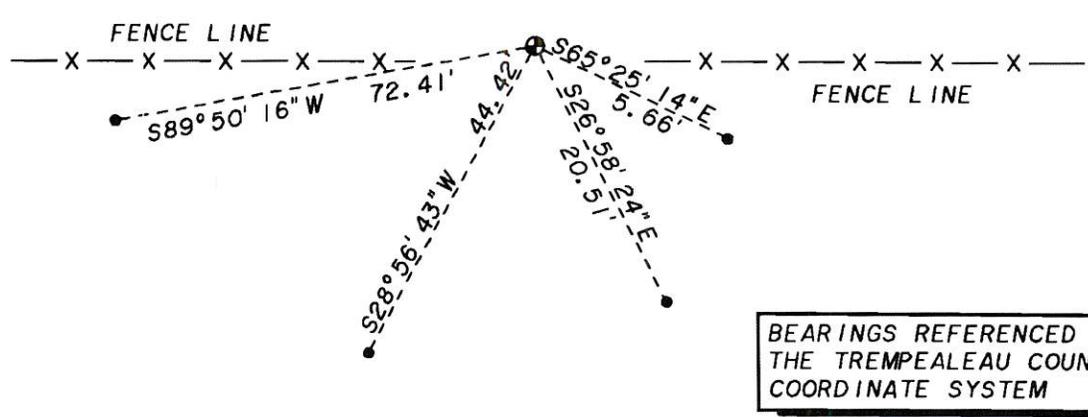

Corner identifier number 21907310000

40-283



no scale

