

21907310020

# TREMPEALEAU COUNTY


## U.S. PUBLIC LAND SURVEY MONUMENT RECORD

QUARTER Corner common to Sections 6 & 31

T. 18 & 19 N., R. 7 W.

Type of monument ALUMINUM CAPPED REBAR

Location indicated on sketch -  $\oplus$  -

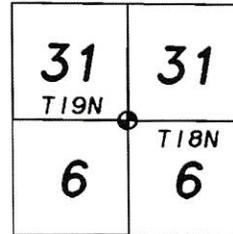

Location Sketch

Describe any record evidence, monument evidence, occupational evidence, testimonial evidence or any other material evidence you considered, and whether the monument was found or placed.


ORIGINAL GOVERNMENT NOTES INDICATE THIS CORNER BEING LOCATED IN THE RIVER. ORIGINAL GOVERNMENT MEANDER CORNERS AND MEANDER CORNER ACCESSORIES WERE SEARCHED FOR, BUT NONE WERE FOUND. N. HURLBURT, IN 1989, DETERMINED A POSITION FOR THIS CORNER. HE INDICATES THAT HE REESTABLISHED IT MID-WAY BETWEEN SECTION CORNERS. IT IS BELIEVED THAT HE INTENDED TO STATE THAT IT WAS REESTABLISHED BY SINGLE PROPORTIONATE MEASUREMENT BETWEEN SECTION CORNERS, AS THIS WOULD BE THE PROPER PROCEDURE FOR THIS CORNER, WHEN CONSIDERED LOST. THREE OF THE FOUR REFERENCE MONUMENTS SET BY N. HURLBURT WERE FOUND. THE MONUMENT POSITION WAS FOUND TO BE CURRENTLY LOCATED IN AN OLD RIVER CHANNEL, INUNDATED BY APPROXIMATELY 3 FEET OF WATER. A POSITION FOR THIS CORNER WAS DETERMINED BY HOLDING THE "BEST FIT" POSITION BASED ON THE TREE FOUND TIES OF RECORD. THIS POSITION MATCHES VERY CLOSELY WITH A SINGLE PROPORTIONATE MEASUREMENT POSITION BETWEEN THE NORTHWEST AND NORTHEAST CORNERS OF SECTION 6-18-7. IT MATCHES ORIGINAL GOVERNMENT DISTANCE TO THE NORTHEAST CORNER OF SECTION 6-19-7 BY LESS THAN 1 FOOT. IT MATCHES ORIGINAL GOVERNMENT DISTANCE TO THE NORTHWEST CORNER OF SECTION 6-18-7 BY LESS THAN 1 FOOT. IT ALSO IS LOCATED IN AN OLD RIVER CHANNEL, AS INDICATED IN THE ORIGINAL GOVERNMENT NOTES. THEREFORE, BELIEVING THIS POSITION, AS DESCRIBED, TO BE THE BEST AVAILABLE EVIDENCE OF THE LOCATION OF THE ORIGINAL GOVERNMENT CORNER, IT WAS LEFT IN PLACE AND REFERENCED AS SHOWN BELOW.

Show a plan view drawing depicting the relevant monuments, providing reference ties to at least 4 witness monuments. Describe witness monuments. Show relationship to occupation.

- FOUND 1" IRON PIPE WITH PLASTIC PLUG

NOTE MONUMENT CURRENTLY LOCATED IN OLD RIVER CHANNEL INUNDATED WITH APPROXIMATELY 3' OF WATER

BEARINGS REFERENCED TO THE TREMPLEALEAU COUNTY COORDINATE SYSTEM

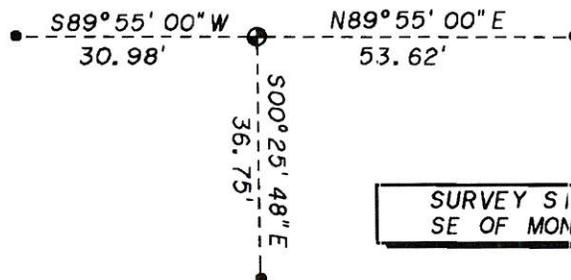

no scale

Corner identifier number

21107310020

44-233

Describe any material discrepancy between the location of the corner as restored or reestablished and the location of that corner as previously restored or reestablished by distance and direction. Show the discrepancy on the plan view drawing. Show the distances between the corner as restored or reestablished, and (1) the corner as restored or reestablished, and (2) to at least 2 of the witness monuments shown on the drawing.

**NO MATERIAL DISCREPANCY WAS FOUND.**

Was the corner restored through acceptance of (1) an obliterated evidence location, (2) a found perpetuated location, or (3) an existent corner location?

**A FOUND PERPETUATED LOCATION.**

Was the corner reestablished through lost corner proportionate methods? If so, show the method including the directions and distances to other public land survey corners used as evidence or used for proportioning in determining the corner location.

**NO.**

Show the corner history of record in chronological order from Original Government Survey to present.

**ORIGINAL GOVERNMENT SURVEY - J.E. FREEMAN - JANUARY 1845  
QUARTER SECTION CORNER IN RIVER.**

**RECORD OF LAND CORNER PERPETUATION - N. HURLBURT - NOVEMBER 1989  
FILES TIE SHEET FOR THE SOUTH QUARTER CORNER OF SECTION 31-19-7. NO  
EVIDENCE OF THE ORIGINAL GOVERNMENT MEANDER CORNERS WAS FOUND. DROVE A  
1" X 48" REBAR WITH AN ALUMINUM CAP MIDWAY BETWEEN SECTION CORNERS, IN OLD  
RIVER CHANNEL. SETS FOUR REFERENCE TIES.**

I, JOSEPH P. NELSEN  
certify that the corner location shown on this record  
was determined by me or under my direction and control  
and that this U.S. Public Land Survey Monument Record  
is correct to the best of my knowledge and belief.

  
Signature

10-17-97  
Date

Affix Land Surveyor Seal

