

21907 320000

TREMPEALEAU COUNTY


U.S. PUBLIC LAND SURVEY MONUMENT RECORD

SECTION Corner common to Sections 4, 5, 32 & 33

T. 18 & 19 N., R. 7 W.

Type of monument 7/8" X 30" REBAR WITH ALUMINUM CAP

Location indicated on sketch - \odot -

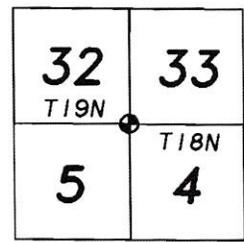


Location Sketch

Describe any record evidence, monument evidence, occupational evidence, testimonial evidence or any other material evidence you considered, and whether the monument was found or placed.

ORIGINAL GOVERNMENT ACCESSORIES WERE SEARCHED FOR, BUT NONE WERE FOUND. OTHER MONUMENT EVIDENCE WAS SEARCHED FOR, BUT NONE WAS FOUND. TWO 1" IRON PIPES WERE FOUND, WHICH APPEAR TO MATCH THE LOCATION OF THE TWO 2" IRON PIPES, CALLED AS CORNER TIES, BY J. ALLEN IN 1971. THE POSITION INDICATED BY J. ALLEN WAS RESTORED BY THE FOUND IRON PIPES. THIS POSITION WAS SEARCHED FOR ANY MONUMENT EVIDENCE, BUT NONE WAS FOUND. THE JACK OAK BEARING TREE, PURPORTED BY J. ALLEN TO BE AN ORIGINAL GOVERNMENT BEARING TREE, WAS SEARCHED FOR, BUT NOTHING OBVIOUS WAS FOUND. A ROTTEN STUMP WAS FOUND MATCHING CLOSELY WITH J. ALLEN'S RECORDED DISTANCE, HOWEVER, THE BEARING WAS FOUND TO BE OFF APPROXIMATELY 12° WHEN COMPARED TO THE ORIGINAL. THE ROTTEN WOOD APPEARS TO BE A SOFTWOOD, LIKE POPLAR, NOT OAK AS RECORDED. IN FACT, NO EVIDENCE OF ANY TREE REMAINS WERE FOUND AT THE POSITION INDICATED BY J. ALLEN. IT IS BELIEVED THAT AT LEAST SOME EVIDENCE OF A JACK OAK TREE WOULD BE VISIBLE AFTER ONLY 30 YEARS. IF ONLY BARELY VISIBLE REMAINS WERE AVAILABLE TO J. ALLEN IN 1971, THEN GREAT DOUBT WOULD EXIST AS TO WHETHER IT WAS IN FACT, AN ORIGINAL GOVERNMENT BEARING TREE. THEREFORE, THE FOLLOWING PROCEDURE WAS USED TO DETERMINE THIS CORNERS LOCATION. THE NORTH/SOUTH POSITION OF THIS CORNER WAS DETERMINED BY HOLDING THE PROJECTION OF THE LATITUDE CURVE FROM THE NORTHEAST AND NORTH QUARTER CORNERS OF SECTION 4-18-7. THE EAST/WEST POSITION WAS DETERMINED BY HOLDING THE PROPORTIONAL SPLIT OF DISTANCE BETWEEN THE NORTHWEST CORNER OF SECTION 5-18-7 AND THE NORTH QUARTER CORNER OF SECTION 4-18-7. THIS POSITION IS LOCATED 46.35 FEET NORTHWESTERLY OF THE J. ALLEN POSITION. THIS POSITION IS APPROXIMATELY 3 FEET NORTH OF A CROOKED, REMNANT, EAST/WEST FENCE LINE, AND APPROXIMATELY 19 FEET SOUTH OF THE EAST/WEST ROAD CENTERLINE. THIS POSITION MATCHES ORIGINAL GOVERNMENT DISTANCE TO THE EAST QUARTER CORNER OF SECTION 32-19-7 BY LESS THAN 5 FEET. IT MATCHES ORIGINAL GOVERNMENT DISTANCE TO BOTH THE NORTH QUARTER CORNER OF SECTION 5-18-7 AND THE NORTH QUARTER CORNER OF SECTION 4-18-7 BY LESS THAN 10 FEET. IT MATCHES ORIGINAL GOVERNMENT DISTANCE TO THE EAST QUARTER CORNER OF SECTION 5-18-7 BY ABOUT 8 FEET. IT MATCHES THE "DOUBLE-OVER" OF DISTANCE BETWEEN THE NORTHEAST AND EAST QUARTER CORNERS OF SECTION 32-19-7 BY LESS THAN 6 FEET. IT MATCHES THE "DOUBLE-OVER" OF DISTANCE BETWEEN THE NORTHEAST AND NORTH QUARTER CORNERS OF SECTION 4-18-7 BY LESS THAN 1 FOOT. IT ALSO MATCHES THE PROJECTION OF A REMNANT FENCE LINE FROM THE SOUTH, APPROXIMATELY 1200 FEET SOUTH OF THIS POSITION BY LESS THAN 3 FEET. THEREFORE, BELIEVING THE POSITION REFERENCED BY J. ALLEN IN 1971 TO HAVE BEEN BASED ON ILLOGICAL CONCLUSIONS AND BELIEVING THIS POSITION, AS DESCRIBED, TO BE THE BEST AVAILABLE EVIDENCE OF THE LOCATION OF THE ORIGINAL GOVERNMENT CORNER, A MONUMENT WAS SET AND REFERENCED AS SHOWN BELOW.

Show a plan view drawing depicting the relevant monuments, providing reference ties to at least 4 witness monuments. Describe witness monuments. Show relationship to occupation.

- o SET 5/8" X 24" REBAR WITH PLASTIC CAP
- FOUND 1" O.D. IRON PIPE
- + J. ALLEN COR. LOC. PER FOUND TIES

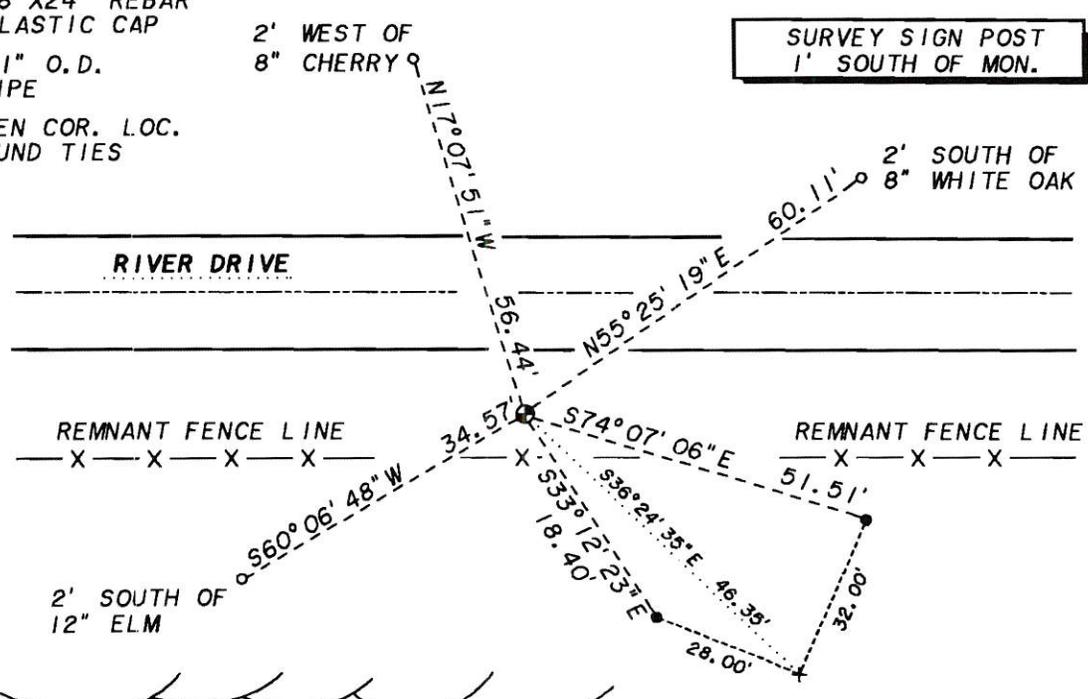

Corner identifier number 21907 320000

32-33



BEARINGS REFERENCED TO THE TREMPEALEAU COUNTY COORDINATE SYSTEM

FIELD

