

21907320020

TREMPEALEAU COUNTY

U.S. PUBLIC LAND SURVEY MONUMENT RECORD

QUARTER Corner common to Sections 5 8 32

T. 18 8 19 N., R. 7 W.

Type of monument 7/8" X 30" REBAR WITH ALUMINUM CAP

Location indicated on sketch - ⊕ -

32 T19N	32 T18N
5	5

Location Sketch


Describe any record evidence, monument evidence, occupational evidence, testimonial evidence or any other material evidence you considered, and whether the monument was found or placed.

ORIGINAL GOVERNMENT ACCESSORIES WERE SEARCHED FOR, BUT NONE WERE FOUND. OTHER MONUMENT EVIDENCE WAS SEARCHED FOR, BUT NONE WAS FOUND. NO OCCUPATIONAL EVIDENCE WAS FOUND. A POSITION FOR THIS CORNER WAS DETERMINED BY HOLDING SINGLE PROPORTIONATE MEASUREMENT, ALONG THE LATITUDE CURVE, BETWEEN THE NORTHWEST AND THE NORTHEAST CORNERS OF SECTION 5-18-7. THIS POSITION IS LOCATED IN A CULTIVATED FIELD, WHICH MAY EXPLAIN THE LACK OF MONUMENT EVIDENCE. THIS POSITION MATCHES ORIGINAL GOVERNMENT DISTANCE TO BOTH THE NORTHWEST AND NORTHEAST CORNERS OF SECTION 5-18-7 BY LESS THAN 10 FEET. IT ALSO MATCHES EAST/WEST OCCUPATION NEAR THE 1/16TH CORNER TO THE NORTH BY LESS THAN 4 FEET. THEREFORE, BELIEVING THIS POSITION, AS DESCRIBED, TO BE THE BEST AVAILABLE EVIDENCE OF THE LOCATION OF THE ORIGINAL GOVERNMENT CORNER, A MONUMENT WAS SET APPROXIMATELY 18" BELOW THE SURFACE IN A CULTIVATED FIELD AND REFERENCED AS SHOWN BELOW.

Show a plan view drawing depicting the relevant monuments, providing reference ties to at least 4 witness monuments. Describe witness monuments. Show relationship to occupation.

○ SET 5/8" X 24" REBAR WITH PLASTIC CAP

BEARINGS REFERENCED TO THE TREMPLEALEAU COUNTY COORDINATE SYSTEM

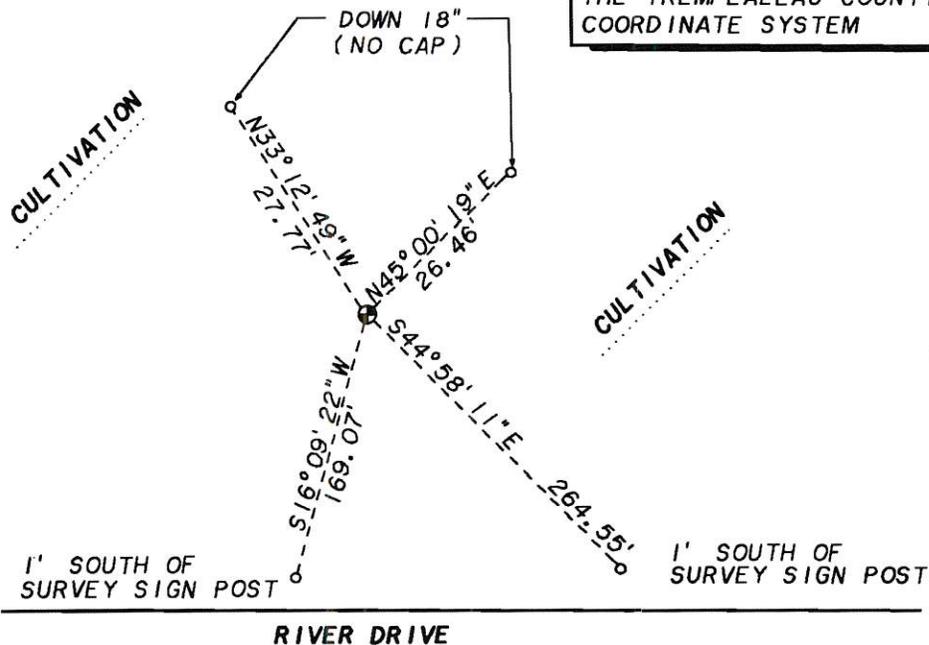

Corner Identifier number 21907320020

30-233



no scale

Describe any material discrepancy between the location of the corner as restored or reestablished and the location of that corner as previously restored or reestablished by distance and direction. Show the discrepancy on the plan view drawing. Show the distances between the corner as restored or reestablished, and (1) the corner as restored or reestablished, and (2) to at least 2 of the witness monuments shown on the drawing.

NO MATERIAL DISCREPANCY WAS FOUND.

Was the corner restored through acceptance of (1) an obliterated evidence location, (2) a found perpetuated location, or (3) an existent corner location?

N/A.


Was the corner reestablished through lost corner proportionate methods? If so, show the method including the directions and distances to other public land survey corners used as evidence or used for proportioning in determining the corner location.

**YES. SINGLE PROPORTIONATE MEASUREMENT, ALONG THE LATITUDE CURVE, BETWEEN THE NORTHWEST AND NORTHEAST CORNERS OF SECTION 5-18-7 WAS USED.
NORTHWEST CORNER TO NORTH QUARTER CORNER - N89°35' 00"E, 2630.26 FEET
NORTH QUARTER CORNER TO NORTHEAST CORNER - N89°34' 34"E, 2630.26 FEET
(BEARINGS REFERENCED TO THE TREMPLEALEU COUNTY COORDINATE SYSTEM)**

Show the corner history of record in chronological order from Original Government Survey to present.

**ORIGINAL GOVERNMENT SURVEY - J.E. FREEMAN - NOVEMBER 1845
SET QUARTER SECTION POST. MARKED ONE BEARING TREE.**

I, JOSEPH P. NELSEN
certify that the corner location shown on this record was determined by me or under my direction and control and that this U.S. Public Land Survey Monument Record is correct to the best of my knowledge and belief.

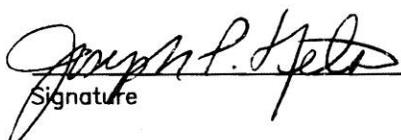
Signature

11-7-02
Date

Affix Land Surveyor Seal

