

21907332000

TREMPEALEAU COUNTY


U.S. PUBLIC LAND SURVEY MONUMENT RECORD

QUARTER Corner common to Sections 33 & 34

T. 19 N., R. 7 W.

Type of monument 7/8" X 30" REBAR WITH ALUMINUM CAP

Location indicated on sketch -  -

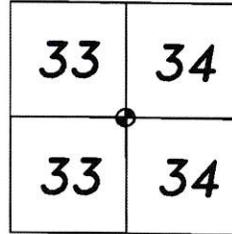

Location Sketch

Describe any record evidence, monument evidence, occupational evidence, testimonial evidence or any other material evidence you considered, and whether the monument was found or placed.

ORIGINAL GOVERNMENT ACCESSORIES WERE SEARCHED FOR, BUT NONE WERE FOUND. OTHER MONUMENT EVIDENCE WAS SEARCHED FOR, BUT NONE WAS FOUND. A POSITION FOR THIS CORNER WAS DETERMINED USING SINGLE PROPORTIONATE MEASUREMENT BETWEEN THE NORTHEAST AND SOUTHEAST CORNERS OF SECTION 33-19-7. THIS POSITION MATCHES ORIGINAL GOVERNMENT DISTANCE TO BOTH THE NORTHEAST AND SOUTHEAST CORNERS OF SECTION 33-19-7 BY LESS THAN 7 FEET. THEREFORE, BELIEVING THIS POSITION, AS DESCRIBED, TO BE THE BEST AVAILABLE EVIDENCE OF THE LOCATION OF THE ORIGINAL GOVERNMENT CORNER, A MONUMENT WAS SET AND REFERENCED AS SHOWN BELOW.

Show a plan view drawing depicting the relevant monuments, providing reference ties to at least 4 witness monuments. Describe witness monuments. Show relationship to occupation.

