


U. S. PUBLIC LAND SURVEY MONUMENT RECORD

SECTION 34 T 19 N, R 7 W, TOWN OF FARMINGTON

LA CROSSE COUNTY

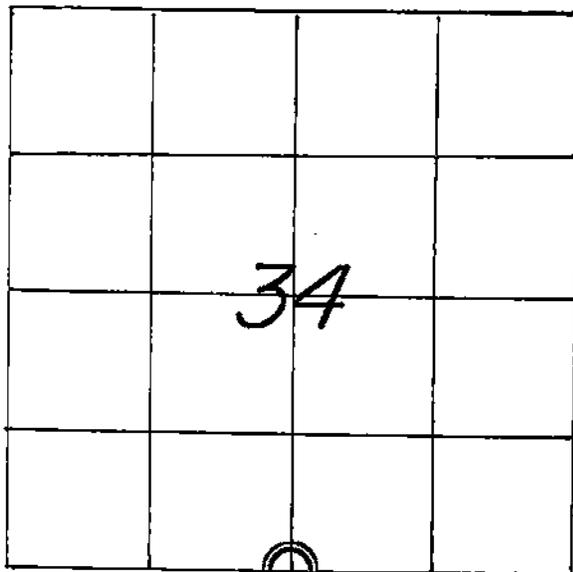

LOCATION OF LANDMARK

CREW: **WILLIAM C. JUNG**
PETER F. FOLLANSBEE
 DATE: **12/20/2002**

WISCONSIN COORDINATE SYSTEM

North **757,100.848**East **1,652,568.969**

Theta Angle

Horiz. Order

Vert. Order

DATUM: **1983('91)**

TYPE OF LANDMARK

5/8" x 36" REBAR WITH RED PLASTIC CAP.

BEARINGS ARE REFERENCED TO
 GRID NORTH AS PER SECTION DATA.

Describe any record evidence, monument evidence, testimonial evidence or any other material evidence you considered and whether the monument was found or restored through acceptance of an obliterated evidence location.

I found an old 3 foot plus stump that appeared to be burnt. It also had what appeared to be a scar pointing to the Southeast. Only a remnant of the stump was left. I believe that this stump is that of the original bearing tree and as such set the corner off of it as per the original notes. This was the Northwest bearing tree. I set an iron bar with a red cap at the corner.

Describe or show any material discrepancy between the location of the restored corner and that of the corner previously restored or reestablished.

NONE KNOWN.

