


## U. S. PUBLIC LAND SURVEY MONUMENT RECORD

SECTION 35 T 19 N, R 7 W, TOWN OF FARMINGTON

LA CROSSE COUNTY

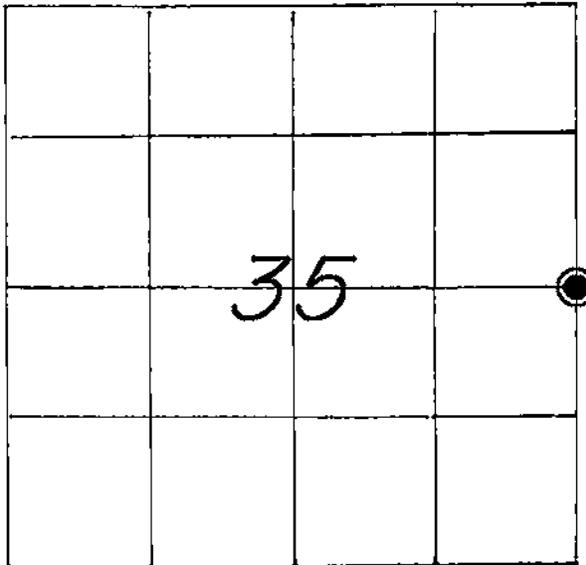

WISCONSIN COORDINATE SYSTEM

North

East

Theta Angle

Horiz. Order

Vert. Order

TYPE OF LANDMARK

*3/4" x 30" IRON BAR WITH AN ALUMINUM CAP*

BEARINGS ARE REFERENCED TO

*ASSUMED NORTH.*

LOCATION OF LANDMARK

CREW: WILLIAM C. JUNG  
PETER F. FOLLANSBEE

9/2/98

Describe any record evidence, monument evidence, testimonial evidence or any other material evidence you considered and whether the monument was found or restored through acceptance of an obliterated evidence location.

I found what I believe to be the original Burr Oak bearing tree to the southwest and reset the corner with a 3/4" x 30" round iron bar with a cap. According to Bruce Stumlin, this would put the corner where he, his dad, and Grandpa said that the corner was.


Describe or show any material discrepancy between the location of the restored corner and that of the corner previously restored or reestablished.

*NONE KNOWN.*

RECORD OF DURABLE WITNESS MONUMENTS


MAGNETIC

NO	DESCRIPTION	BEARING	DISTANCE
1	SET A NAIL IN THE W-SIDE OF A 14-1/2" BURR OAK	N 05° E	22.18 FT.
2	SET A P.K. NAIL IN THE S.W-SIDE OF A 17" BURR OAK	S 80° E	13.20 FT.
3	SET A NAIL IN THE W-SIDE OF A 14" BURR OAK	S 08° E	14.66 FT.
4	SET A NAIL IN THE S.E-SIDE OF A 10-1/2" BURR OAK	S 27° W	28.49 FT.

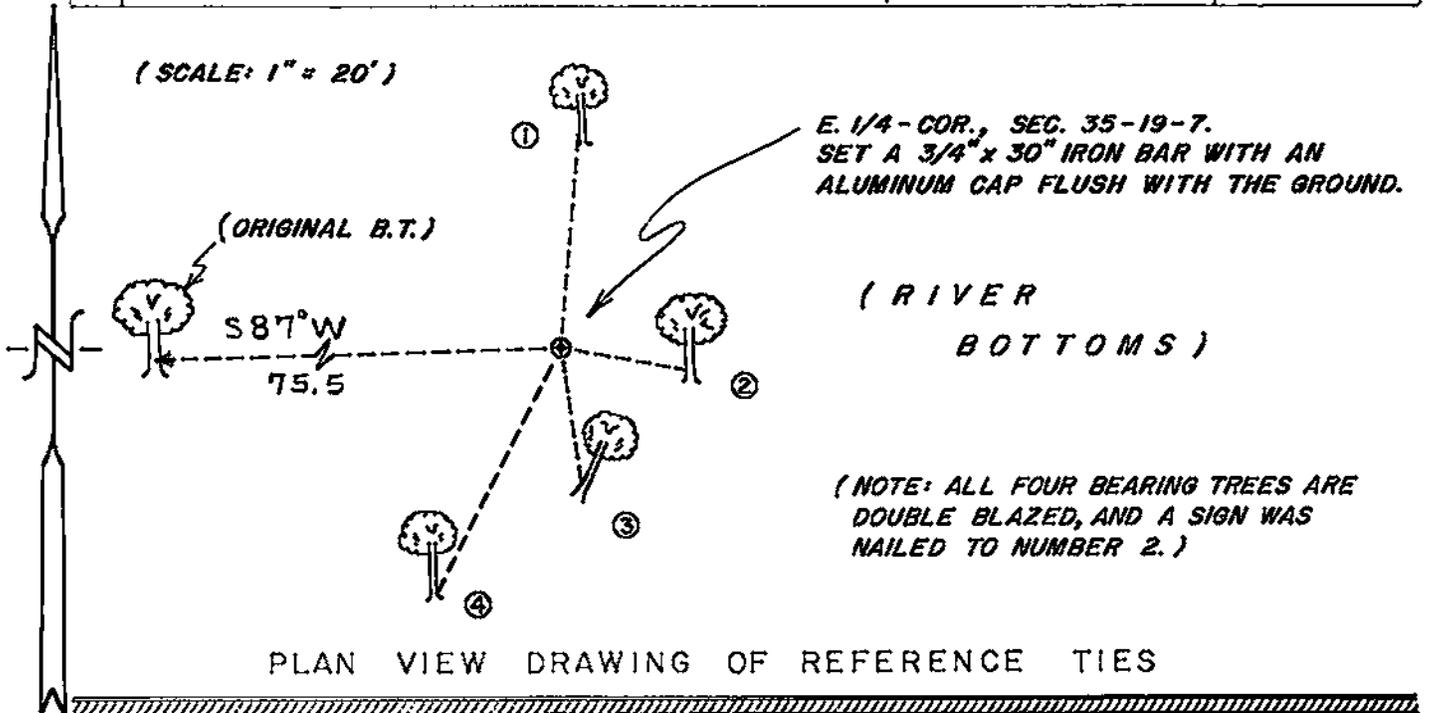

MAP SHOWING DISTANCE AND DIRECTION TO OTHER PUBLIC LAND SURVEY CORNERS USED FOR REESTABLISHING THE CORNER

(not to scale)

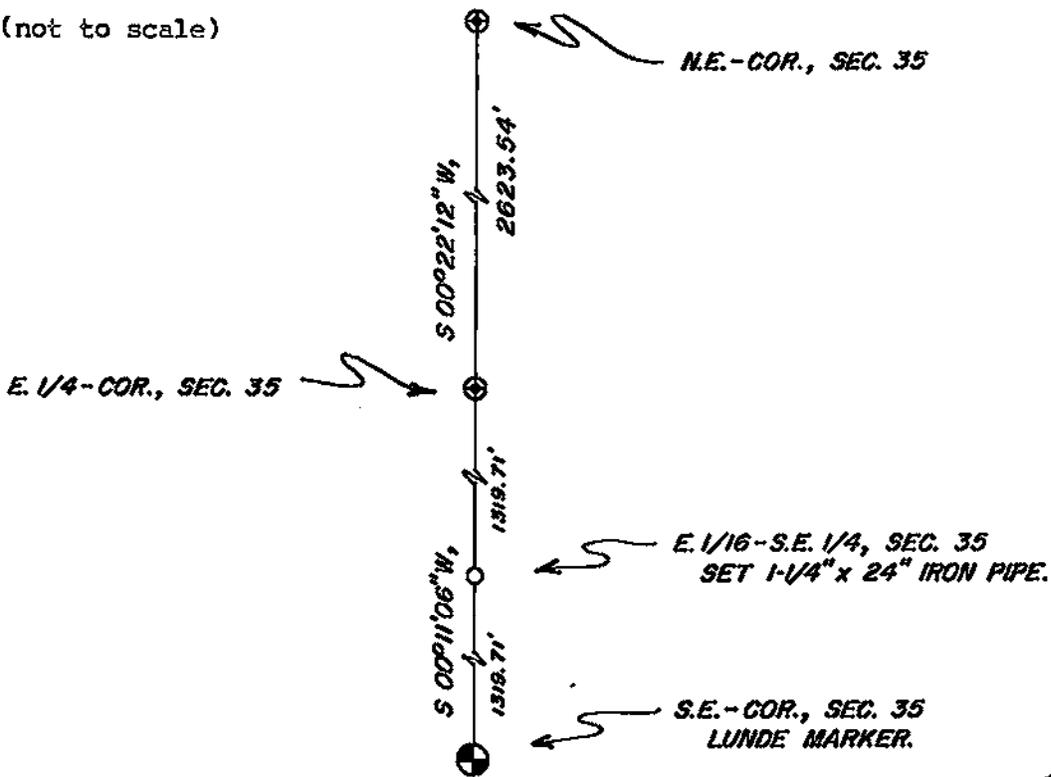

I, WILLIAM C. JUNG, COUNTY SURVEYOR  
 HEREBY CERTIFY THAT THE CORNER LOCATION SHOWN ON THIS RECORD  
 WAS DETERMINED BY ME OR UNDER MY DIRECTION AND CONTROL AND  
 THAT THIS U. S. PUBLIC LAND SURVEY MONUMENT RECORD IS CORRECT  
 AND COMPLETE TO THE BEST OF MY KNOWLEDGE AND BELIEF.

William C. Jung  
 Signature

October 29, 1998  
 Date

