


21907360000

## U. S. PUBLIC LAND SURVEY MONUMENT RECORD

SECTION 1 T 18 N, R 7 W, TOWN OF FARMINGTON  
LA CROSSE COUNTY

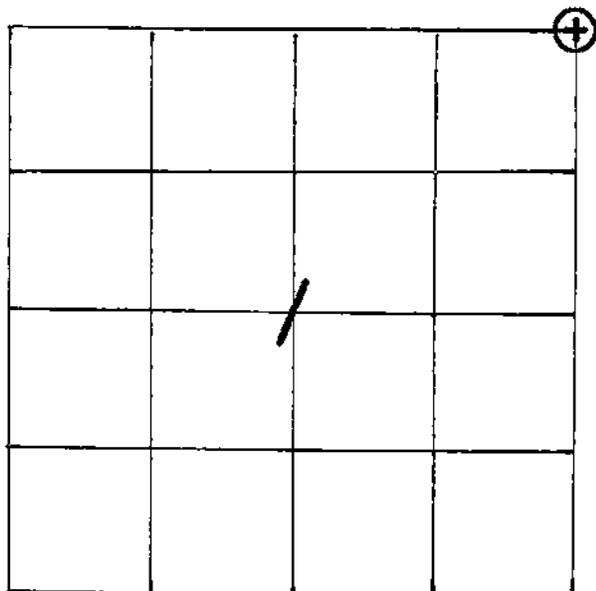

## WISCONSIN COORDINATE SYSTEM

North 756,933.354

East 1,665,769.095

Theta Angle

Horiz. Order

Vert. Order

DATUM: 1983('91)

## TYPE OF LANDMARK

3/4" x 30" IRON BAR WITH ALUMINUM CAP.

BEARINGS ARE REFERENCED TO

GRID NORTH AS PER SECTION DATA.

## LOCATION OF LANDMARK

CREW: WILLIAM C. JUNG

PETER F. FOLLANSBEE

DATE: 3/12/2002

Describe any record evidence, monument evidence, testimonial evidence or any other material evidence you considered and whether the monument was found or restored through acceptance of an obliterated evidence location.


**THIS CORNER WAS SET AT A COMPUTED LOCATION AS DETERMINED BY NORM HURLBURT IN 1990. SEE HURLBURT'S "MAP OF SURVEY", DATED JANUARY 3, 1991, FOR MORE DETAIL.**

Describe or show any material discrepancy between the location of the restored corner and that of the corner previously restored or reestablished.

**NONE KNOWN.**


RECORD OF DURABLE WITNESS MONUMENTS  
MAGNETIC

NO	DESCRIPTION	BEARING	DISTANCE
1	SET A P.K. NAIL IN S.W.-SIDE OF A 6" ASH	N 36° E	15.95 FT.
2	SET A P.K. NAIL IN S.-SIDE OF AN 8" MAPLE	S 66° E	14.67 FT.
3	PREVIOUSLY SET 1" x 6.7' IRON PIPE (FLUSH)	S 55° E	20.09 FT.
4	SET A P.K. NAIL IN N.E.-SIDE OF A TRIPLE MAPLE	S 37° E	33.90 FT.

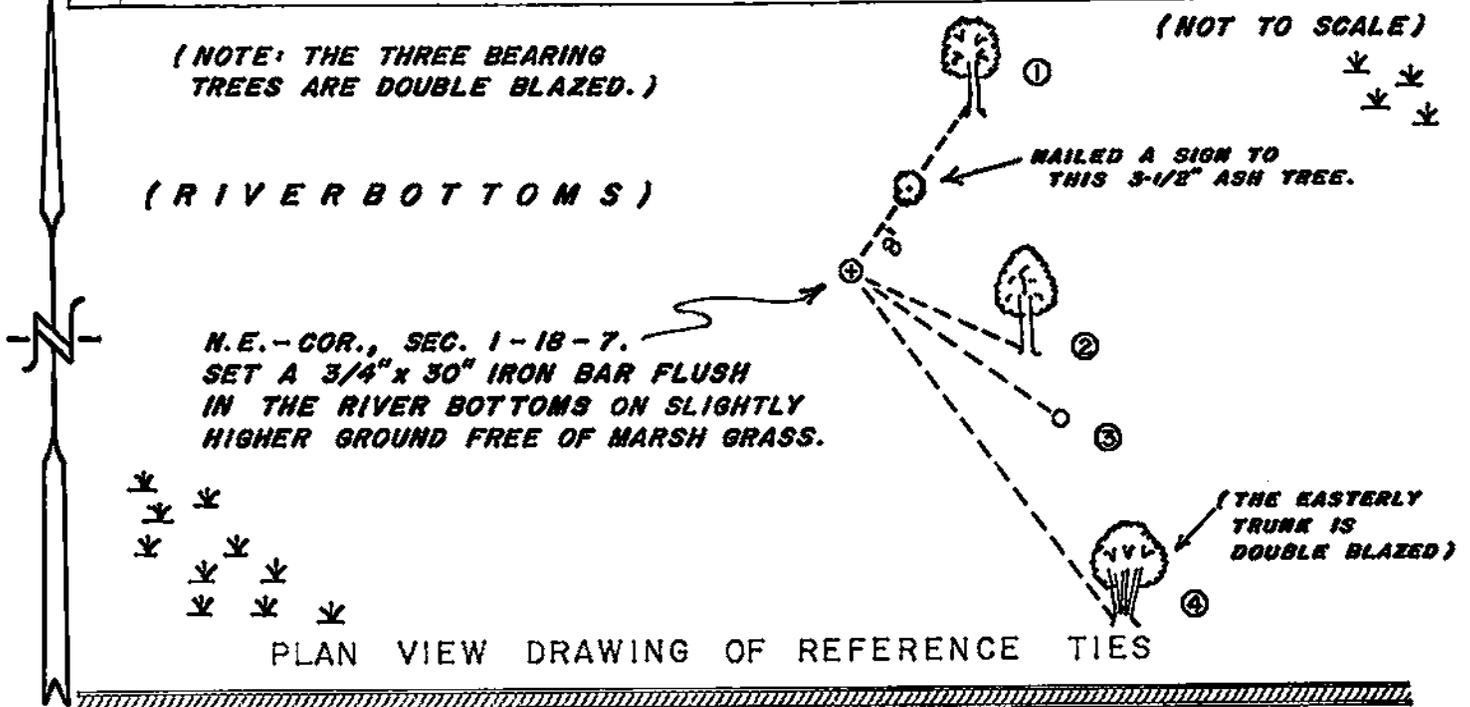


MAP SHOWING DISTANCE AND DIRECTION TO OTHER PUBLIC LAND SURVEY CORNERS USED FOR REESTABLISHING THE CORNER

(GRID BEARINGS & DISTANCES)  
(GRID FACTOR: 0.999965661)  
(NOT TO SCALE)

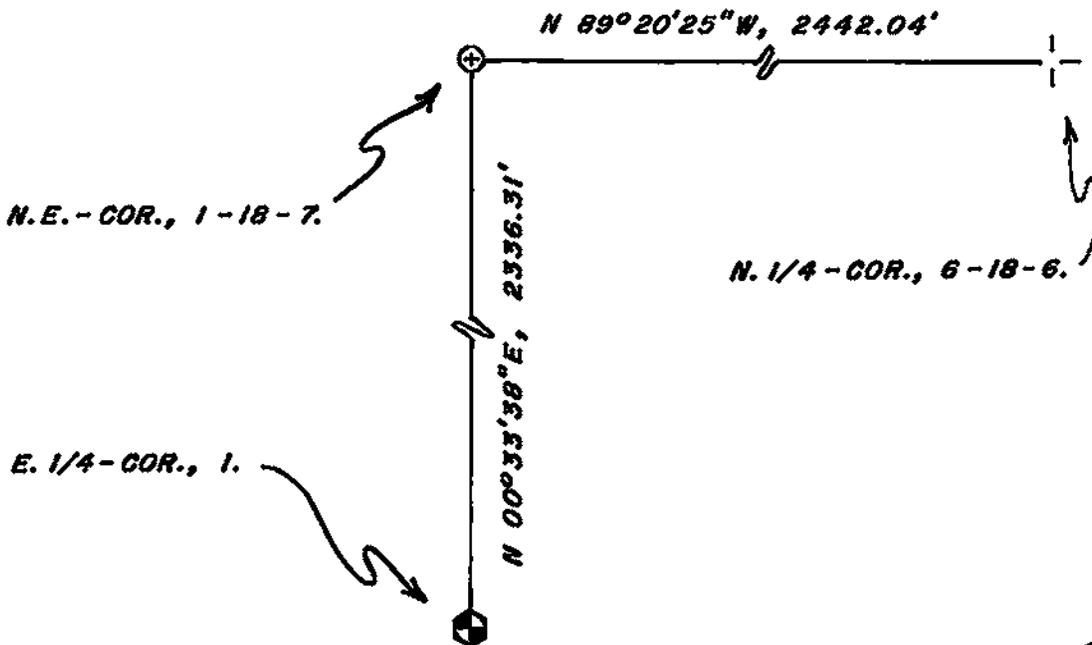

I, WILLIAM C. JUNG, COUNTY SURVEYOR  
HEREBY CERTIFY THAT THE CORNER LOCATION SHOWN ON THIS RECORD WAS DETERMINED BY ME OR UNDER MY DIRECTION AND CONTROL AND THAT THIS U. S. PUBLIC LAND SURVEY MONUMENT RECORD IS CORRECT AND COMPLETE TO THE BEST OF MY KNOWLEDGE AND BELIEF.

William C. Jung                      4/1/02  
Signature                                      Date

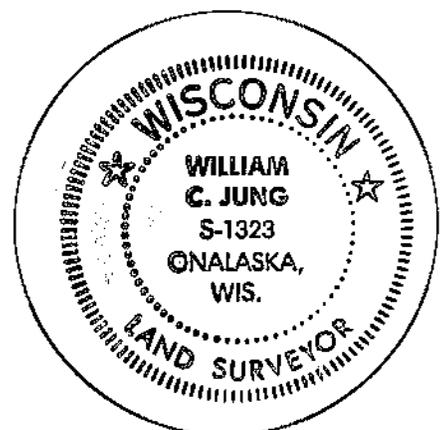

Seal