E.T.C., INC.
784-4070

REGISTERED ENGINEERS AND LAND SURVEYORS
432 DIVISION STREET — LACROSSE, WISCONSIN

# PLAT OF SURVEY

VB-1

PROPERTY OF RODNEY BERG

DESCRIBED AS FOLLOWS: PART OF OUTLOT 30, VILLAGE OF BANGOR, LA CROSSE CO., WISCONSIN

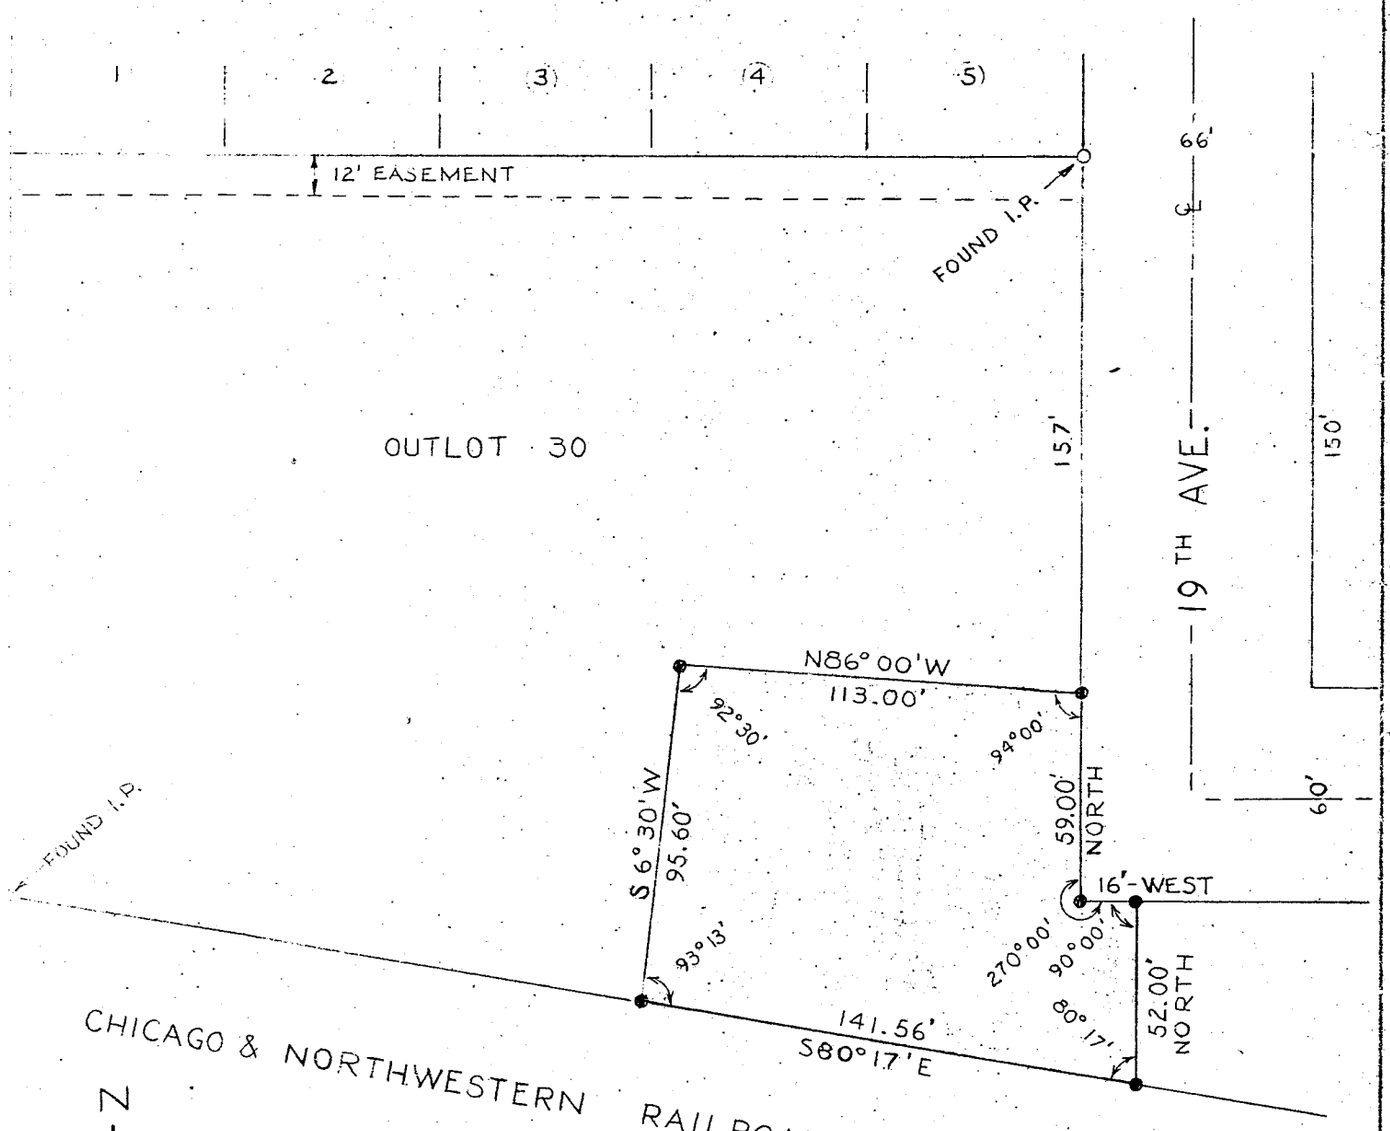


CERTIFICATE OF SURVEY

I HEREBY CERTIFY THAT ON MARCH 8, 1975 I SURVEYED THE PROPERTY DESCRIBED ABOVE AND THAT THE ABOVE PLAT IS A CORRECT REPRESENTATION OF SAID SURVEY.

REG NO. S00675

SCALE 1" INCH = 50' FEET
● - INDICATES IRON PIPE SET
O - INDICATES IRON PIPE FOUND
BK 11A PG 56 JOB NO.

(193)