VB-12

4-16-5 VB-12

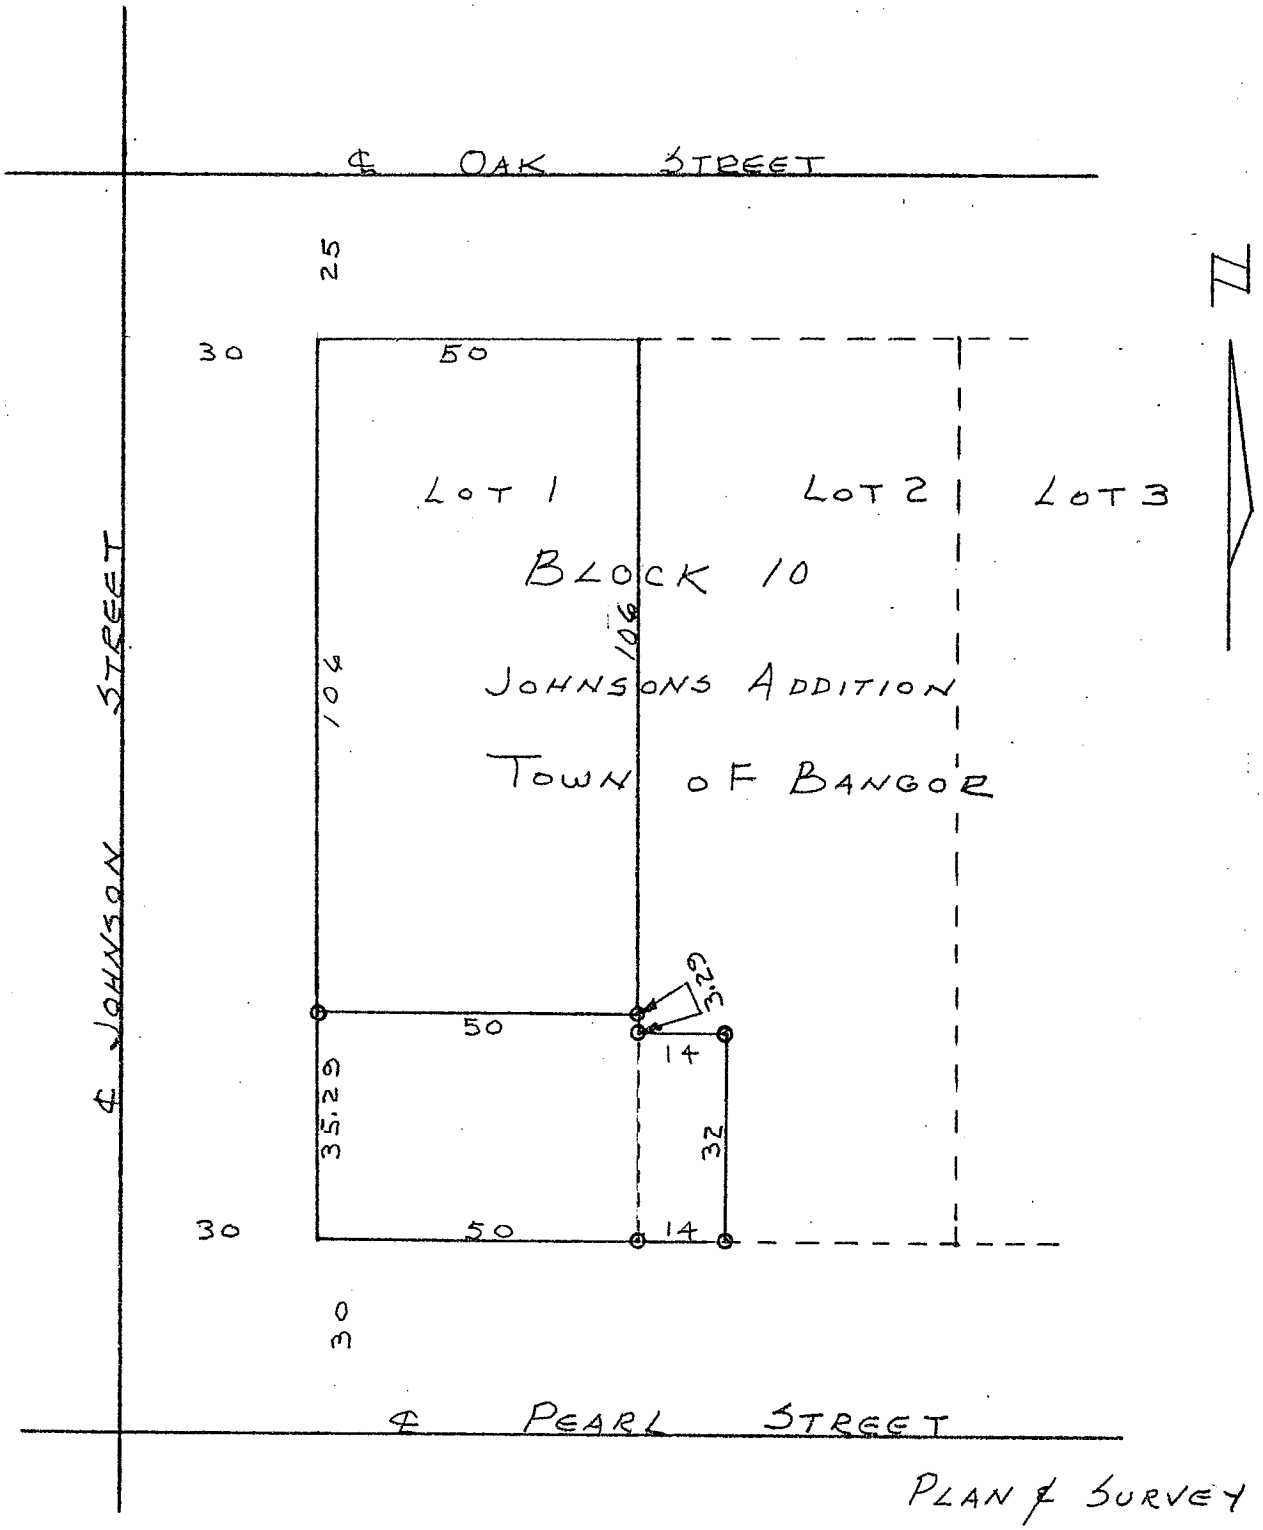

PLAN & SURVEY
OSCAR BERG PROP
TOWN OF BANGOR
J. S. MURPHY REG.
LAND SURVEYOR 5-578
SCALE 1" = 30' 9-1-63