UB 4-16-5 VB13

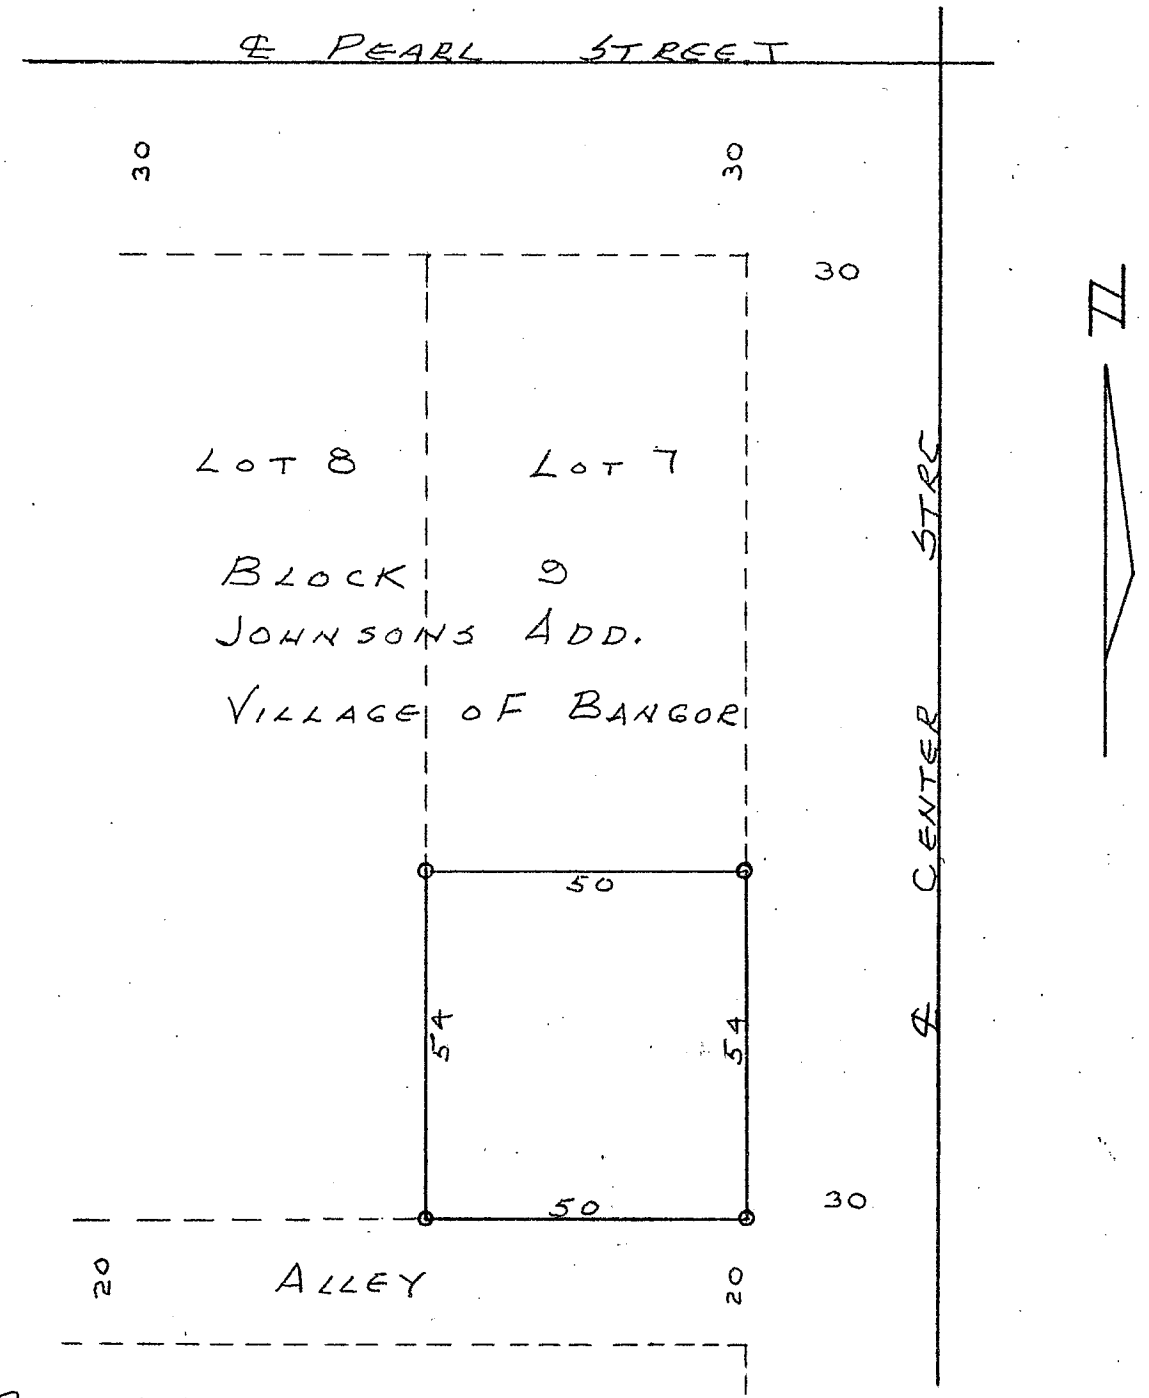

PLAN & SURVEY OF THE 50.54'
OF LOT 7 BLK 9 OF THE
CLIFF FOSSUM PROP.
TOWN OF BANGOR
J.S. MURPHY REG. LAND SURVEYOR
S-578

SCALE 1" = 30'
9-1-63