VB-16

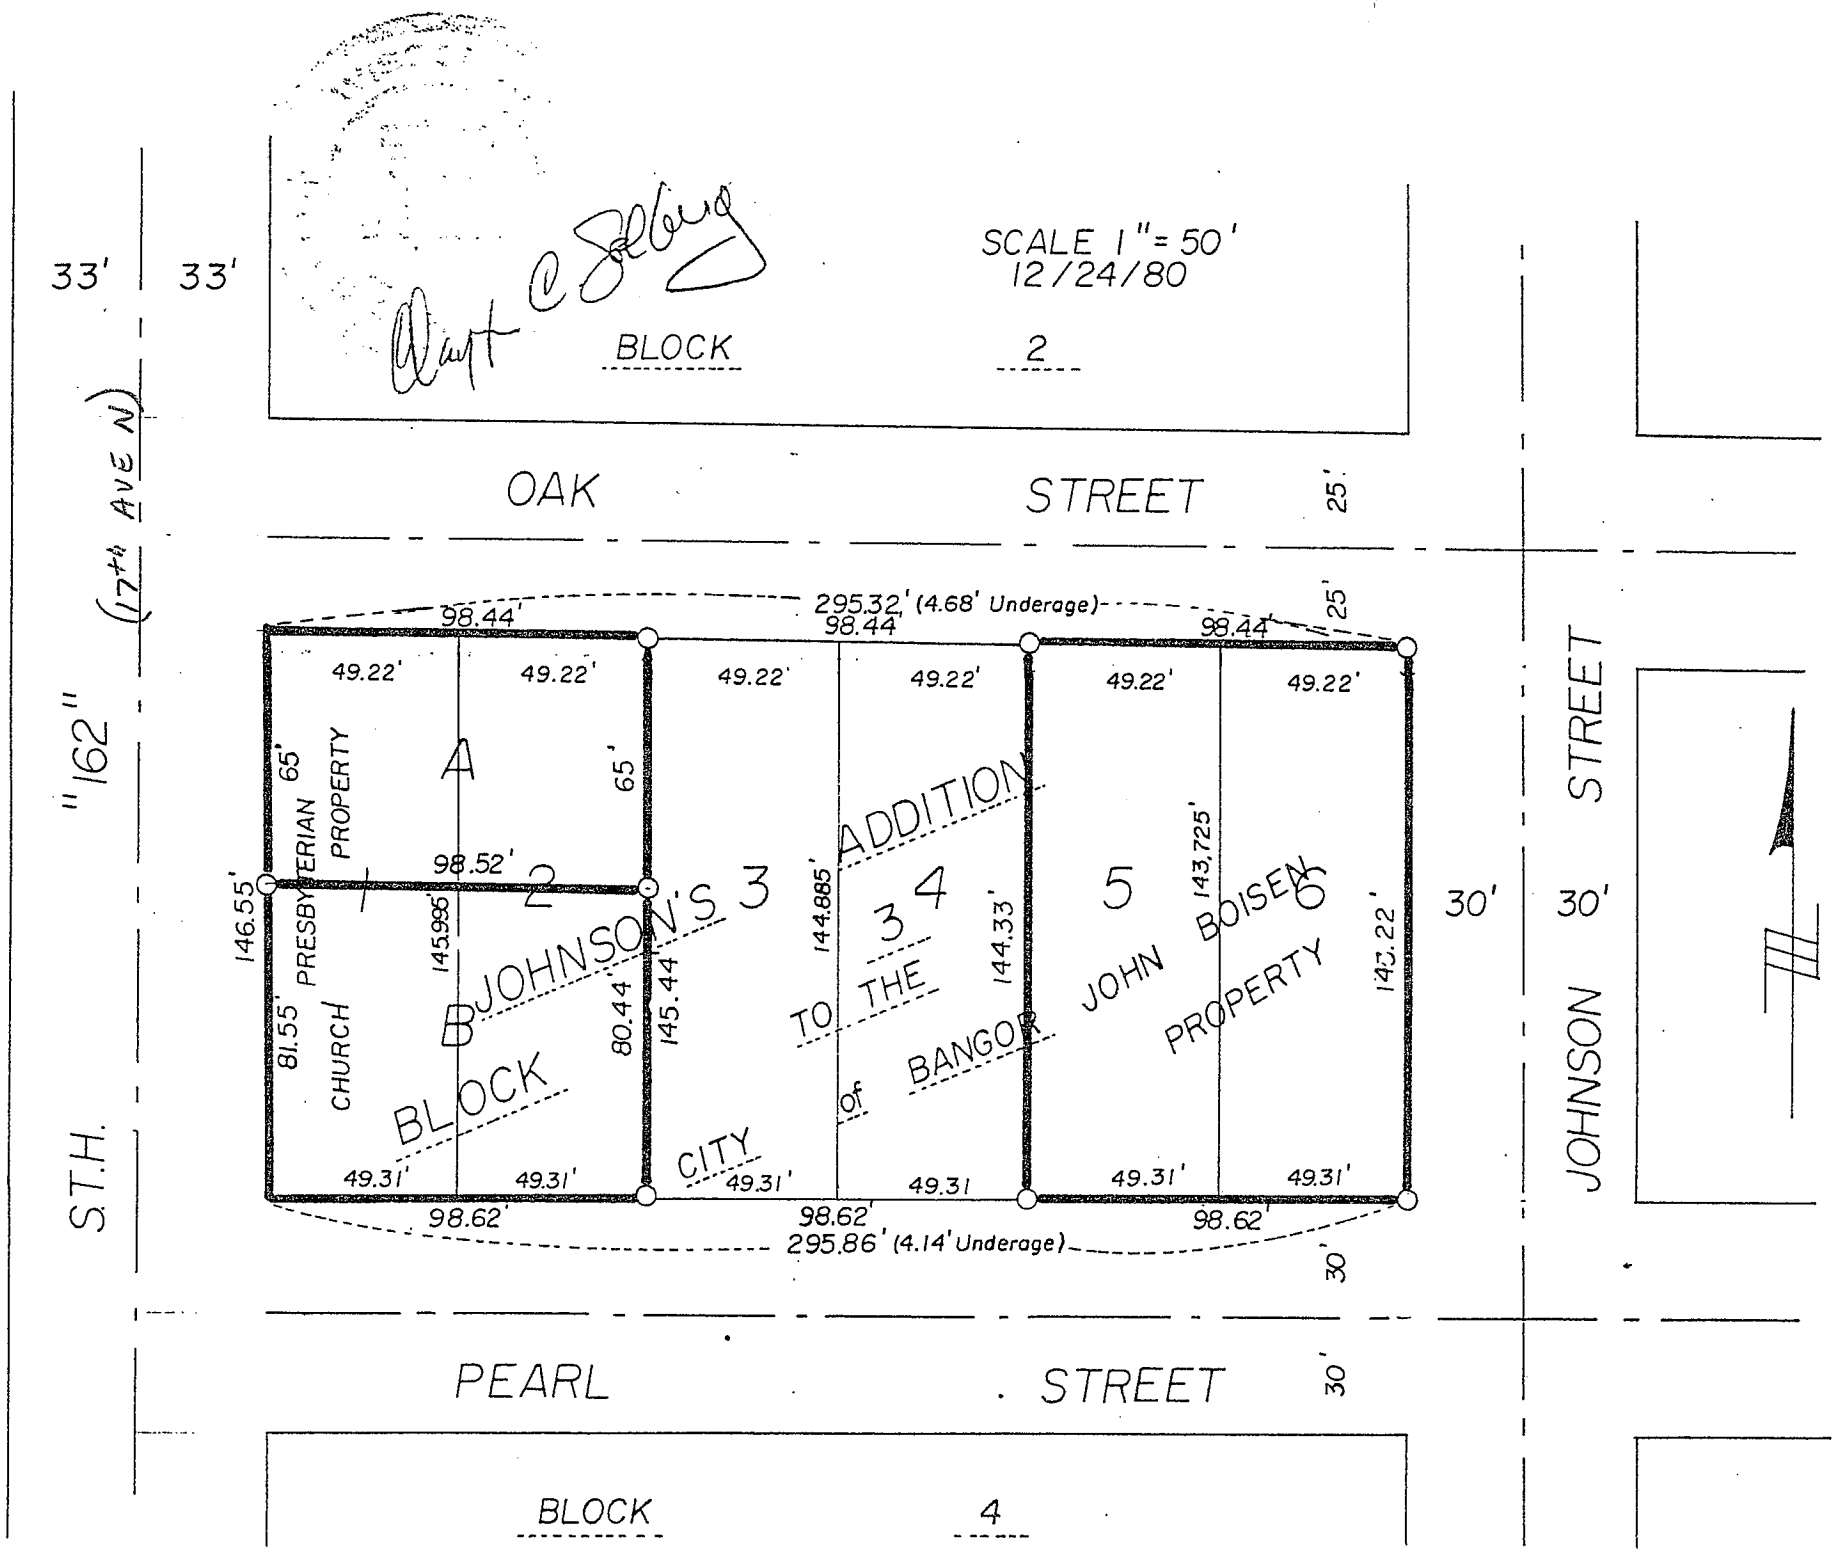

SCALE 1" = 50'
12/24/80
BLOCK 2
OAK STREET
PEARL STREET
BLOCK 4
JOHNSON STREET
ST.H. "162" (17th AVE N)
33'
33'
25'
25'
30'
30'
30'
30'
295.32' (4.68' Underage)
295.86' (4.14' Underage)
98.44'
98.44'
98.44'
98.52'
98.62'
98.62'
98.62'
49.22'
49.22'
49.22'
49.22'
49.22'
49.22'
49.31'
49.31'
49.31'
49.31'
49.31'
49.31'
65'
65'
146.55'
81.55'
145.995'
80.44'
145.44'
144.885'
144.33'
143.725'
143.22'
A
B
1
2
3
3
4
5
6
PRESBYTERIAN CHURCH PROPERTY
JOHNSON'S ADDITION TO THE CITY of BANGOR
JOHN BOISEN PROPERTY