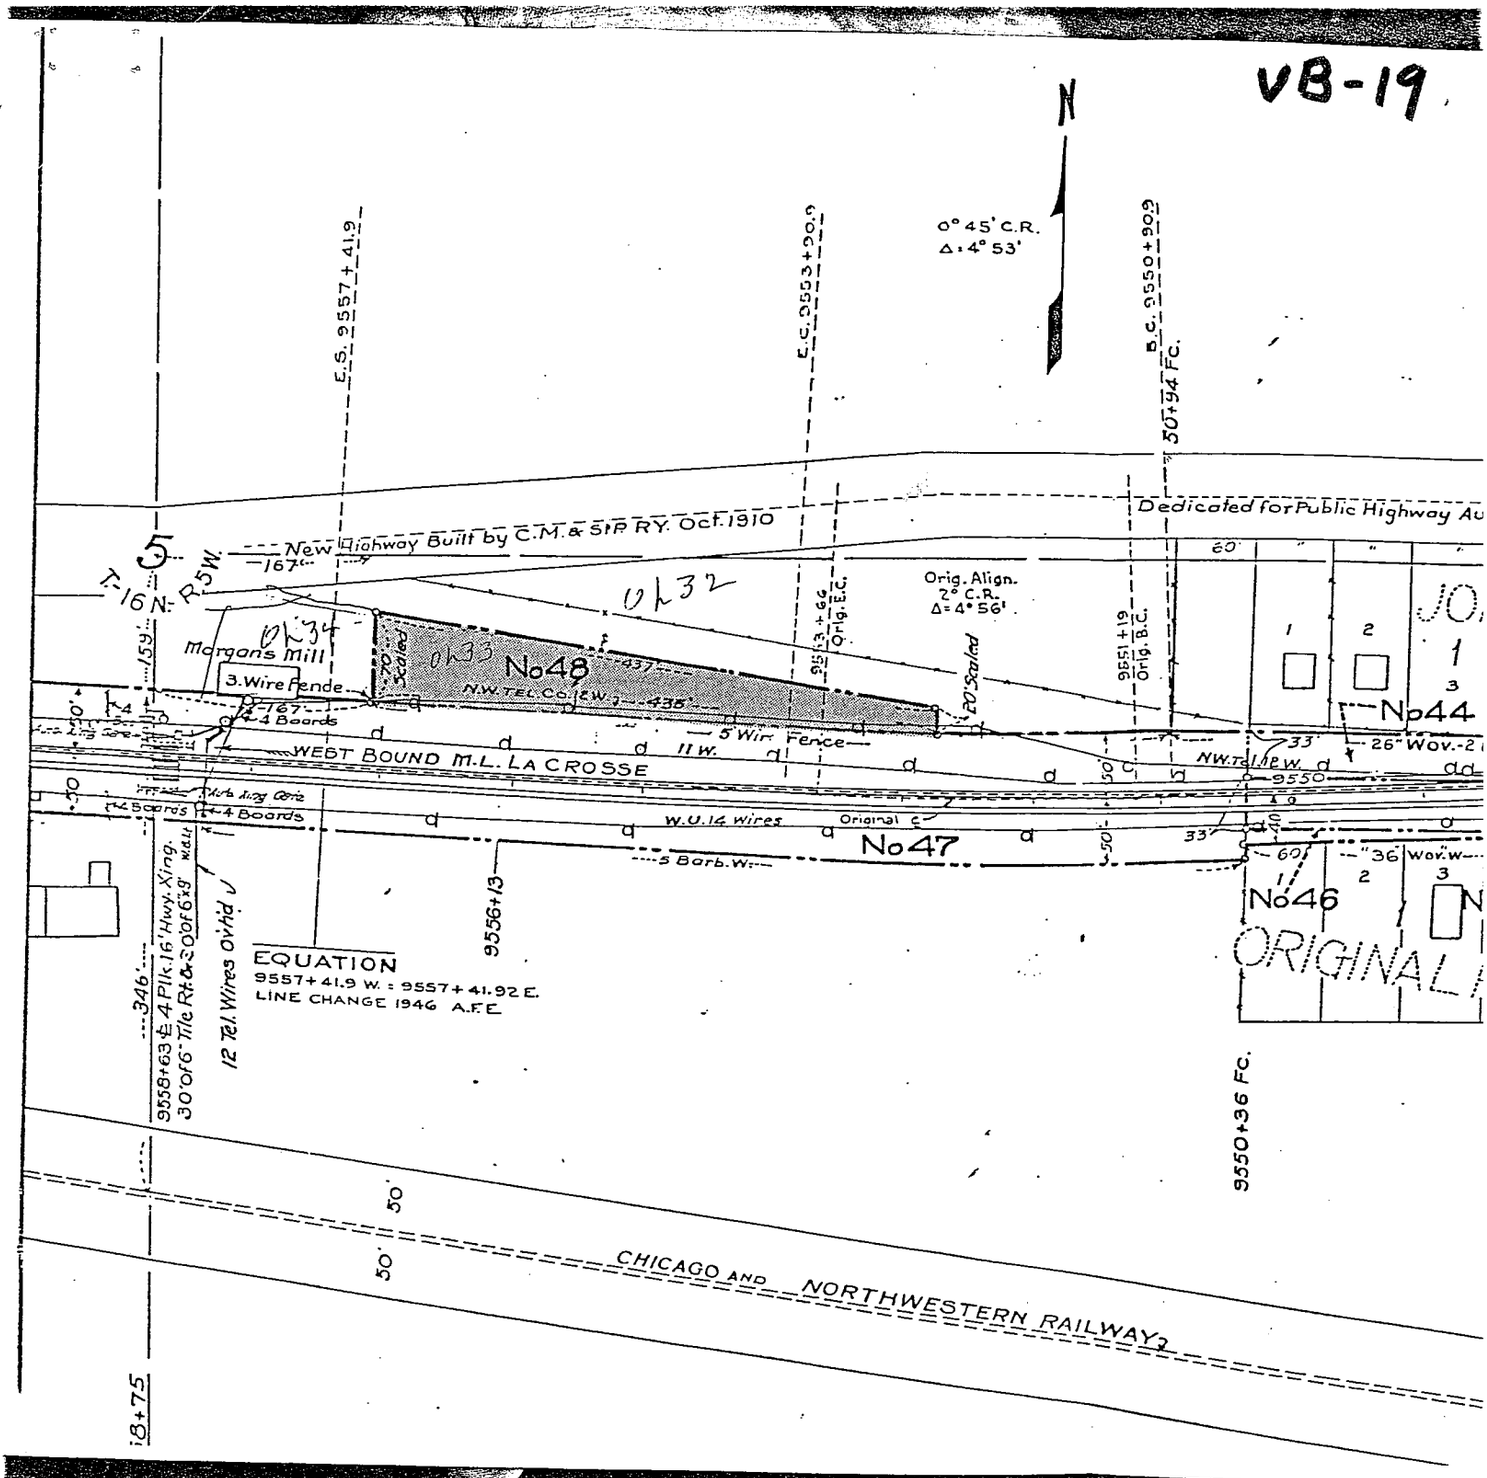
VB-19
N
0° 45' C.R.
Δ = 4° 53'
E.S. 9557+41.9
E.C. 9553+90.9
B.C. 9550+90.9
50+94 Fc.
Dedicated for Public Highway Au
New Highway Built by C.M. & St.P. RY. Oct. 1910
T. 16 N. R. 5 W.
Orig. Align.
2° C.R.
Δ = 4° 56'
Orig. E.C.
Orig. B.C.
Morgans Mill
3. Wire Fence
No48
N.W. TEL. Co. 12 W.
5 Wire Fence
11 W.
WEST BOUND M.L. LA CROSSE
No44
26" Wov.
W.U. 14 Wires
Original
No47
5 Barb. W.
No46
36" Wov. W.
ORIGINAL
9556+13
EQUATION
9557+41.9 W. = 9557+41.92 E.
LINE CHANGE 1946 A.F.E.
12 Tel. Wires Ovhd.
9558+63 ℄ 4 Plk. 16' Hwy. Xing.
30' of 6" Tile Rt. & 20' of 6" x 9'
9550+36 Fc.
CHICAGO AND NORTHWESTERN RAILWAY
18+75

**CMC REAL ESTATE CORPORATION**

TOWN BANGOR COUNTY La CROSSE STATE WISCONSIN

CMC PROPERTY SHADED GRAY, PROPOSED SALE AREA OUTLINED IN RED.

TO: _____

SALE AREA = _____

SCALE 1" = 100' SEC. 5 TWP. 16 N RGE. 5 W

VAL. SEC. WIS 3 SALE ■ LEASE □ EASEMENT □

MAP S-45 AREA = 19575 ± SQ.FT. = .45 ± ACRES

DATE 2-18-87 REVISED _____ EXHIBIT "A"

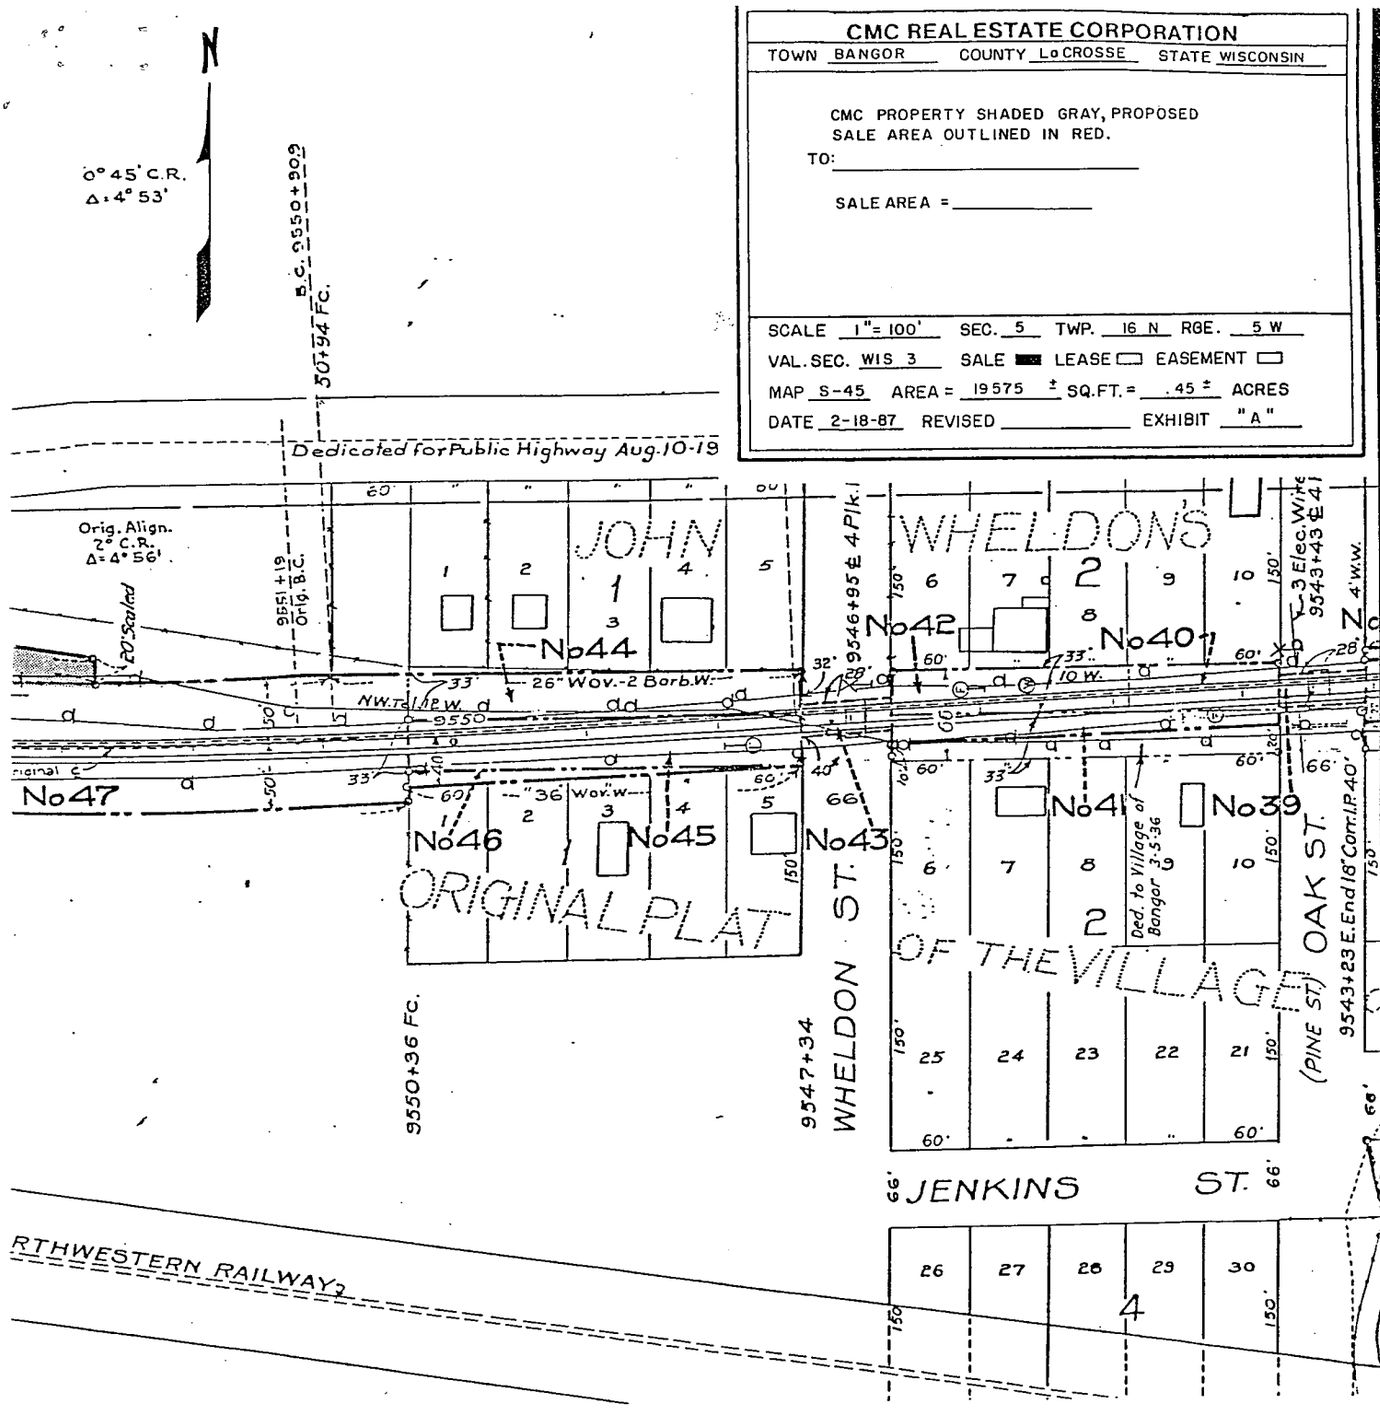

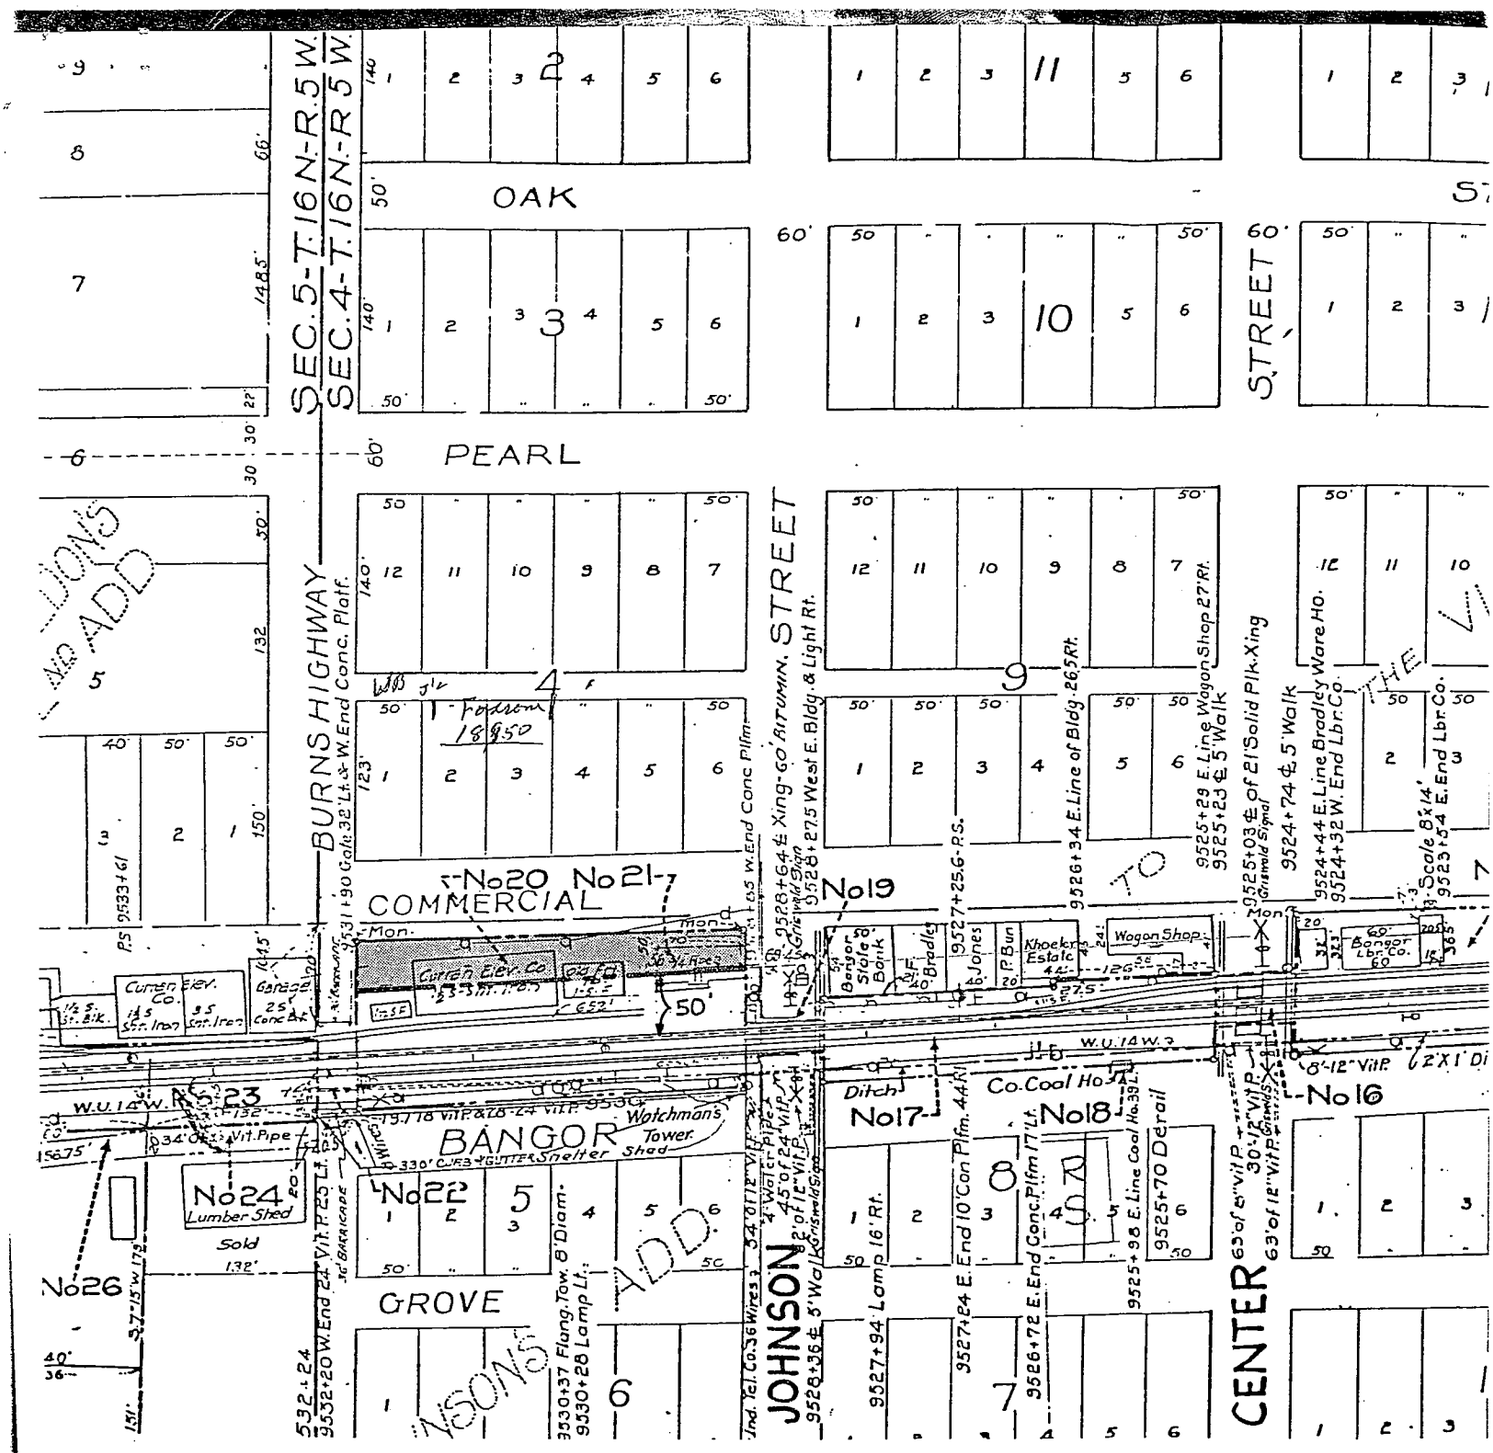

SEC. 5-T. 16 N.-R. 5 W.
SEC. 4-T. 16 N.-R. 5 W.
OAK
PEARL
STREET
BURNS HIGHWAY
COMMERCIAL
BANGOR
GROVE
JOHNSON
CENTER
No20
No21
No19
No17
No18
No16
No22
No24
No26
Curren Elev. Co.
Watchman's Tower
Lumber Shed
Sold
Co. Coal Ho.
Wagon Shop
Khoeler Estate
Bangor Lbr. Co.
Ditch

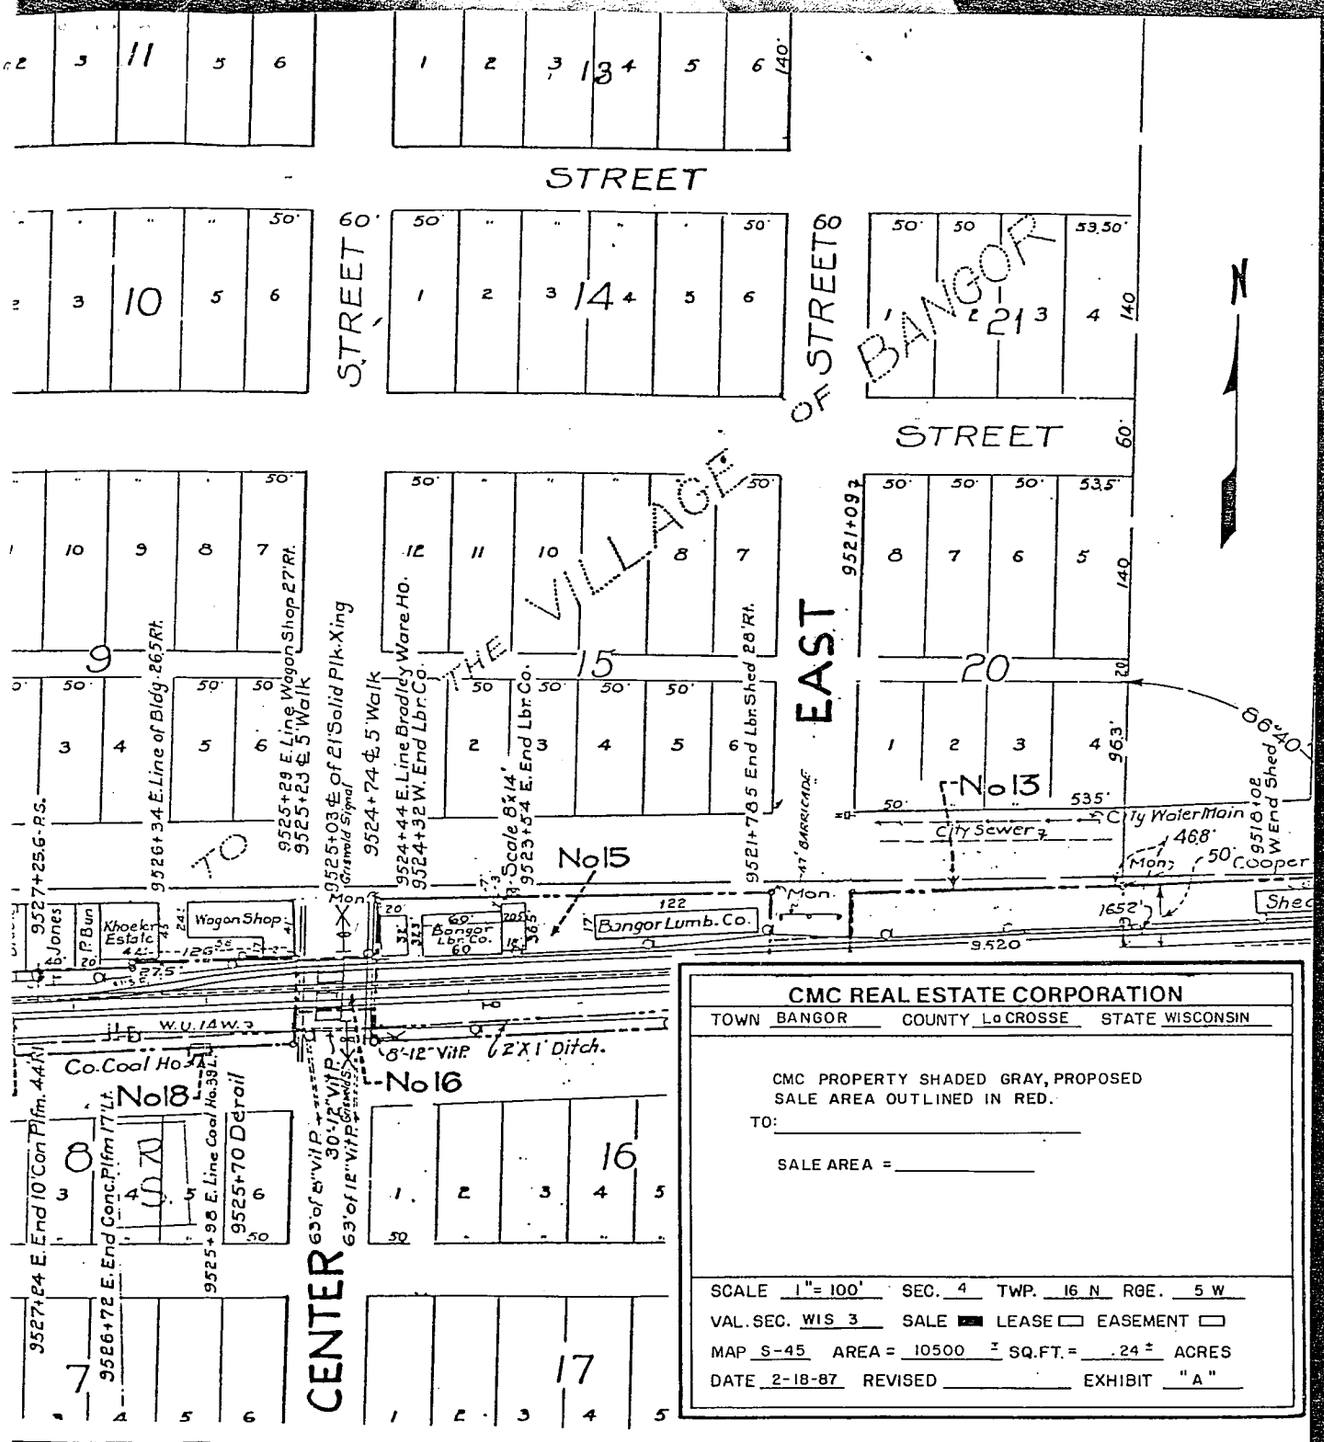


**CMC REAL ESTATE CORPORATION**

TOWN BANGOR COUNTY La CROSSE STATE WISCONSIN

CMC PROPERTY SHADED GRAY, PROPOSED SALE AREA OUTLINED IN RED.

TO: _____

SALE AREA = _____

SCALE 1" = 100' SEC. 4 TWP. 16 N RGE. 5 W

VAL. SEC. WIS 3 SALE ■ LEASE ☐ EASEMENT ☐

MAP S-45 AREA = 10500 ± SQ.FT. = .24 ± ACRES

DATE 2-18-87 REVISED _____ EXHIBIT "A"

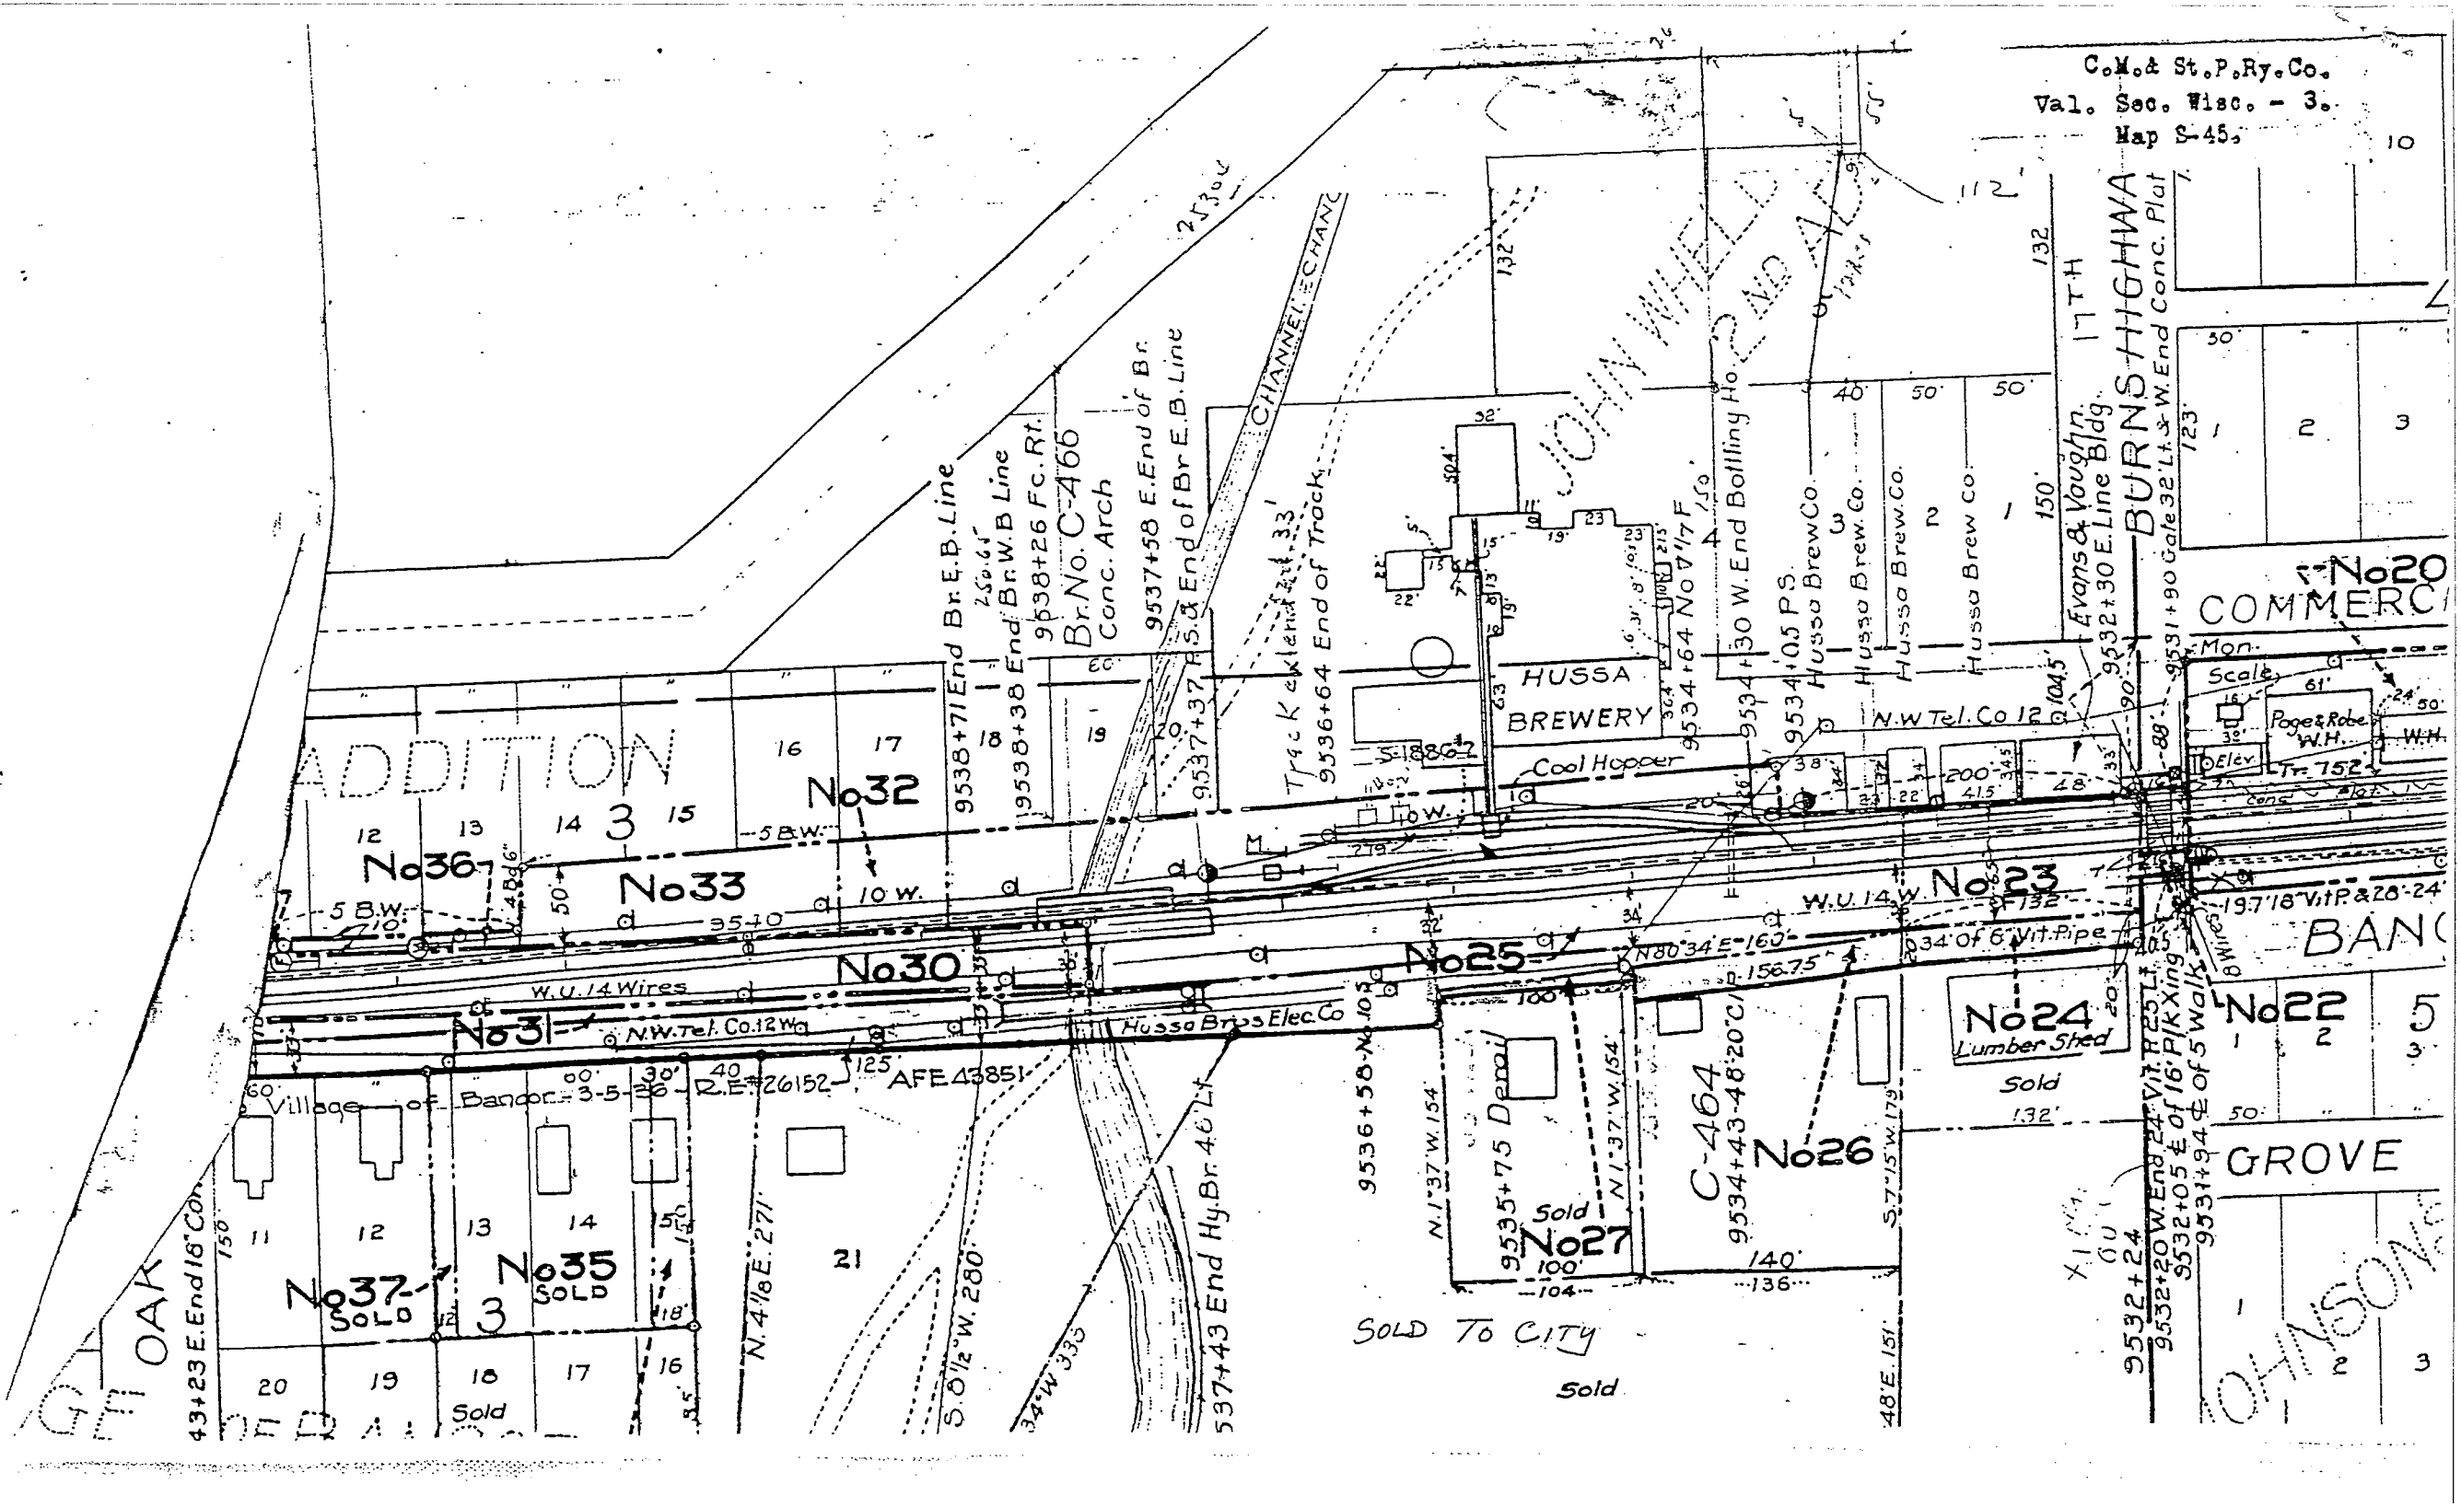
C.M.& St.P.Ry.Co.
Val. Sec. Wisc. - 3.
Map S-45.
ADDITION
No32
No33
No36
No30
No31
No25
No23
No24
No22
No26
No27
No35
No37
SOLD
Sold
HUSSA BREWERY
Cool Hopper
Hussa Brew Co.
Hussa Brew Co.
Hussa Brew Co.
Hussa Brew Co.
Evans & Vaughn
BURNS HIGHWA
COMMERC
BANC
GROVE
JOHN WHELD
2ND AE
17TH
CHANNEL CHANG
Br. No. C-466
Conc. Arch
Track Elevation 33'
Hussa Bros Elec. Co
N.W. Tel. Co. 12 W.
W.U. 14 Wires
Village of Bangor 3-5-36 R.E. #26152
AFE 43851
C-464
SOLD TO CITY
Sold
Lumber Shed
Page & Robe W.H.
Mon. Scale
Elev.
Tr. 752
OAK
JOHNSON