E. T. [illegible] INC.
(608) 784-4070
REGISTERED ENGINEERS AND LAND SURVEYORS
[illegible] MAIN STREET — LACROSSE, WISCONSIN

PLAT OF SURVEY

VB-30

PROPERTY OF BOB JOHNSON OIL. CO., INC.

DESCRIBED AS FOLLOWS: PART OF SW 1/4 - NW 1/4, SEC. 4, T. 16 N., R. 5 W., VILLAGE OF BANGOR, LA CROSSE COUNTY, WISCONSIN.

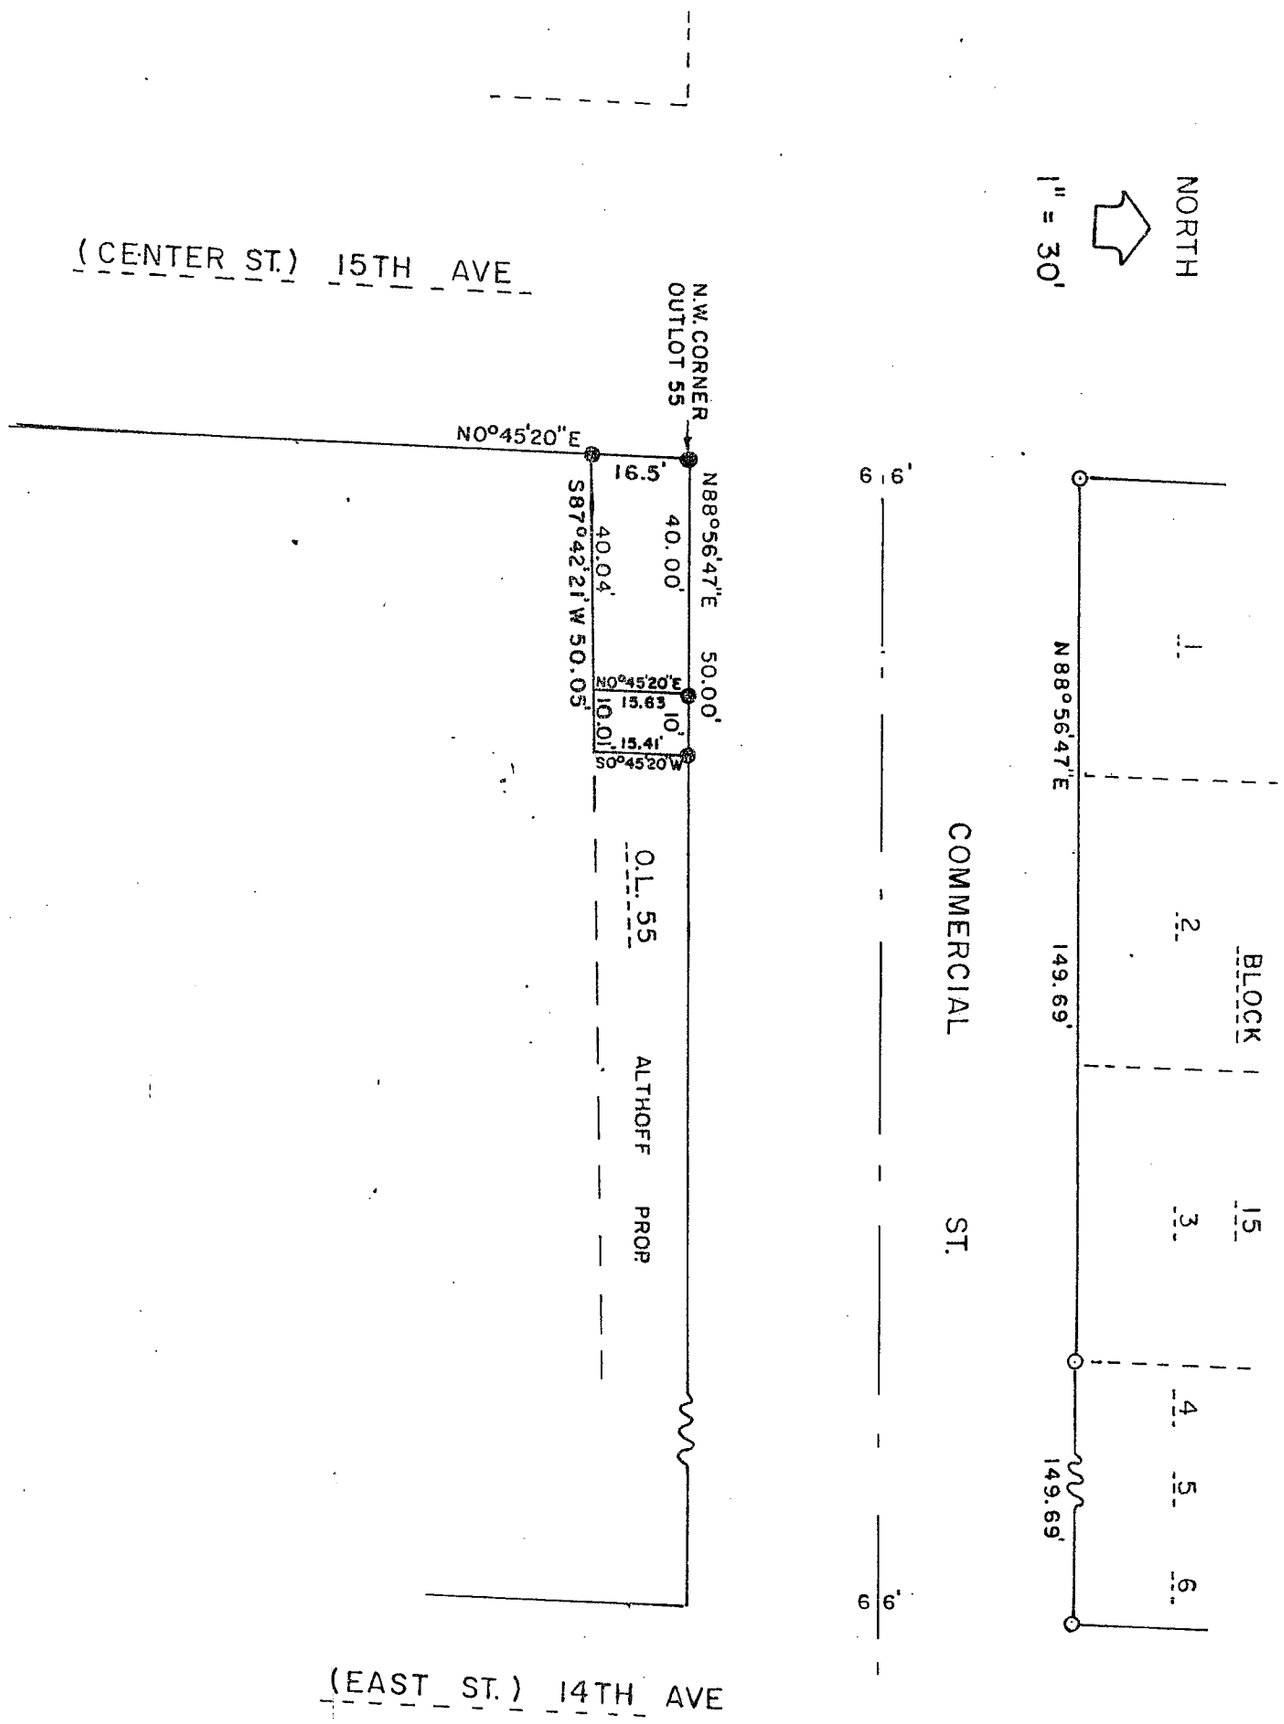

CERTIFICATE OF SURVEY

I HEREBY CERTIFY THAT ON DECEMBER 18, 19 89 I SURVEYED THE PROPERTY DESCRIBED ABOVE AND THAT THE ABOVE PLAT IS A CORRECT REPRESENTATION TO THE BEST OF MY KNOWLEDGE AND BELIEF.

REG. NO. S00675

SCALE: 1" INCH = 30 FEET
●-INDICATES IRON PIPE SET
○-INDICATES IRON PIPE FOUND
BK 498 PG 26 JOB NO. S768

905