VB-32

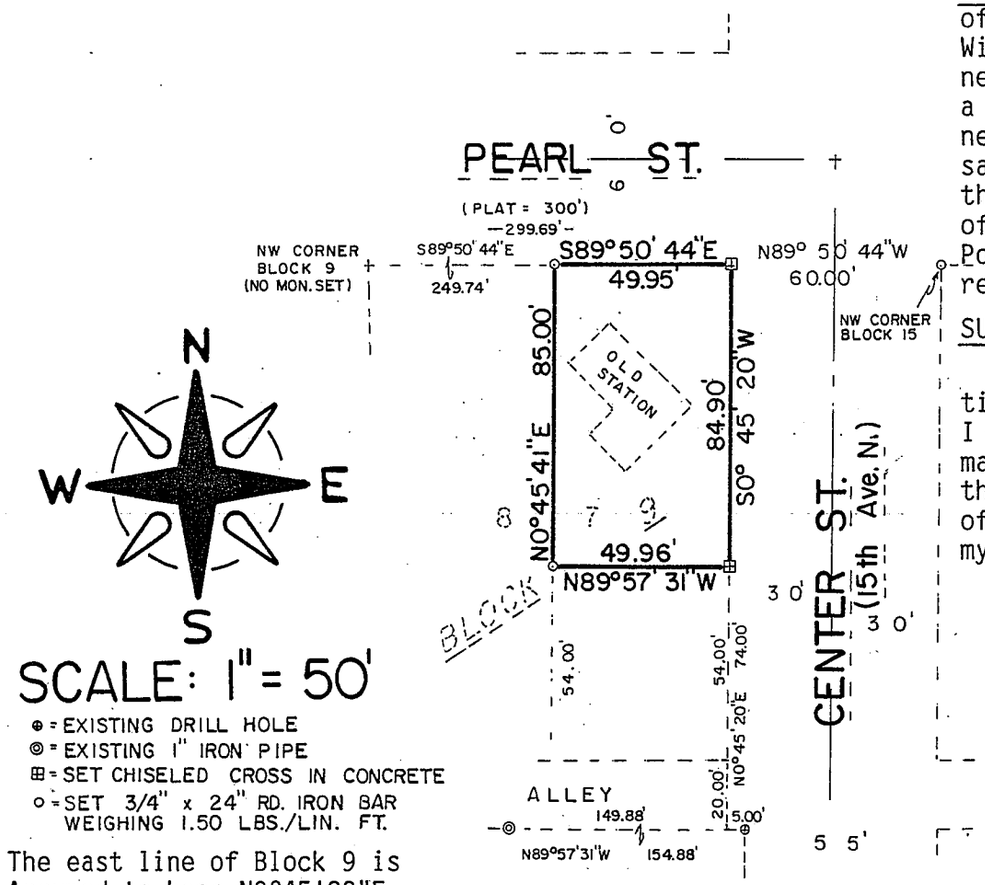

DESCRIPTION - Lot 7 of Block 9 of Johnson's Addition to the Village of Bangor, except the South 54 feet of said Lot 7, LaCrosse County, Wisconsin also described as follows: Beginning at the Northeast corner of said Lot 7; thence S0°45'20"W along the east line of said Lot 7, a distance of 84.90 feet to a point 54 feet north of the Southeast corner of said Lot 7; thence N89°57'31"W parallel with the south line of said Lot 7, a distance of 49.96 feet to the west line of said Lot 7; thence N0°45'41"E a distance of 85.00 feet to the Northwest corner of said Lot 7; thence S89°50'44"E, a distance of 49.95 feet to the Point of Beginning. Subject to all easements and right-of-ways of record.

SURVEYOR'S CERTIFICATE

I, Garold A. Sime, being a duly qualified Surveyor do hereby certify that by the order and under the direction of Mr. Gregory Peterson I have surveyed and mapped the property described and that the within map is a true and correct representation of the exterior boundaries of the land surveyed and that I have fully complied with the provisions of Chapter AE - 7 of the Wisconsin Administrative Code to the best of my knowledge and belief.

Garold A. Sime

GAROLD A. SIME, REGISTERED LAND SURVEYOR S-1261
H. A. SIME & ASSOCIATES
P. O. BOX 705
TOMAH, WISCONSIN 54660
August 28th, 1992

WISCONSIN
G. A. Sime
GAROLD A. SIME
28-92
S-1261
TOMAH, WIS.
LAND SURVEYOR

COPY

PLAT OF SURVEY

Located in Lot 7, Block 9 of Johnson's Addition to the Village of Bangor, LaCrosse County, WI

4192