Village Bangor
NE-SW 4-16-5 VB-42

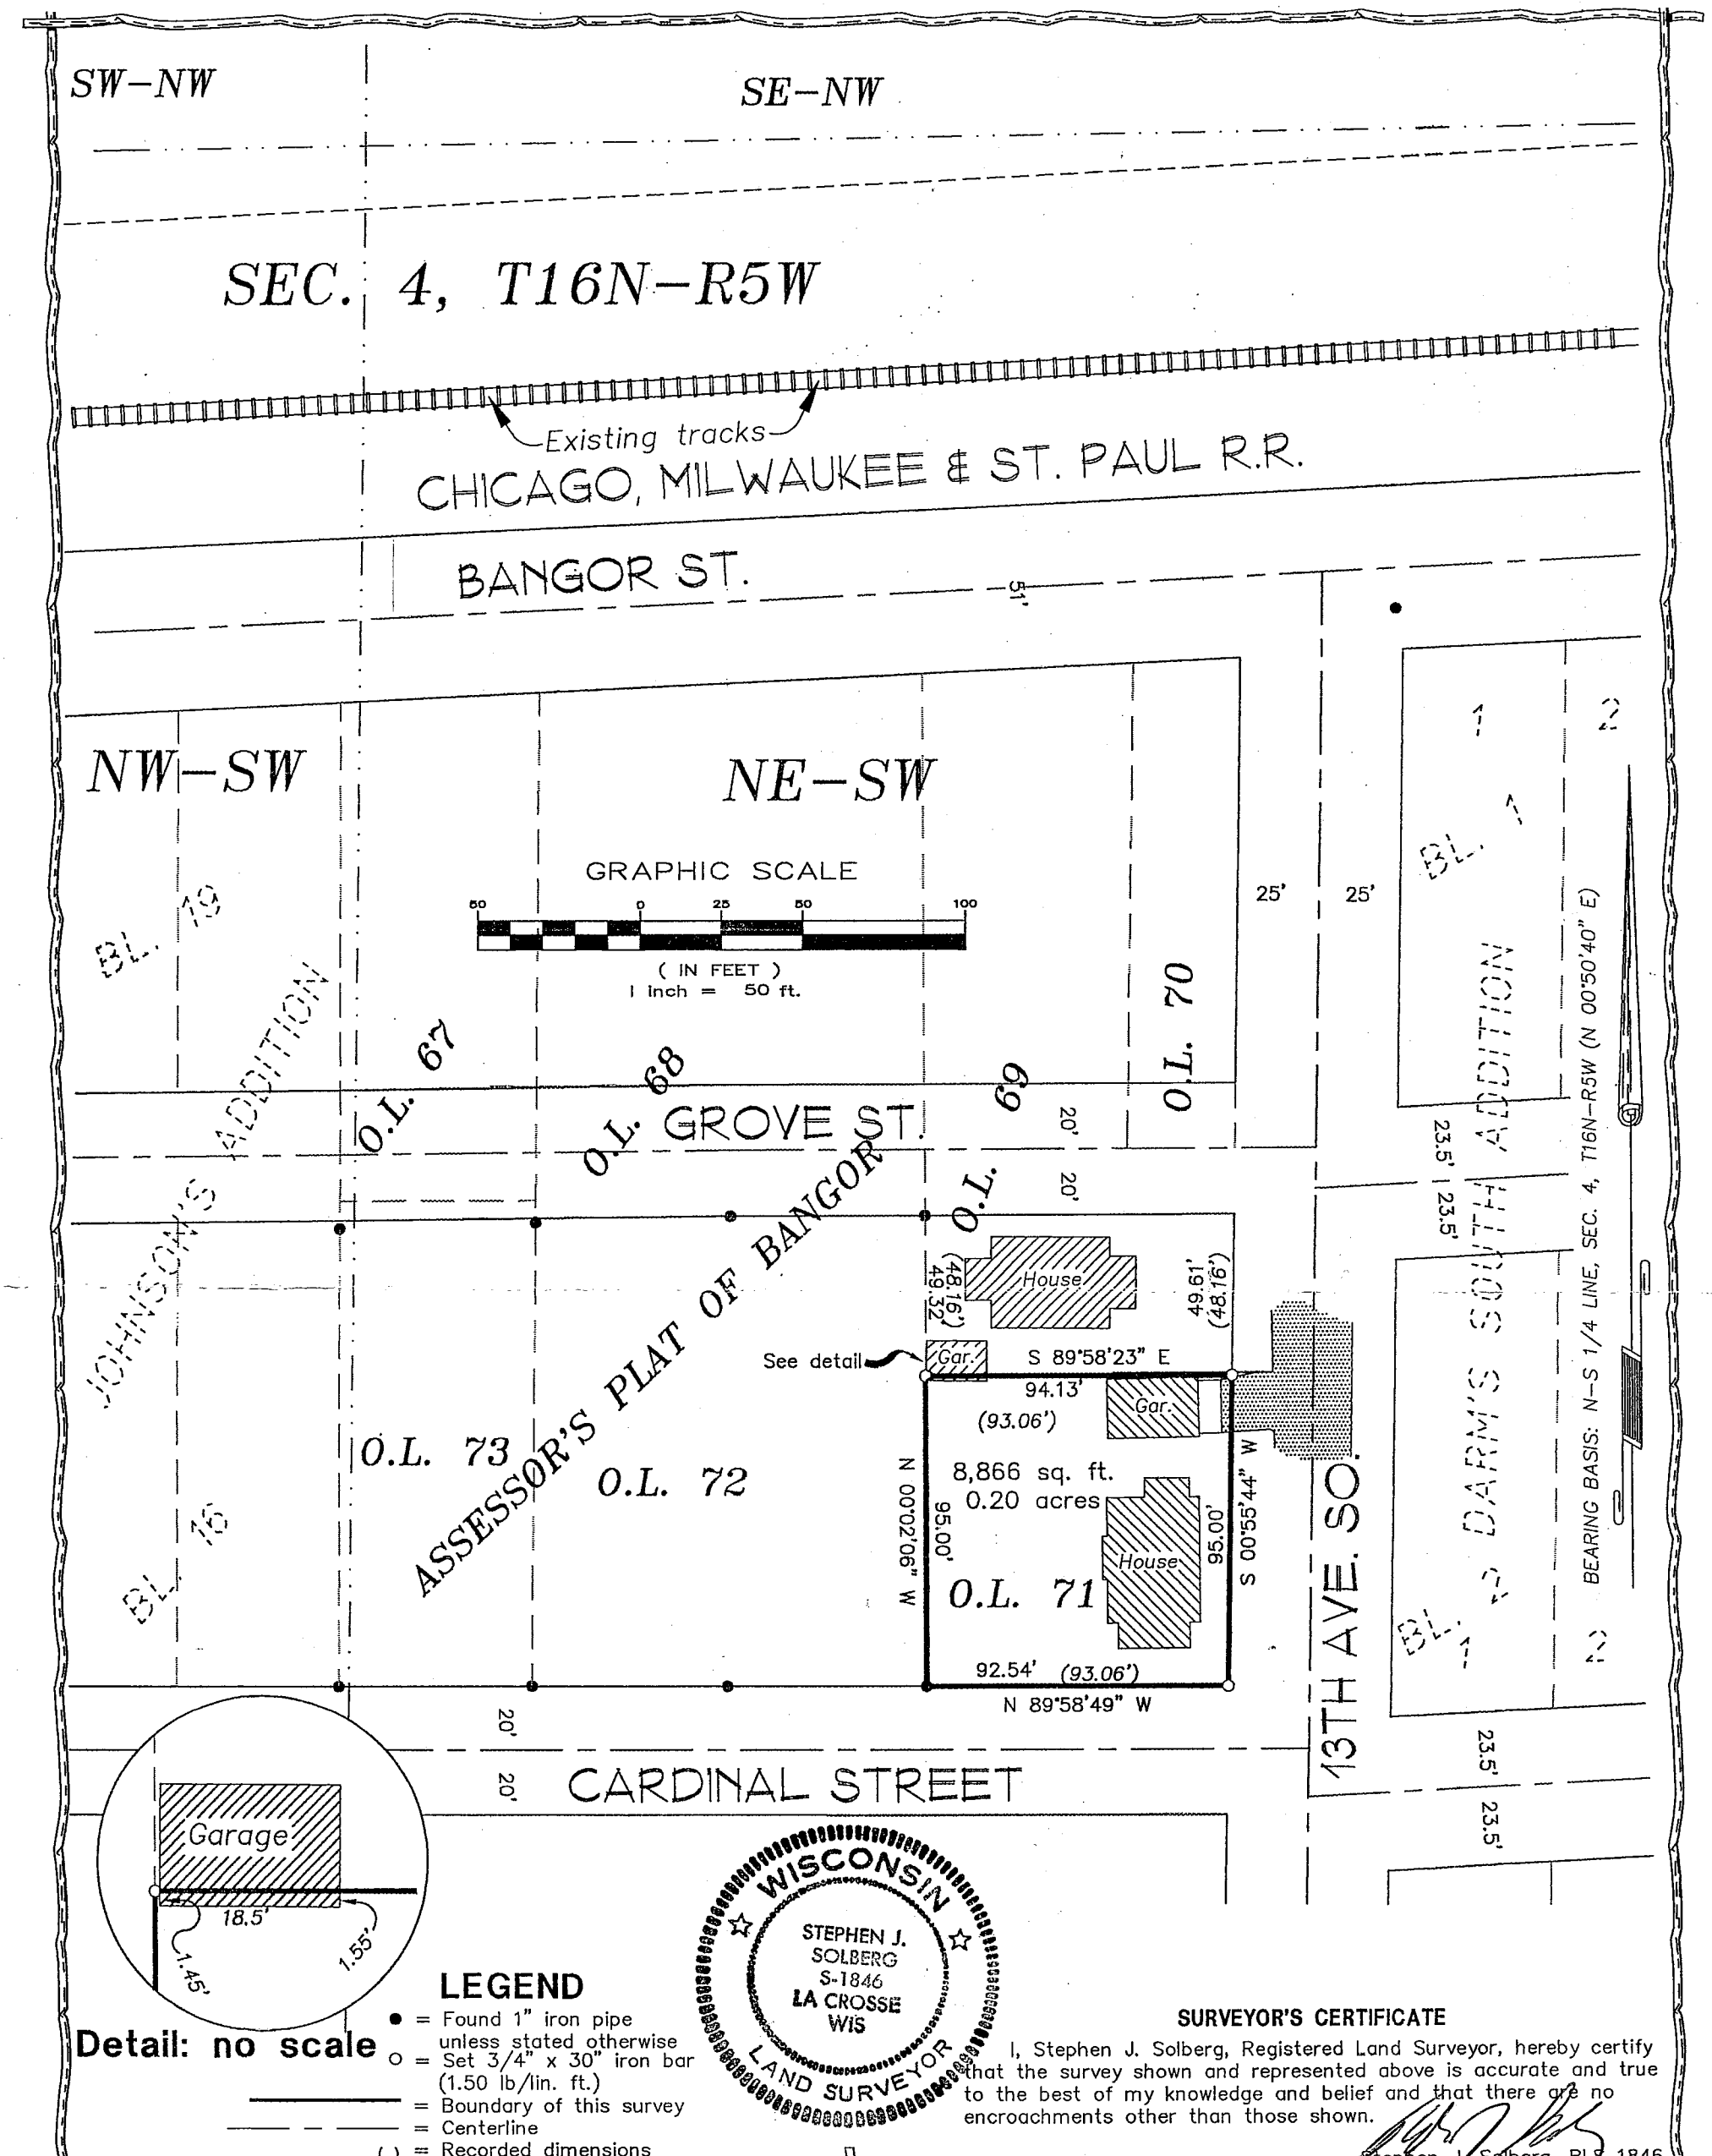

LEGEND

- ● = Found 1" iron pipe unless stated otherwise
- o = Set 3/4" x 30" iron bar (1.50 lb/lin. ft.)
- ——— = Boundary of this survey
- — — — = Centerline
- ( ) = Recorded dimensions

SURVEYOR'S CERTIFICATE

I, Stephen J. Solberg, Registered Land Surveyor, hereby certify that the survey shown and represented above is accurate and true to the best of my knowledge and belief and that there are no encroachments other than those shown.

Stephen J. Solberg, RLS 1846

SURVEY FOR

JULIE JOLIVETTE

O.L. 71, ASSESSOR'S PLAT OF BANGOR
NE 1/4 - SW 1/4, SEC. 4, T16N-R5W
VILLAGE OF BANGOR, LA CROSSE CO.
1304 CARDINAL ST., BANGOR, WI.

DRAWN BY:	DATE:
SJS	9-2-97
REVISED BY:	DATE:
SCALE: 1" = 50'	

SHEET 1 OF 1 | PROJECT NO.: 4099 | FB NO.:

SOLBERG GEOGRAPHICS INCORPORATED
507 Main Street - P.O. Box 1235
La Crosse, Wisconsin 54601
Ph (608)784-1614 Fx (608)784-1408