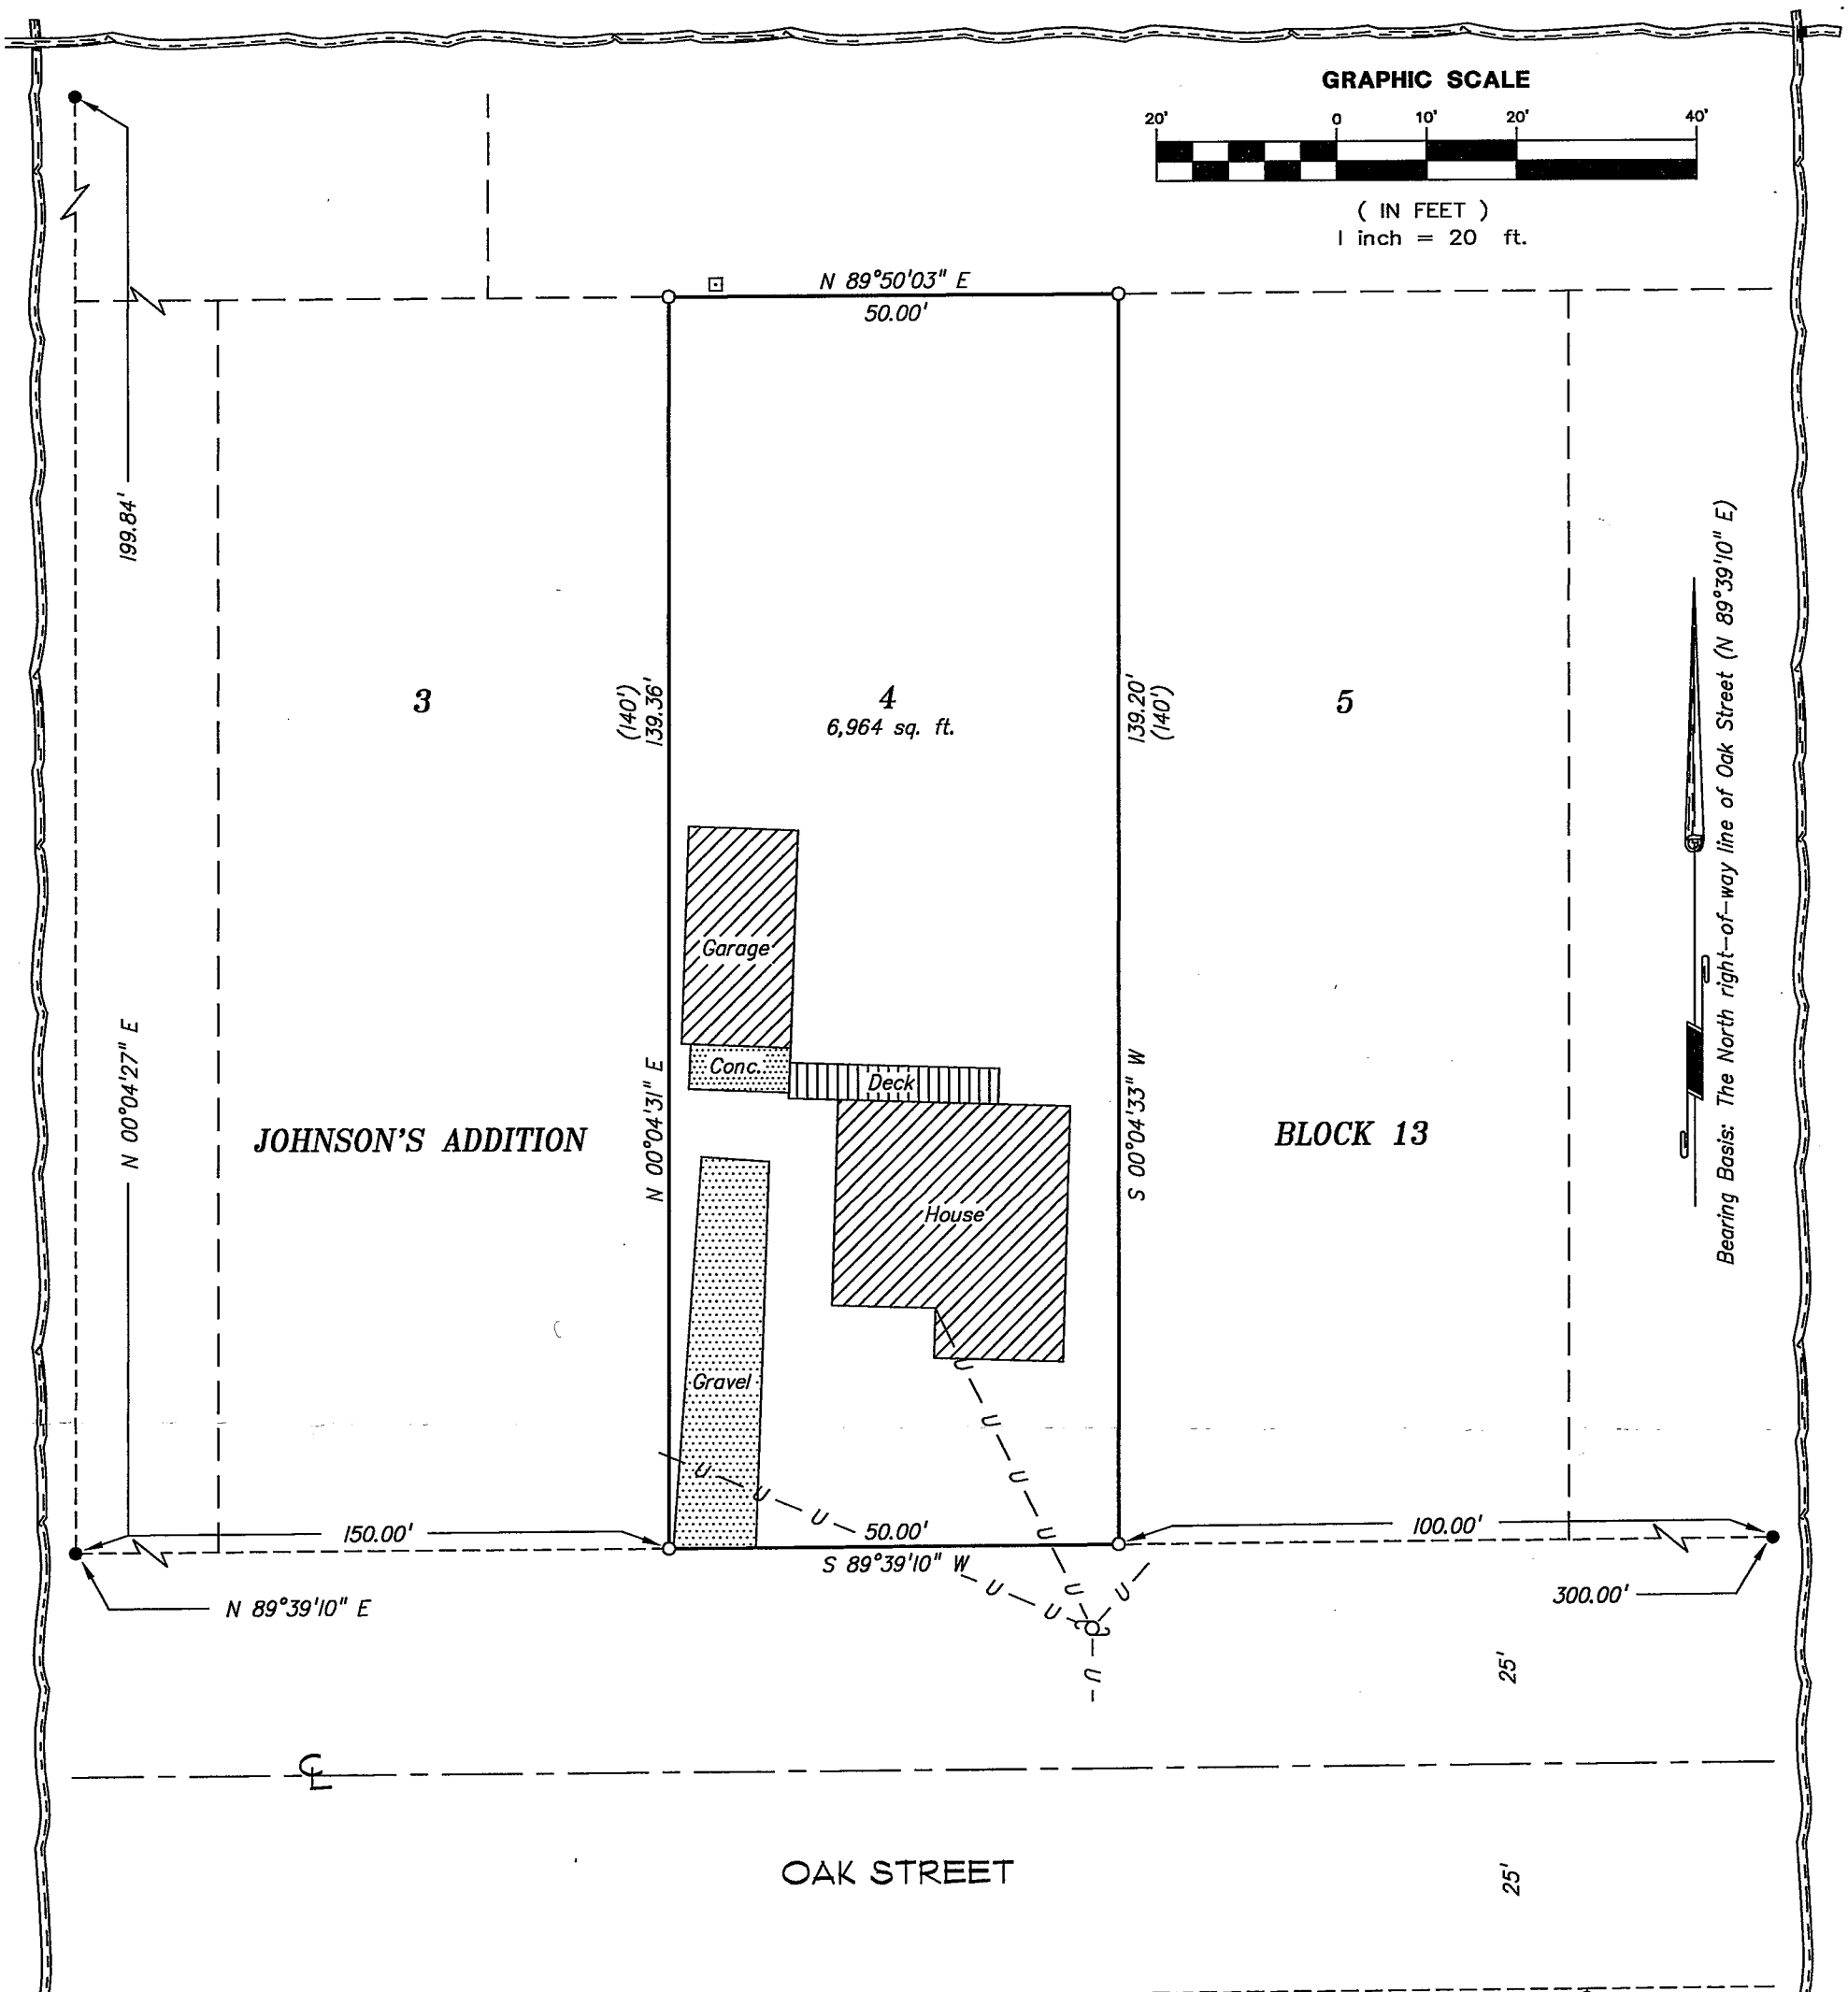

LEGEND

- ● = Found 1" Iron Pipe (unless stated otherwise)
- ○ = Set 3/4" X 30" Iron Bar (1.50 lb/lin. ft.)
- = Utility Pole
- ⊡ = Telephone Pedestal
- ( ) = Recorded dimensions
- = Boundary of this survey
- = Centerline
- —U—U— = Utility lines

WISCONSIN
1/10/05
CHRISTOPHER W. FECHNER
S-2448
LA CROSSE, WISCONSIN
LAND SURVEYOR

SURVEYOR'S CERTIFICATE

I, Christopher W. Fechner, Registered Land Surveyor, hereby certify that the survey shown and represented above is accurate and true to the best of my knowledge and belief and that there are no encroachments other than those shown.

Christopher W. Fechner RLS 2448

SURVEY FOR

ARLAN SCHMIDT

LOT 4, BLOCK 13
JOHNSON'S ADDITION
VILLAGE OF BANGOR, LACROSSE CO. WI
1412 OAK STREET

DRAWN BY:	DATE:
JS	1-10-05
REVISED BY:	DATE:
SCALE: 1" = 20'	

SHEET 1 OF 1	PROJECT NO.: S-5148A	FIELD CREW: JS-KK

COULEE REGION LAND SURVEYORS, INC.
917 SO. 4TH STREET - P.O. BOX 1954
LA CROSSE, WISCONSIN 54601
PHONE (608) 784-1614 FAX (608) 784-1408

VB-64