RECEIVED
SEP 10 2007
COUNTY SURVEYOR'S OFFICE

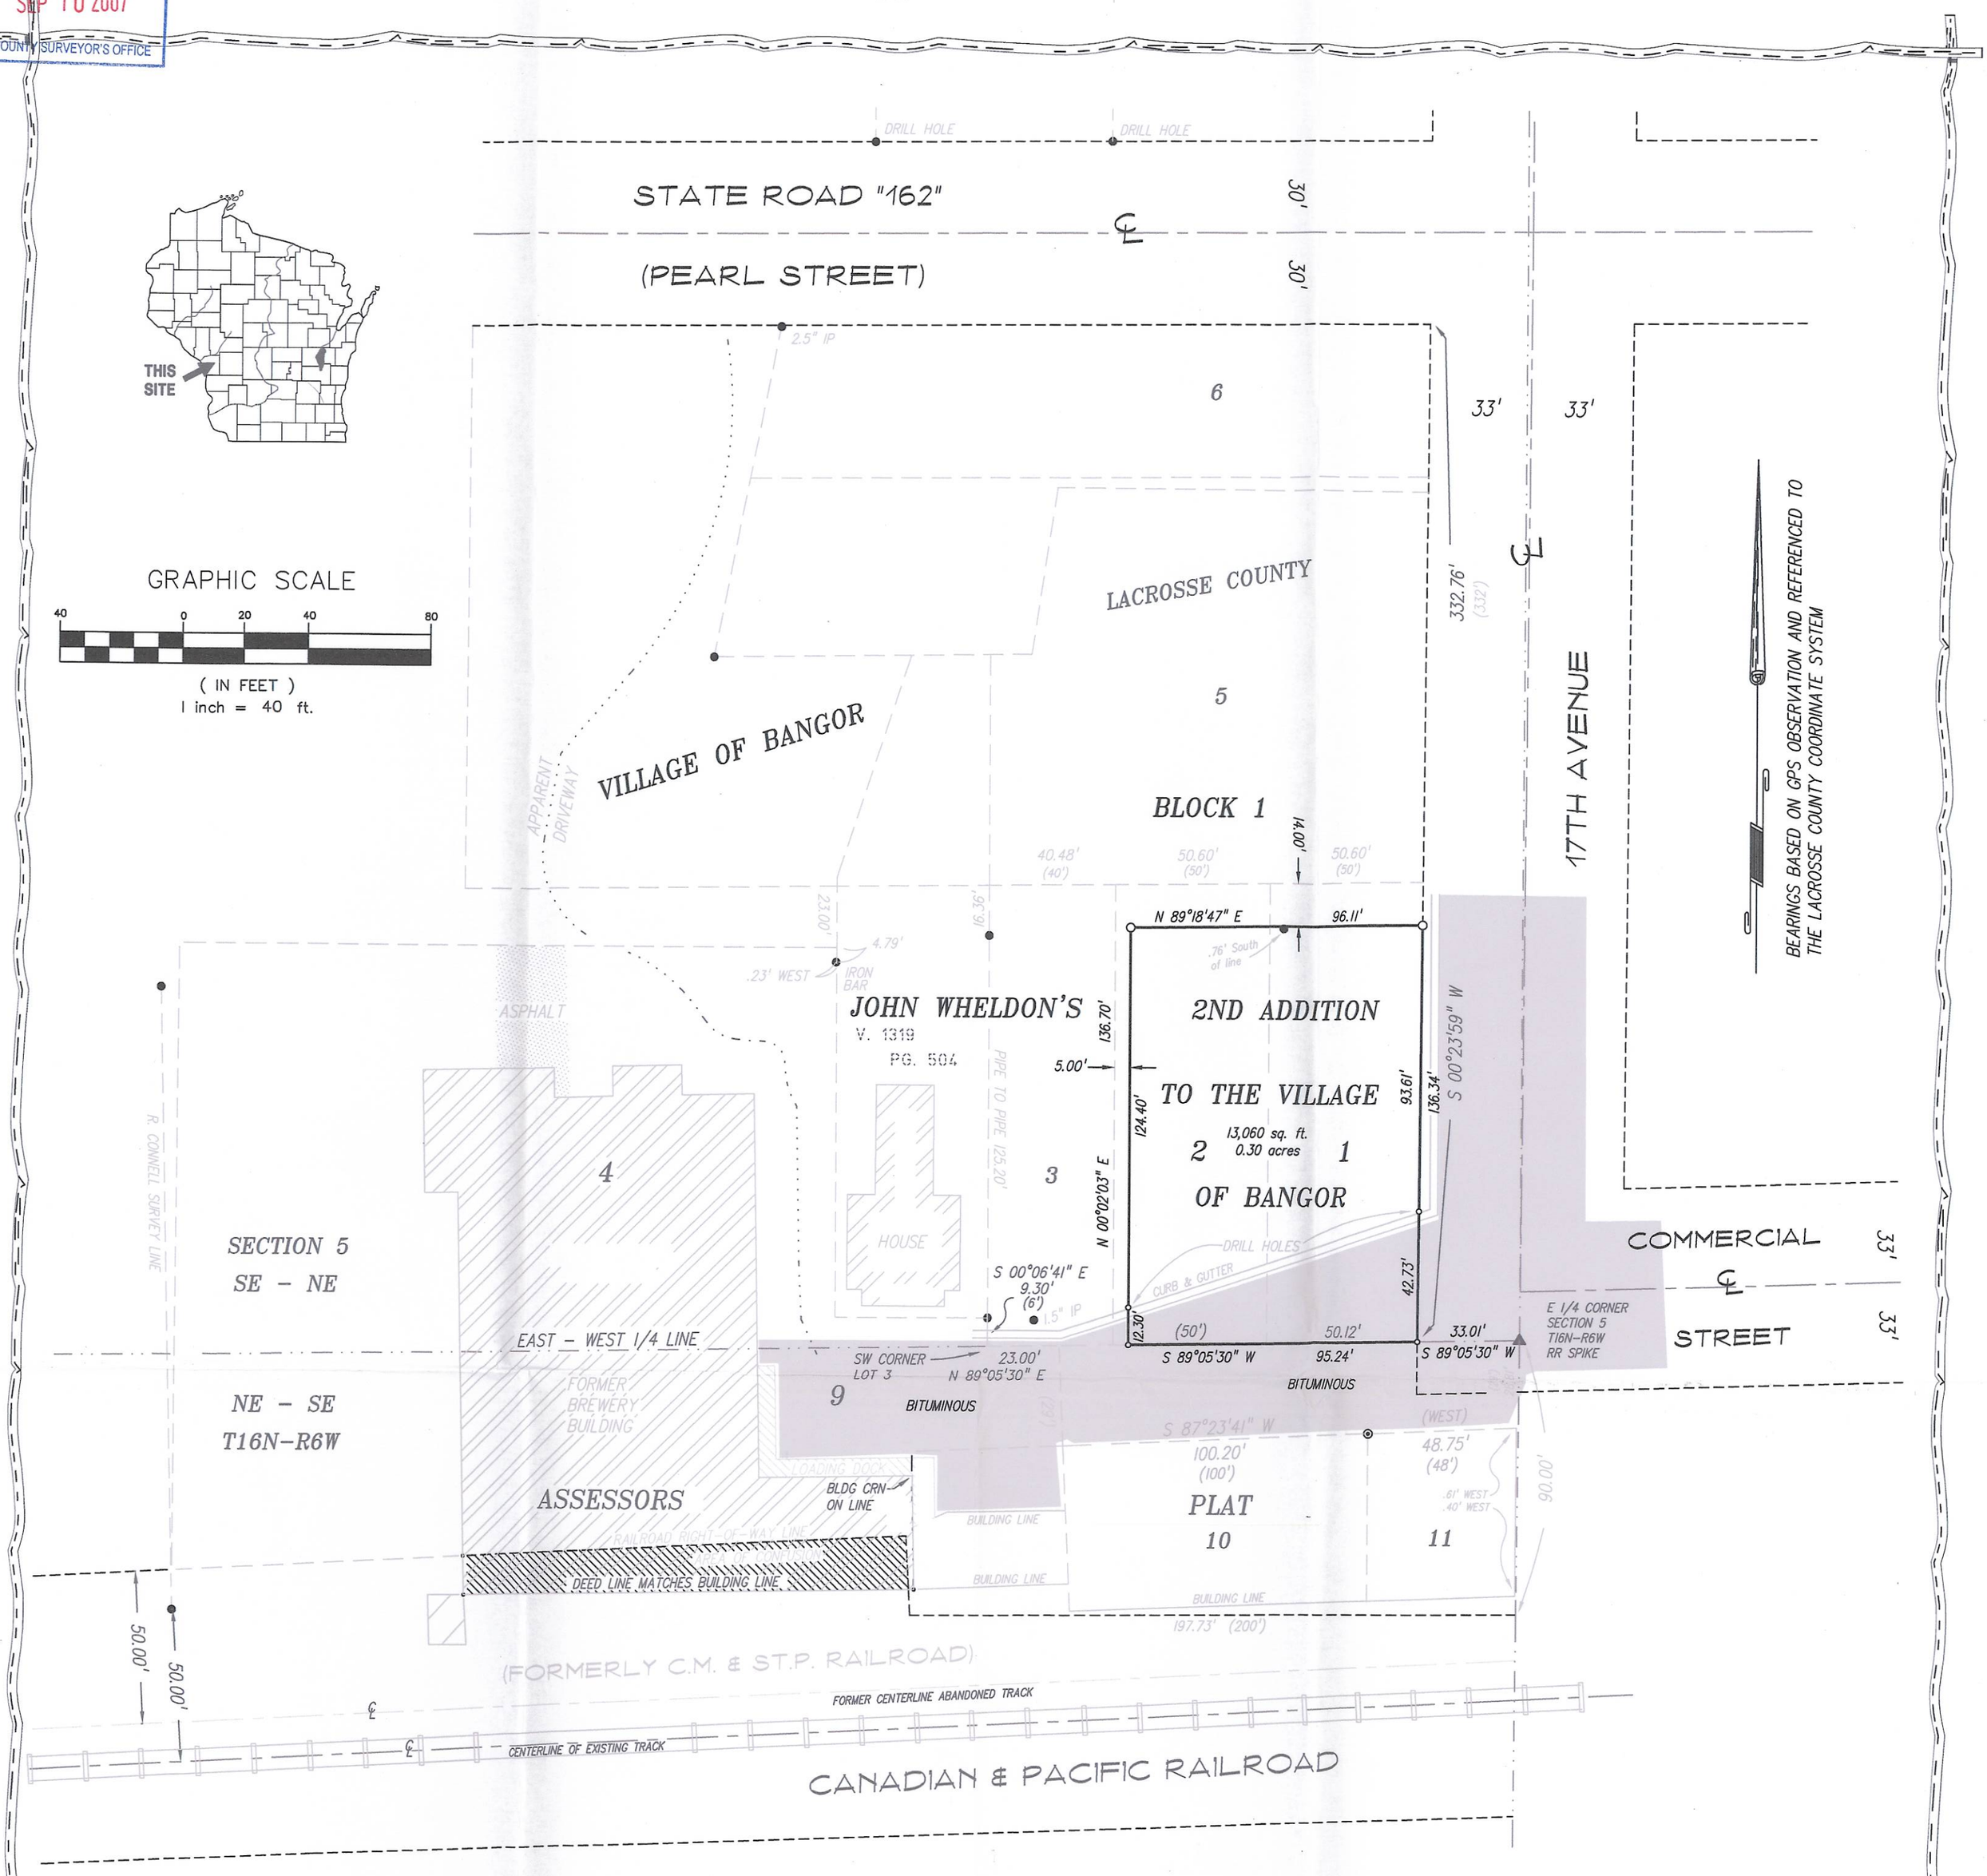

WISCONSIN
8/13/07
CHRISTOPHER W. FECHNER
S-2448
LA CROSSE, WISCONSIN
LAND SURVEYOR

SURVEYOR'S DESCRIPTION

Lots 1 & 2, John Wheldon's Second Addition to the Village of Bangor, Village of Bangor, La Crosse County, Wisconsin. Except the West 5.00 feet of Lot 2; also excepting the North 14.00 feet of Lots 1 & 2.

LEGEND

- ● = Found 1" Iron Pipe (unless stated otherwise)
- ⊙ = Building corner at Property corner
- ○ = Set 3/4" x 24" Iron Bar (1.50 lb/lin. ft.)
- ( ) = Recorded dimensions
- • = Found MAG nail
- ∘ = Set MAG nail
- ⊕ = Found County marker
- ——— = Boundary of this survey
- — – — = Centerline
- —U—U— = Utility lines
- —x—x— = Fence line

SURVEYOR'S CERTIFICATE

I, Christopher W. Fechner, Registered Land Surveyor, hereby certify that the survey shown and represented above is accurate and true to the best of my knowledge and belief and that there are no encroachments other than those shown.

Christopher W. Fechner RLS 2448

SURVEY FOR

BANGOR FIRST RESPONDERS

PART OF LOTS 1 & 2 JOHN WHELDON'S SECOND ADDITION BANGOR, WI. 54614 COMMERCIAL STREET	DRAWN BY: CF KK	DATE: 8/13/2007
	REVISED BY:	DATE:
	SCALE: 1" = 40	
SHEET 1 OF 1	PROJECT NO.: P-5224B	CREW: KK ZD

PLAT OF SURVEY
FOR
BANGOR FIRST RESPONDERS
JOHN WHELDON'S SECOND ADDN.

COULEE REGION LAND SURVEYORS, INC.
917 SO. 4TH STREET - P.O. BOX 1954
LA CROSSE, WISCONSIN 54601
PHONE (608) 784-1614 FAX (608) 784-1408

VB-74