VB-75 (SW-NW & NW-SW, 4-16-5)

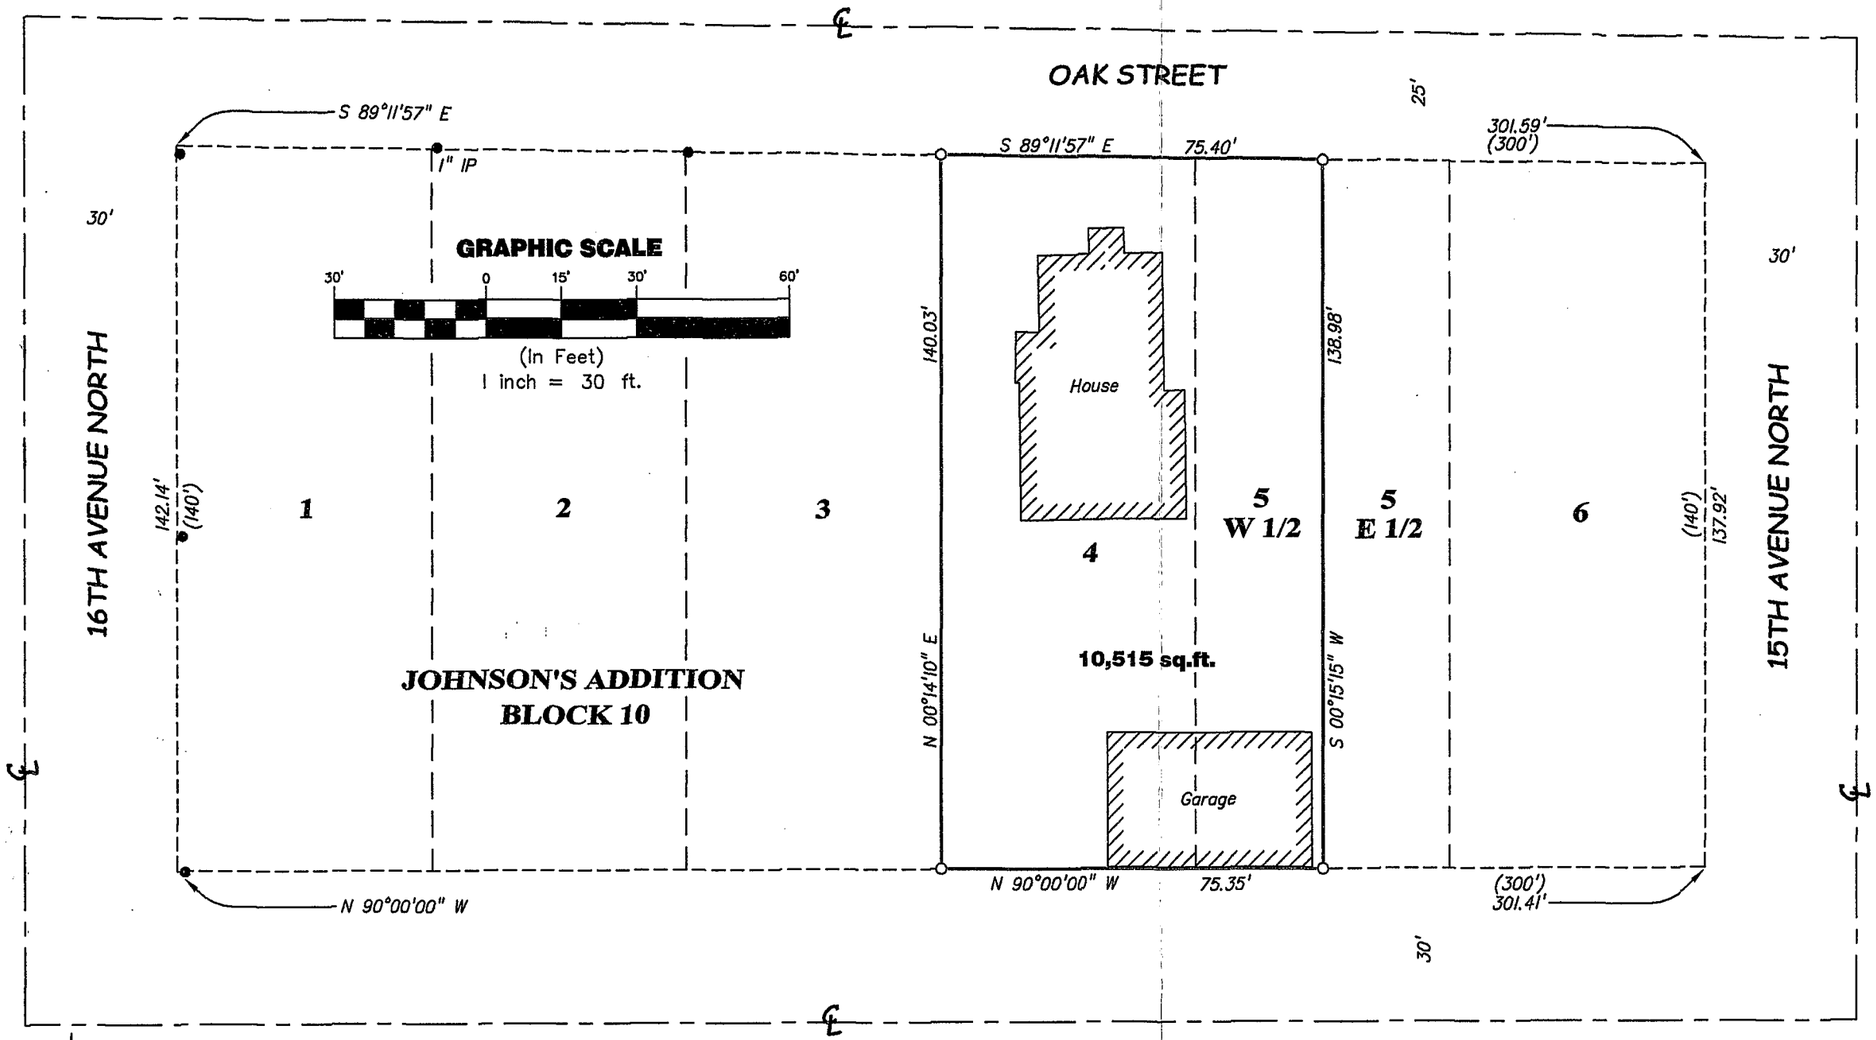

Bearing Basis: The North right-of-way line of Pearl Street assumed N 90°00'00" W

LEGEND

- ● = Found 3/4" Iron Bar (unless stated otherwise)
- O = Set 3/4" x 24" Iron bar (1.50 lb/lin. ft.)
- ( ) = Recorded dimensions
- ——— = Boundary of this survey
- — - — = Centerline
- —U—U— = Utility lines

SURVEYOR'S CERTIFICATE

I, Michael J. Harding, Registered Land Surveyor, hereby certify that the survey shown and represented above is accurate and true to the best of my knowledge and belief and that there are no visible encroachments other than those shown.

Michael J. Harding, RLS 2296

WISCONSIN
MICHAEL J. HARDING
S-2296
LA CROSSE
WIS
6-5-8
LAND SURVEYOR

COULEE REGION LAND SURVEYORS, INC.
917 SO. 4TH STREET - P.O. BOX 1954
LA CROSSE, WISCONSIN 54601
PHONE (608) 784-1614 FAX (608) 784-1408

RECEIVED
JUN 23 2008
COUNTY SURVEYOR'S OFFICE

SURVEY FOR
Eric Faas

Lot 4 and West 1/2 of Lot 5 in Block 10
JOHNSON'S ADDITION
VILLAGE OF BANGOR, LA CROSSE CO. WI
1507 OAK STREET

DRAWN BY: MH	DATE: 6/5/08
REVISED BY:	DATE:
SCALE: 1" = 30'	FIELD CREW: TS, BH
PROJECT NO.: S-5148B	SHEET 1 OF 1