E.T.C., INC. REGISTERED ERS AND LAND SURVEYORS

(608) 784-4070 320 MAIN STREET — LACROSSE, WISCONSIN

PLAT OF SURVEY VB-8

PROPERTY OF LILLIAM MAY MENGEL

DESCRIBED AS FOLLOWS: PART OF OUTLOT 17 OF THE ASSESSOR'S PLAT, VILLAGE OF BANGOR, LA CROSSE COUNTY, WISCONSIN

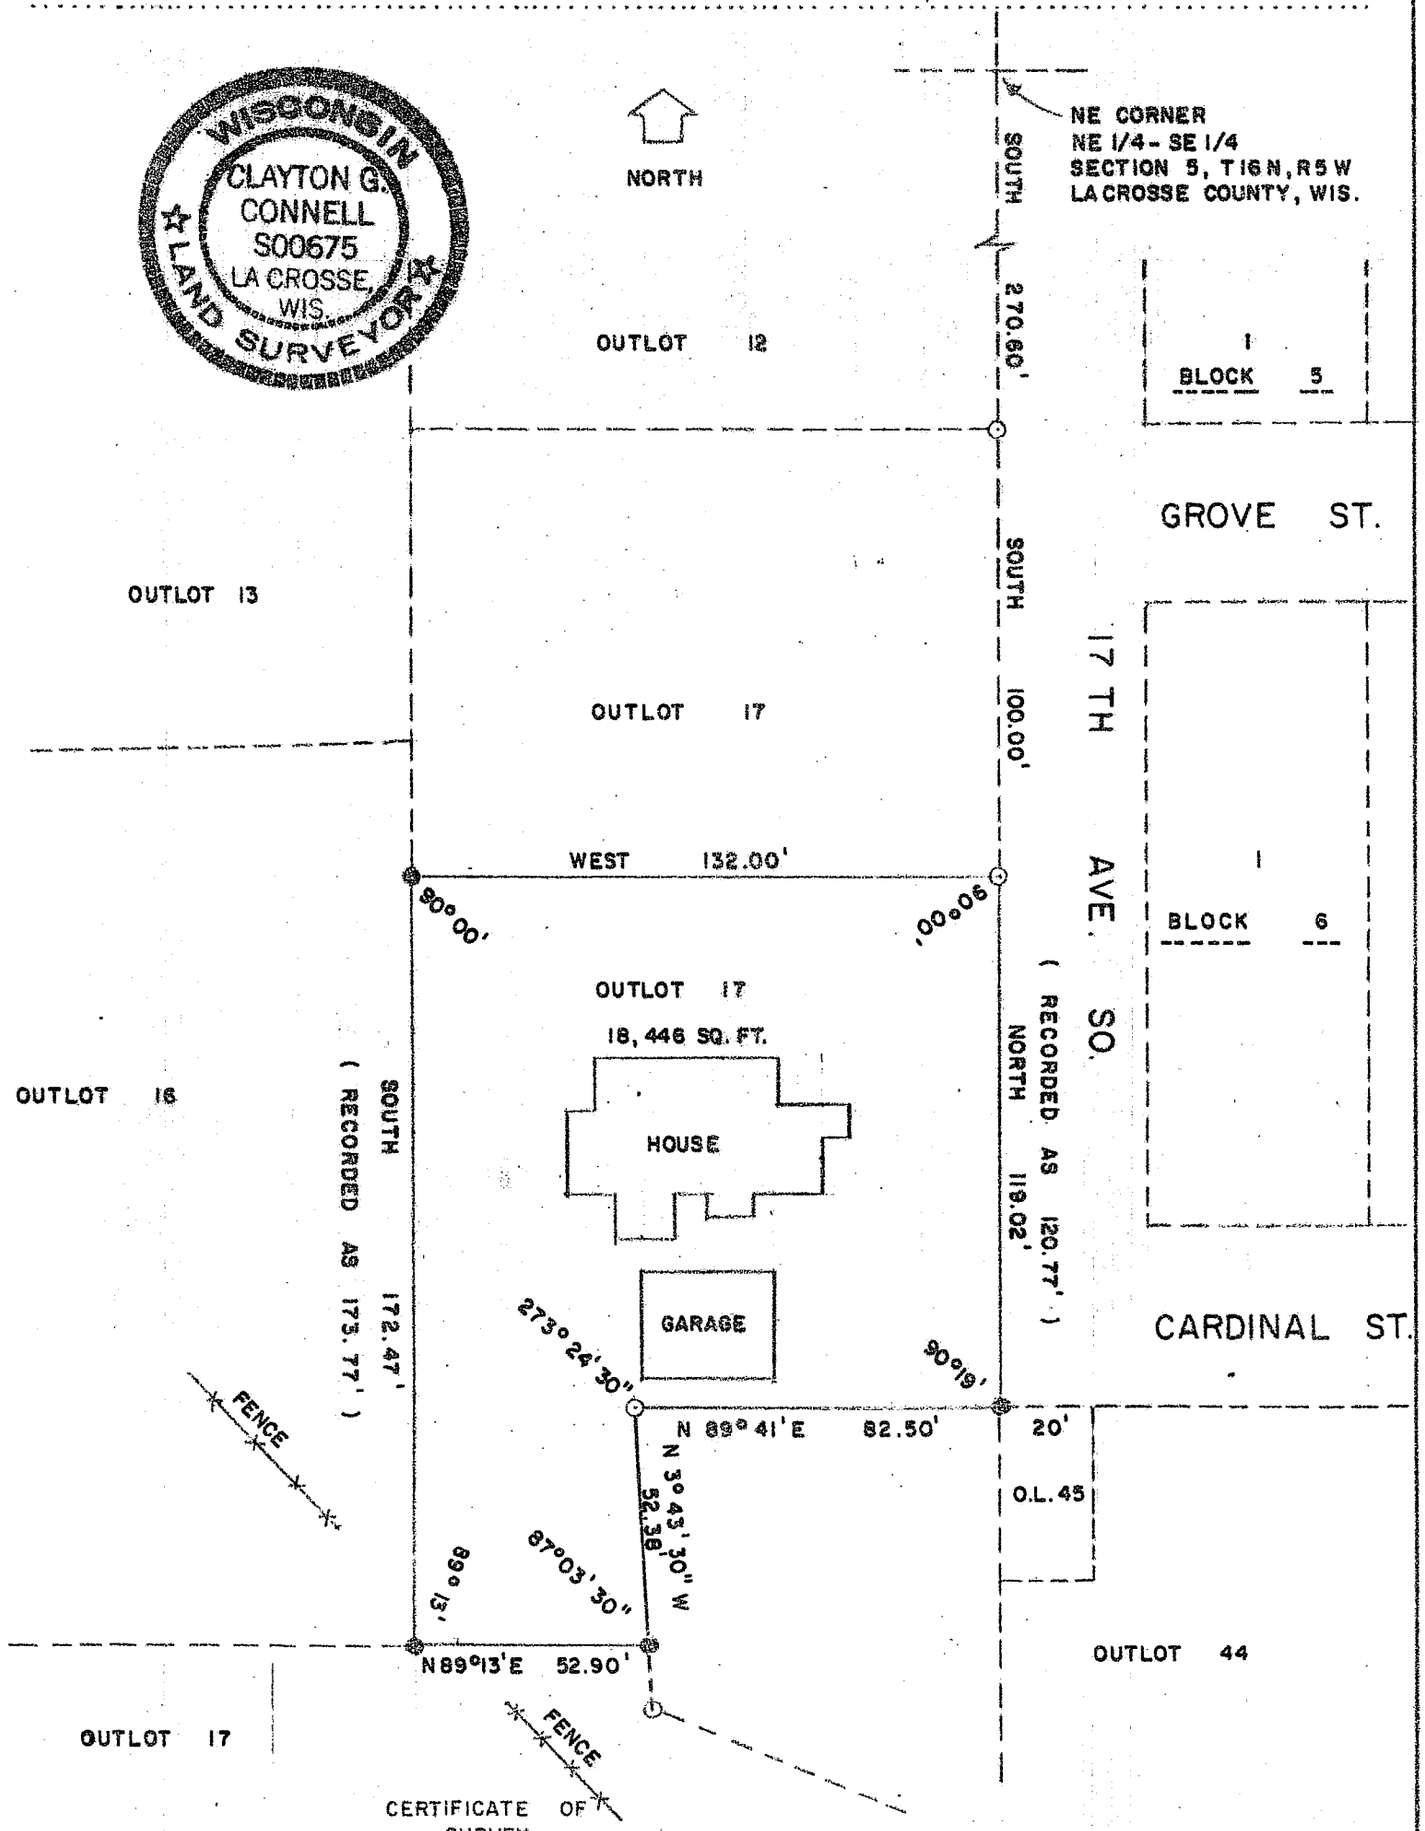

CERTIFICATE OF SURVEY

I HEREBY CERTIFY THAT ON JULY 21, 1983 I SURVEYED THE PROPERTY DESCRIBED ABOVE AND THAT THE ABOVE PLAT IS A CORRECT REPRESENTATION TO THE BEST OF MY KNOWLEDGE AND BELIEF.

Clayton G. Connell REG. NO. S00675

SCALE: 1" INCH 40 FEET

●- INDICATES IRON PIPE SET

○- INDICATES IRON PIPE FOUND

BK. 49A PG. 46 JOB NO. 9486