VB-82

Boundary Line Survey

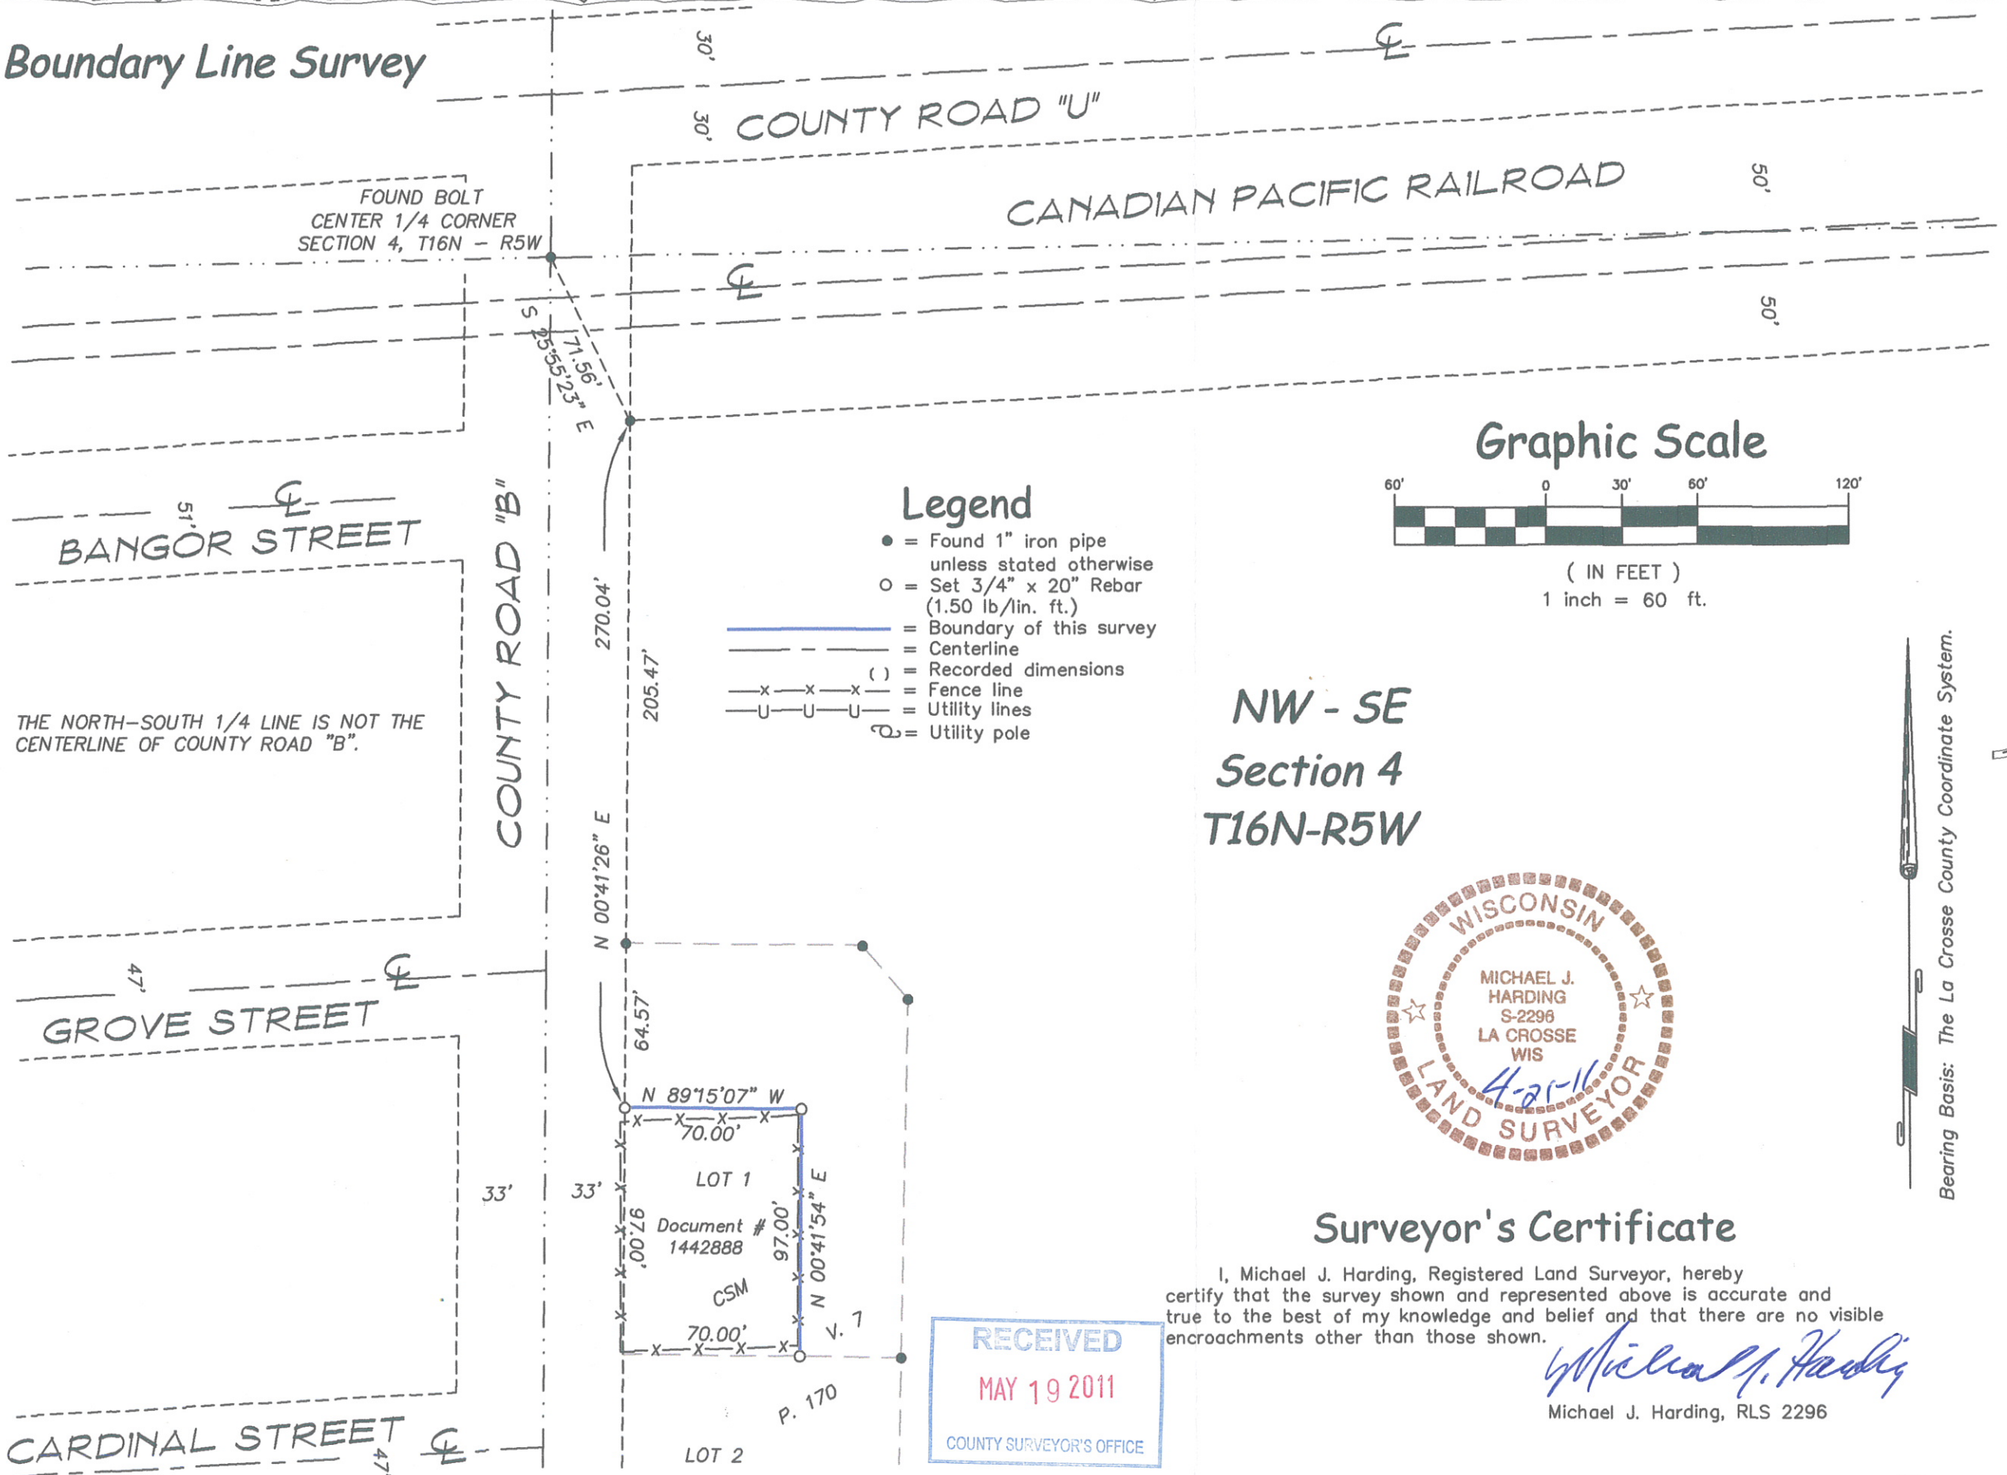

Legend

- ● = Found 1" iron pipe unless stated otherwise
- O = Set 3/4" x 20" Rebar (1.50 lb/lin. ft.)
- = Boundary of this survey
- = Centerline
- ( ) = Recorded dimensions
- —x—x—x— = Fence line
- —U—U—U— = Utility lines
- = Utility pole

Graphic Scale

60' 0 30' 60' 120'

(IN FEET)
1 inch = 60 ft.

NW - SE
Section 4
T16N-R5W

WISCONSIN
MICHAEL J. HARDING
S-2296
LA CROSSE
WIS
4-21-11
LAND SURVEYOR

Bearing Basis: The La Crosse County Coordinate System.

Surveyor's Certificate

I, Michael J. Harding, Registered Land Surveyor, hereby certify that the survey shown and represented above is accurate and true to the best of my knowledge and belief and that there are no visible encroachments other than those shown.

Michael J. Harding

Michael J. Harding, RLS 2296

RECEIVED
MAY 19 2011
COUNTY SURVEYOR'S OFFICE

Coulee Region Land Surveyors
917 SOUTH 4TH STREET - P.O. BOX 1954
LA CROSSE, WISCONSIN 54601
PHONE (608) 784-1614 FAX (608) 784-1408
www.couleeregionlandsurveyors.com

SURVEY FOR
John Molstad (MOL-CO, INC.)

Part of the NW 1/4 - SE 1/4
Section 4, T16N-R5W
Village of Bangor, La Crosse County, Wisconsin
County Road "B"

DRAWN BY: MH	DATE: 4-21-2011
REVISED BY:	DATE:
SCALE: 1" = 60'	FIELD CREW: MH RC TS
PROJECT NO.: S-4482AA	SHEET 1 OF 1