R-16

MORTGAGE SURVEY

DANIEL & JULIE BROOKS
406 DOVE ST.
LOT 4 BLOCK 4 HUMMIGBIRD
HEIGHTS ADDITION ROCKLAND, WIS.

FOR: VALLEY BANK WESTERN
SPARTA, WIS.

5/28/93

MAXWELL SURVEYING

122 Tower Street, Sparta, WI 54656
608-269-1664

Rodney Maxwell

JOB NO. 93-04-22

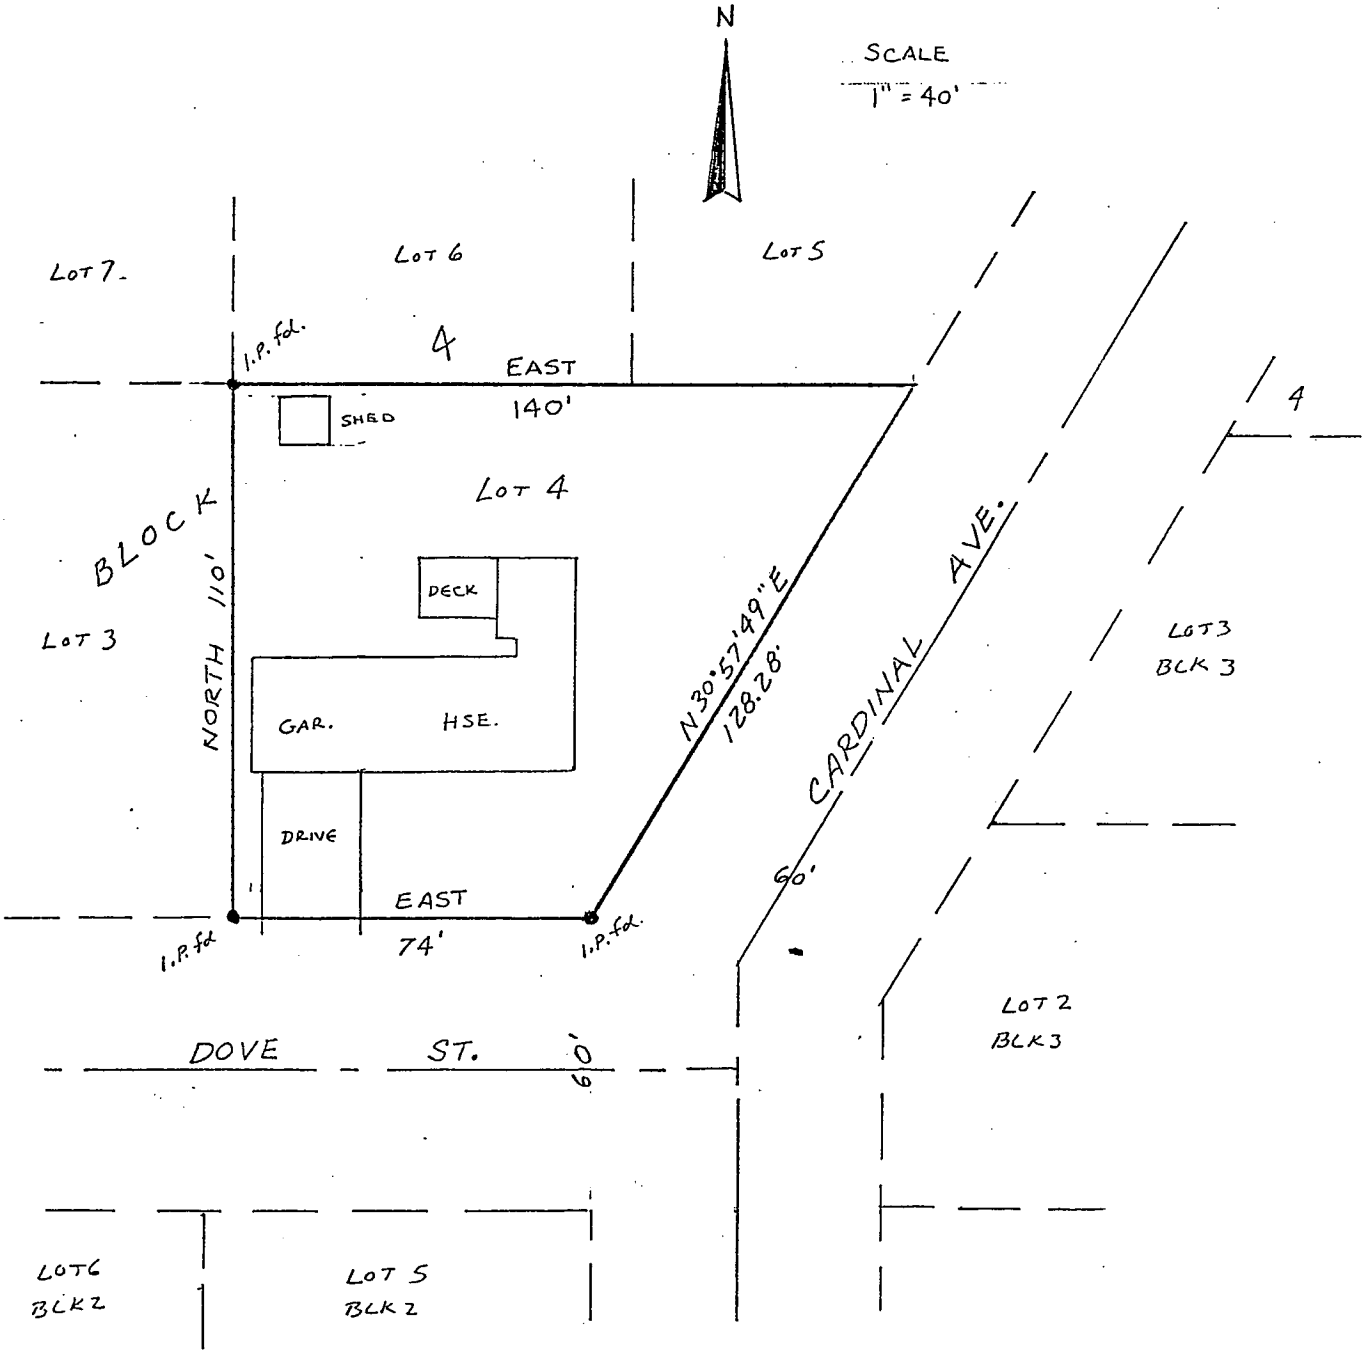

All Your Survey Needs • Land Development Planning • Erosion Control Plans

MORTGAGE SURVEY, page 2 of 2

RODNEY H. MAXWELL, Registered Land Surveyor, and

VALLEY BANK WESTERN, SPARTA, WIS.,

hereby agree that in the performance of this Mortgage Survey

OF BROOKS PROPERTY, 406 DOVE ST., LOT 4, BLOCK 4,

HUMMINGBIRD HEIGHTS ADDITION, ROCKLAND, WIS.,

the following work is excluded from the requirements of the Minimum Standards for Property Surveys established by A-E7 of the Wisconsin Administrative Code:

1) Boundary Location: No traversing between monuments has been made other than rough measurements. No monuments have been set.

2) Descriptions: Description is as recorded on deed. All bearings and distances shown are recorded.

3) Mapping: Not referenced as provided in s.59.61 Stats. Does not show bearing and distances to related monuments other than recorded bearings and distances.

   Is not stamped or signed by the surveyor and is not certified that the survey is correct to the best of the surveyor's knowledge and belief.

4) Measurements: Have not been made with instruments or methods capable of attaining any required accuracy. No accuracy of measurements has been made by horizontal or angular monument. Bearings and distances are recorded.

RELEASE

Maxwell Surveying is released from all responsibility in the preparation of this Mortgage Survey.

Dated this 28TH day of MAY, 1993.

BANK REPRESENTATIVE:

Debra Feller

MAXWELL SURVEYING

R J Maxwell

Rodney H. Maxwell,
Registered Land Surveyor, #1826