SE¼ 36-17-5

R-19
SE¼, 36-17-5.

RESURVEY LOT 1, BLOCK 8,
MEADOW PARK ESTATES
VILLAGE OF ROCKLAND
LACROSSE CO., WISCONSIN.

FOR: Joe Becker

Revirescco

CIVIL ENGINEERING
MAXWELL
& LAND SURVEYING

211 S. WATER ST., SPARTA, WI 54656
(608) 269-1664

MAY 31, 1996

WISCONSIN
RODNEY H MAXWELL
S - 1826
Sparta
Wis
LAND SURVEYOR

SURVEYORS CERTIFICATE

I, Rodney H. Maxwell, Registered Land Surveyor, hereby certify that this survey is true and correct to the best of my knowledge and belief.

Rodney H. Maxwell

Rodney H. Maxwell

N

Bearings based on the plat of Meadow Park Estates

LEGEND

● = IRON PIPE FOUND

O = 1"X24" IRON PIPE SET
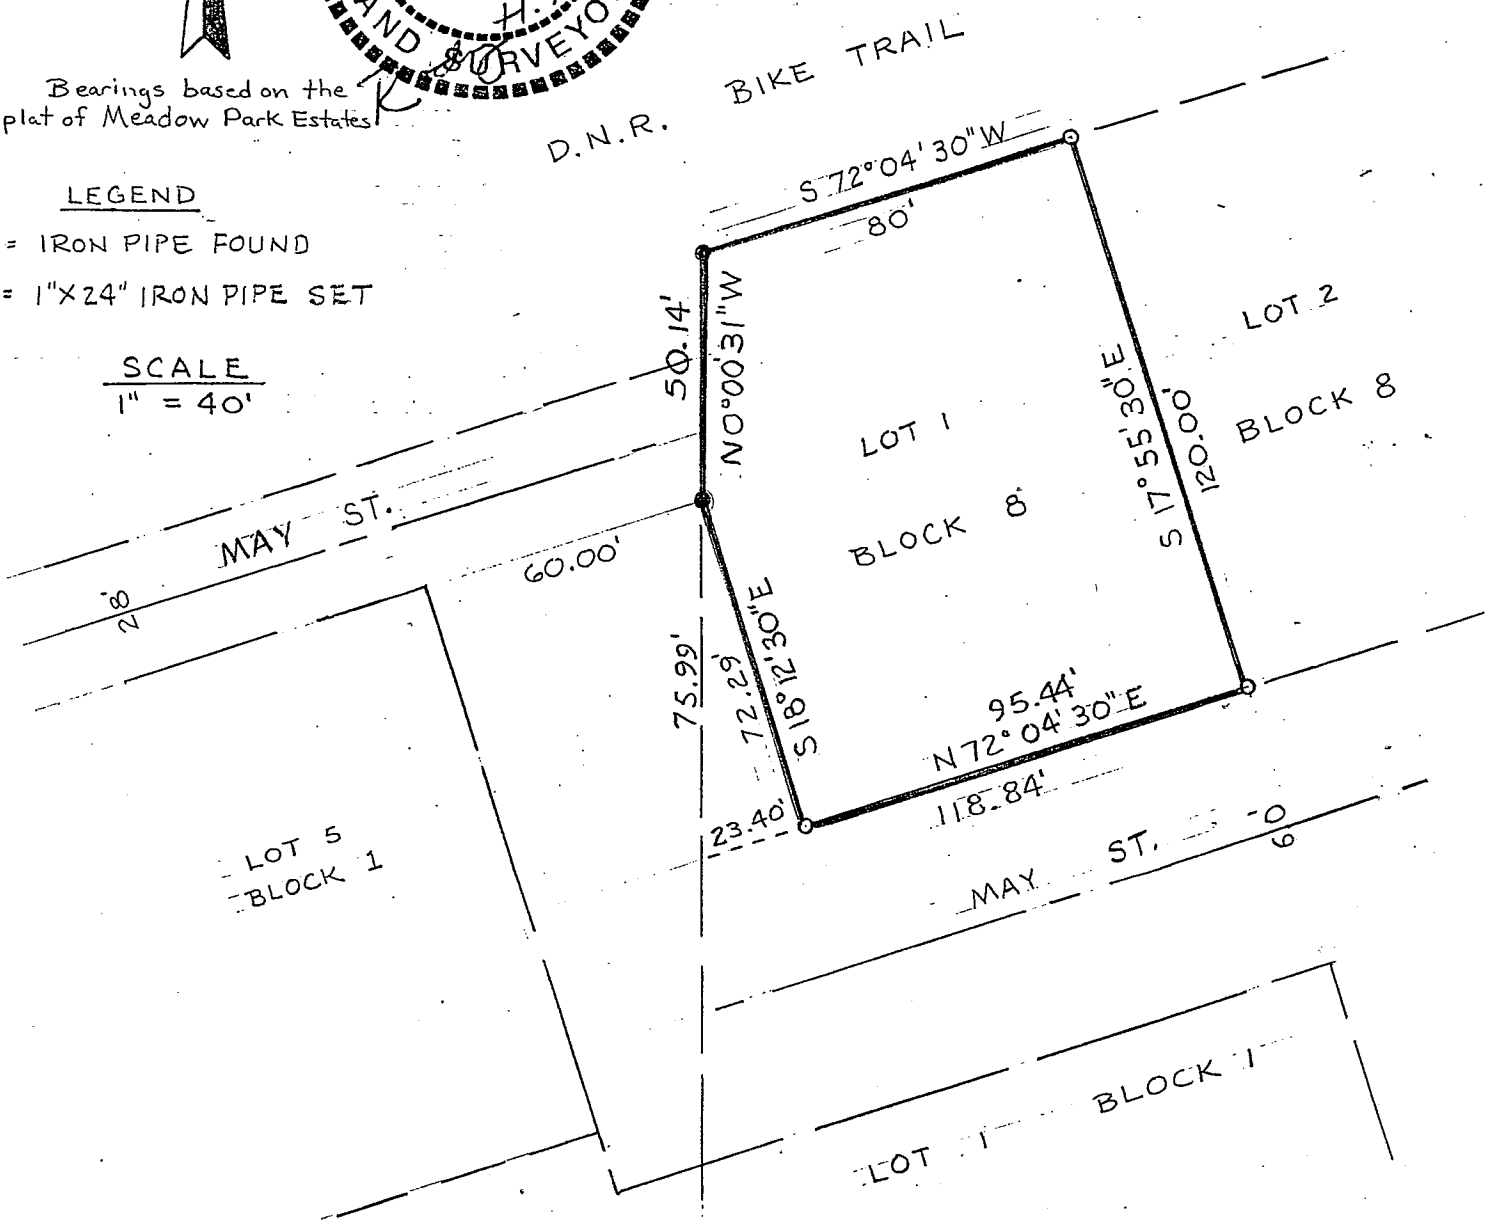
SCALE
1" = 40'