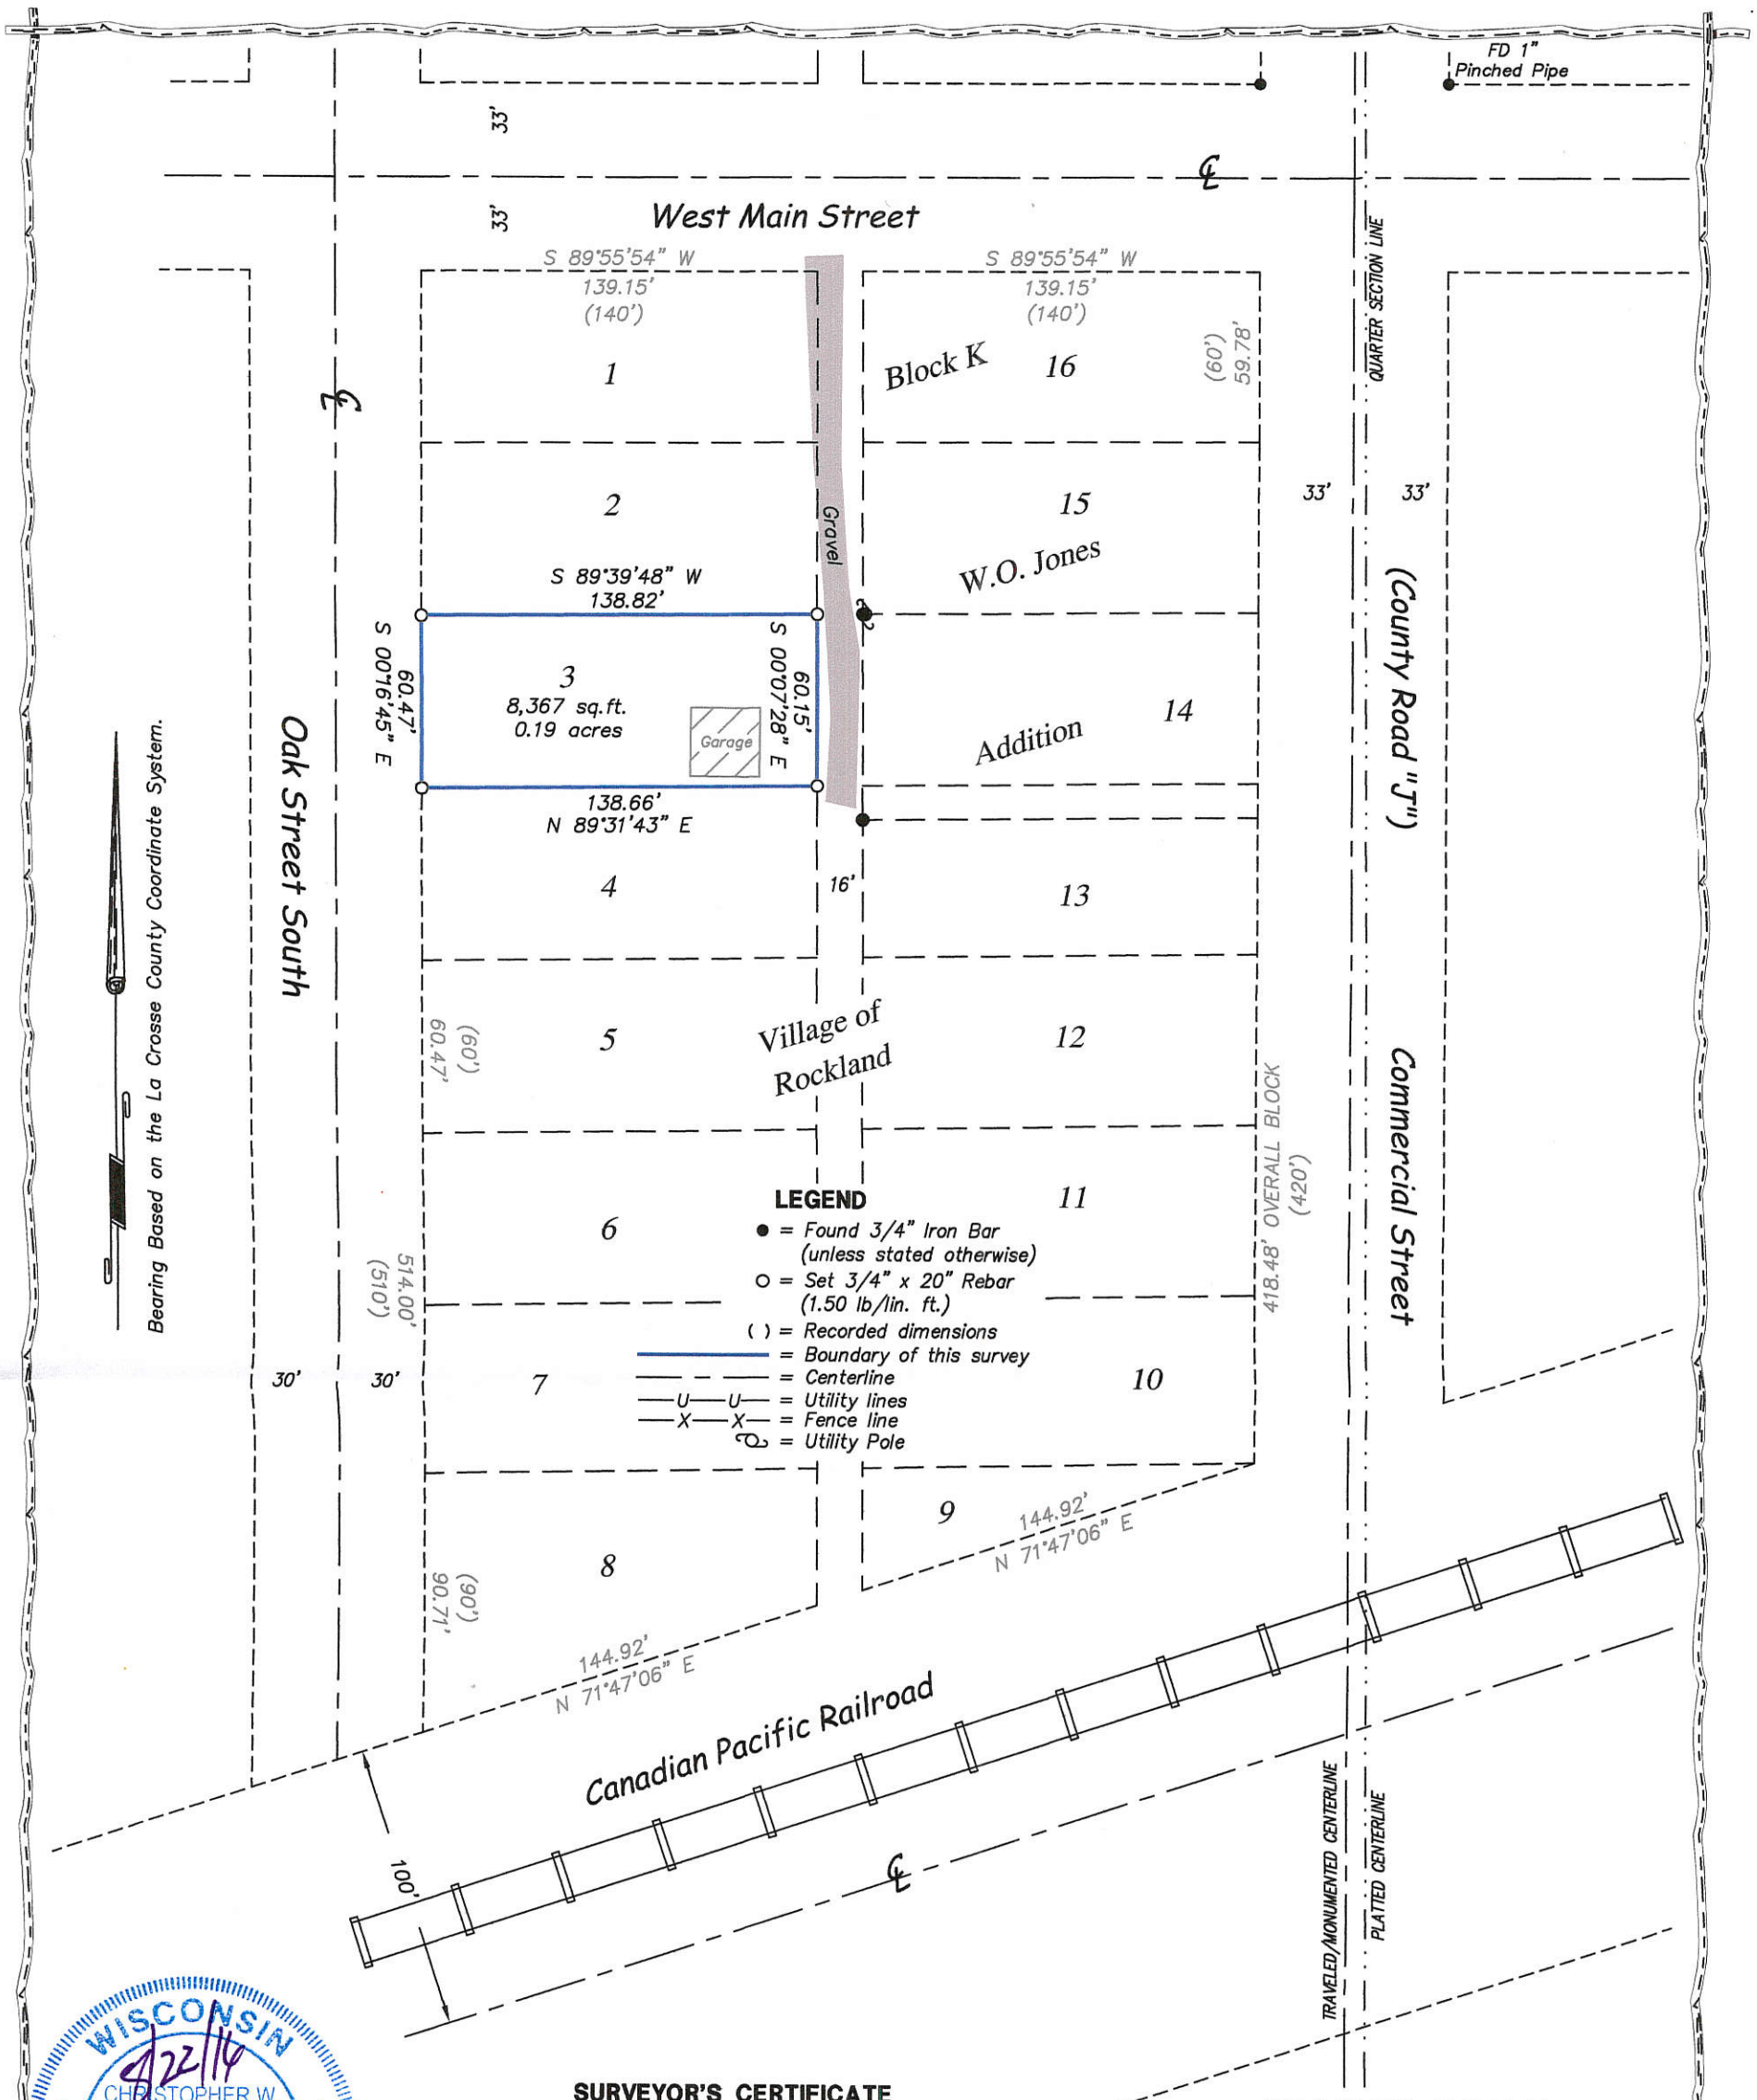

WISCONSIN
8/22/16
CHRISTOPHER W. FECHNER
S-2448
LA CROSSE, WISCONSIN
LAND SURVEYOR

SURVEYOR'S CERTIFICATE

I, Christopher W. Fechner, Registered Land Surveyor, hereby certify that the survey shown and represented above is accurate and true to the best of my knowledge and belief and that there are no visible encroachments other than those shown.

Christopher W. Fechner RLS 2448

SURVEY FOR

Teresa Richmond

Lot 3,Block K,	DRAWN BY: *CF TS*	DATE: *8/22/2016*
W.O. Jones Addition	REVISED BY:	DATE:
Village of Rockland, La Crosse County, WI		
106 South Oak Street	SCALE: 1" = 60'	
SHEET *1* OF *1*	PROJECT NO.: *S-5312F*	FIELD CREW: *TS RC*

Coulee Region Land Surveyors
917 SOUTH 4TH STREET - P.O. BOX 1954
LA CROSSE, WISCONSIN 54601
PHONE (608) 784-1614 FAX (608) 784-1408
www.couleeregionlandsurveyors.com

RECEIVED
OCT 18 2016
COUNTY SURVEYOR'S OFFICE

R-40