Revised 36-17-5

R-5

FIELD SURVEY NOTES

E-D-702 6-70

State of Wisconsin / Department of Transportation

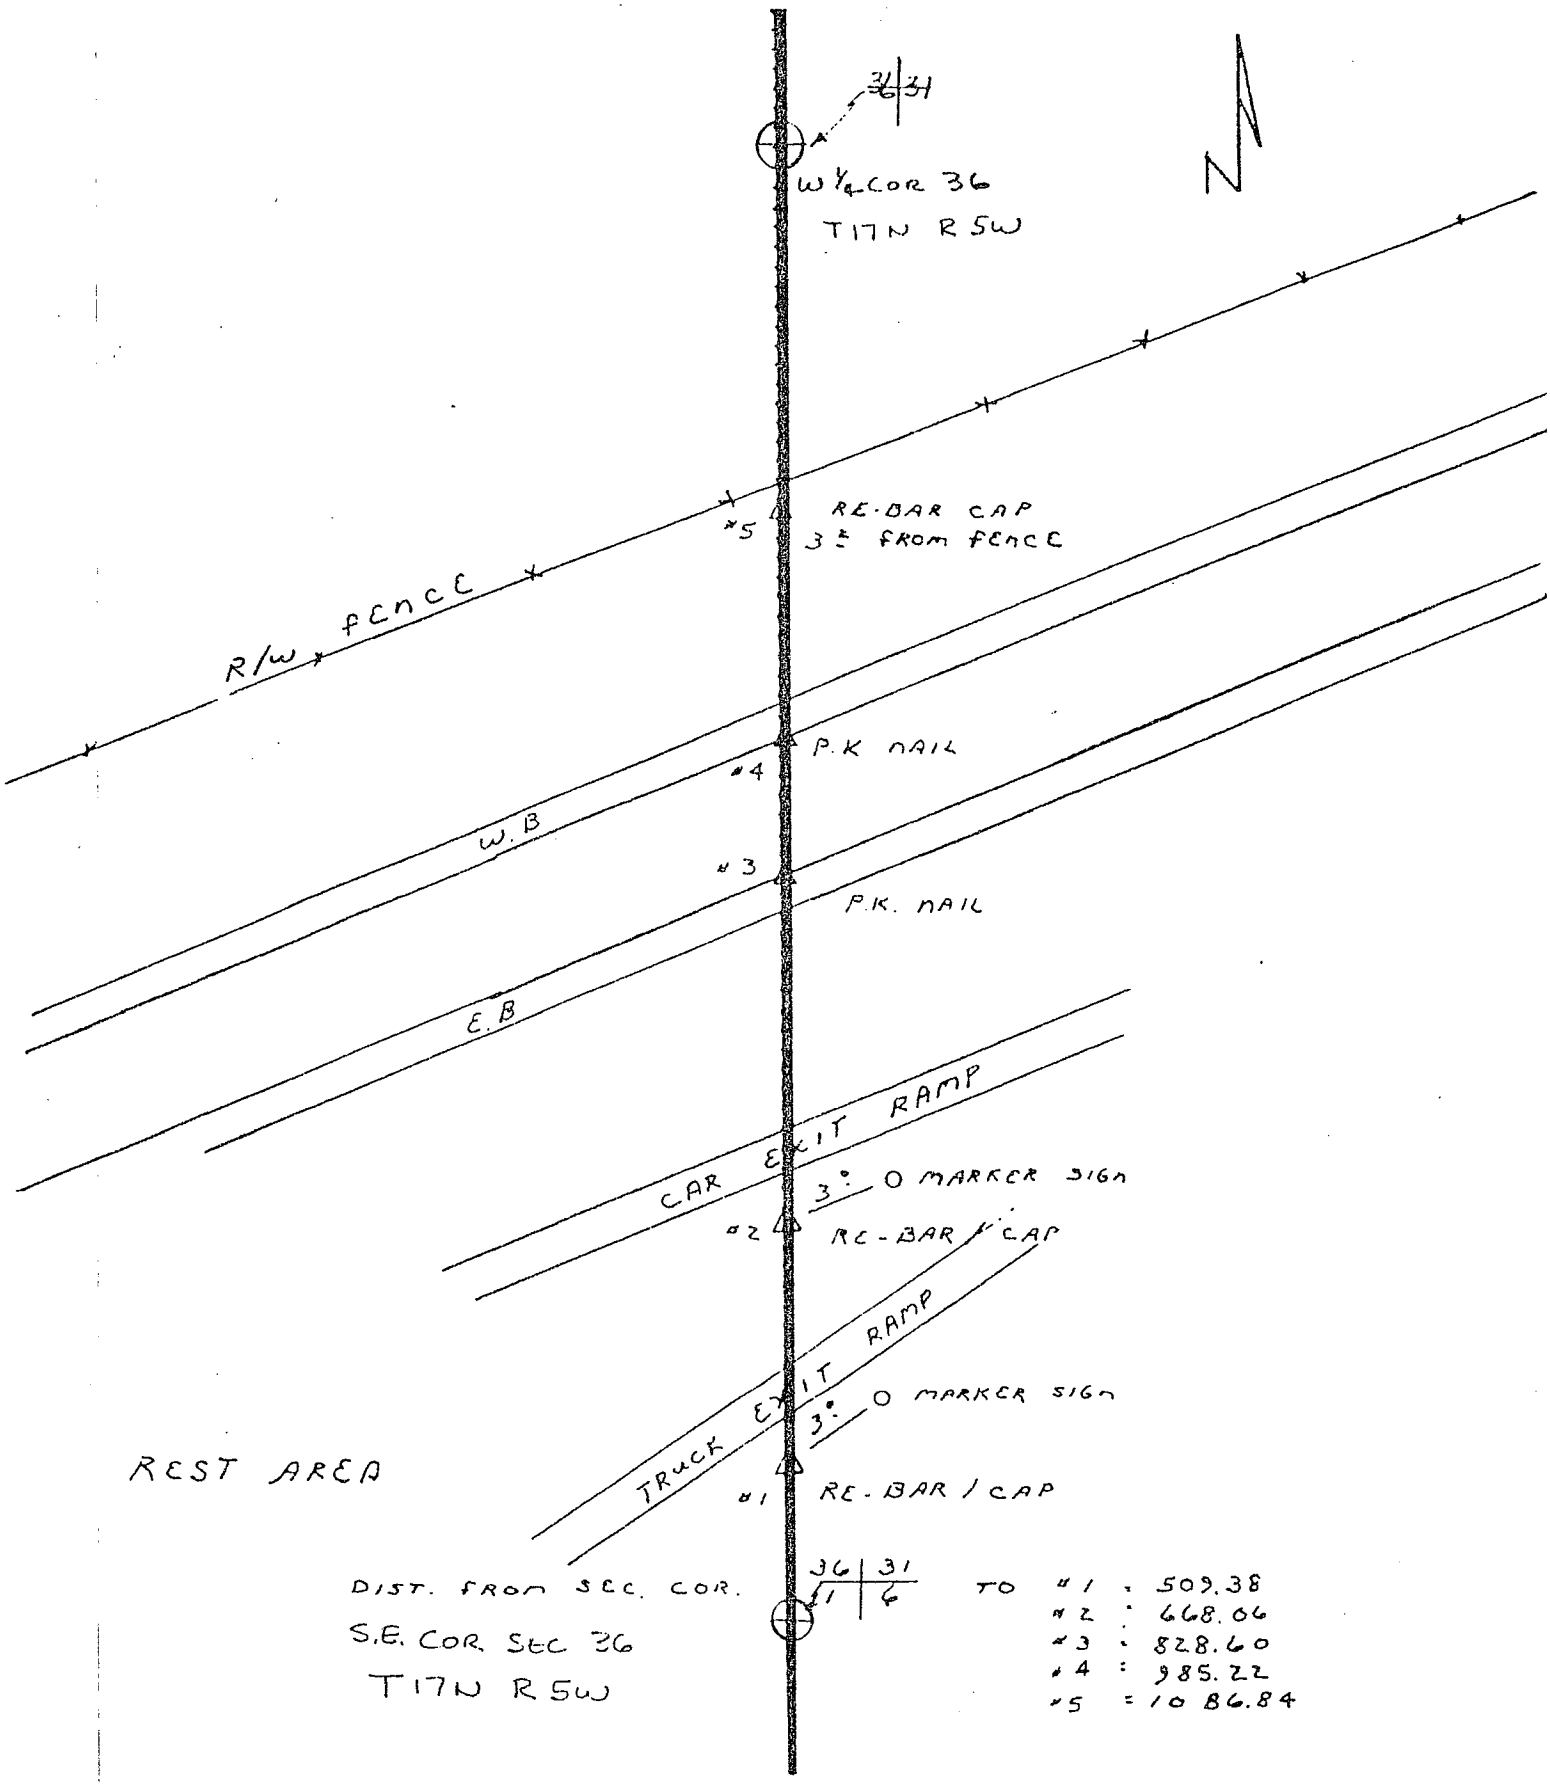

☐ TOPOGRAPHY

☒ SURVEY ALIGNMENT

I-90

LA CROSSE - MONROE CO. LINE

1-21-87

PAGE