No. 37

21505060000

U. S. PUBLIC LAND SURVEY MONUMENT RECORD

SECTION 8 T 15 N, R 5 W, TOWN OF WASHINGTON

LA CROSSE COUNTY

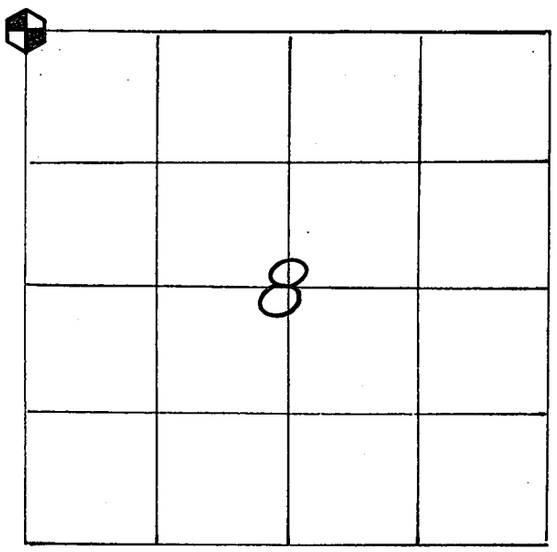

LOCATION OF LANDMARK

WISCONSIN COORDINATE SYSTEM	
North	657,050.062
East	1,701,672.195
Theta Angle	
Horiz. Order	83 (91)
Vert. Order	

TYPE OF LANDMARK

BRASS CAP LUNDE MARKER.

BEARINGS ARE REFERENCED TO

GRID NORTH AS PER SECTION DATA.

CREW: WILLIAM C. JUNG
PETER F. FOLLANSBEE
DATE: 8/14/2000

Describe any record evidence, monument evidence, testimonial evidence or any other material evidence you considered and whether the monument was found or restored through acceptance of an obliterated evidence location.

I set the corner on line with the N1/16NW and N1/4 corners and at a distance from the N1/16NW equal to the distance between this "40" corner and the N1/4 corner. A Lunde was set at the corner. This corner fits the section data to the West and South very well,along with the occupied line to the East just South of the barn.

Describe or show any material discrepancy between the location of the restored corner and that of the corner previously restored or reestablished.

NONE KNOWN.

RECORD OF DURABLE WITNESS MONUMENTS

NO	DESCRIPTION	BEARING	DISTANCE
1	CENTER OF POST IN CONCRETE BASE FOR MAILBOX	S.'WESTERLY±	28.73 FT.
2	CENTER OF POST FOR SATELLITE DISH(AT GROUND)	N.'WESTERLY±	89.40 FT.
3	S.W.-COR. CONCRETE BLOCK HOUSE FOUNDATION	N.'WESTERLY±	77.24 FT.
4	S.E.-COR. CONCRETE BLOCK HOUSE FOUNDATION	N.'WESTERLY±	78.68 FT.

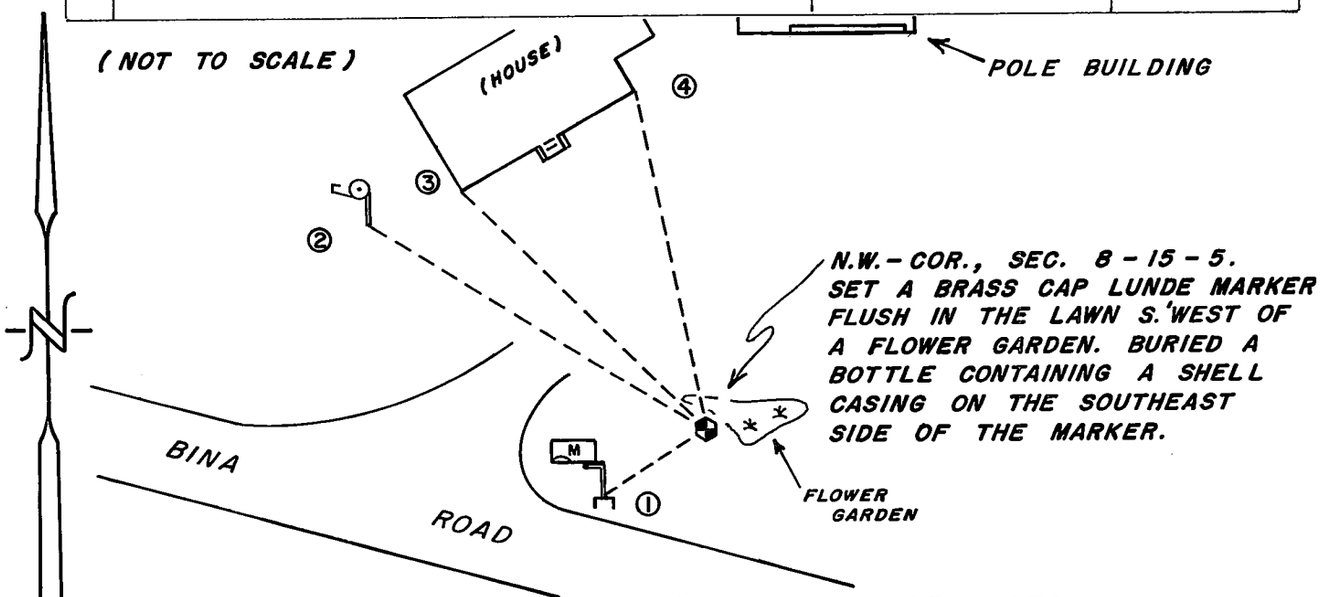

PLAN VIEW DRAWING OF REFERENCE TIES

MAP SHOWING DISTANCE AND DIRECTION TO OTHER PUBLIC LAND SURVEY CORNERS USED FOR REESTABLISHING THE CORNER

(not to scale) (grid bearings and distances)

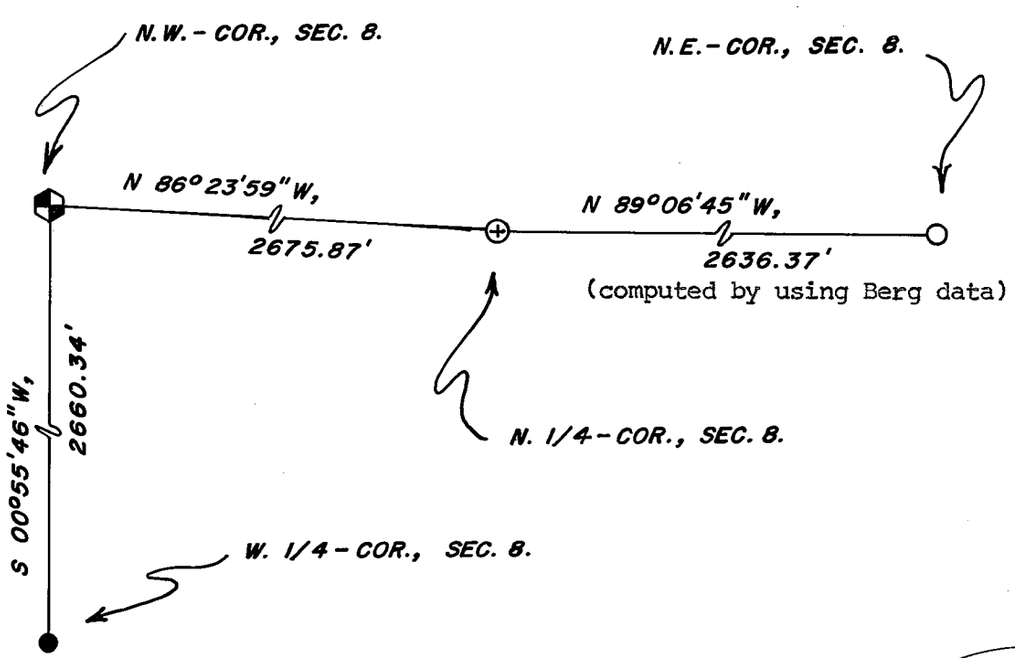

I, WILLIAM C. JUNG, COUNTY SURVEYOR

HEREBY CERTIFY THAT THE CORNER LOCATION SHOWN ON THIS RECORD WAS DETERMINED BY ME OR UNDER MY DIRECTION AND CONTROL AND THAT THIS U. S. PUBLIC LAND SURVEY MONUMENT RECORD IS CORRECT AND COMPLETE TO THE BEST OF MY KNOWLEDGE AND BELIEF.

William C. Jung — 11/27/00

Signature — Date

WISCONSIN WILLIAM C. JUNG S-1323 ONALASKA, WIS. LAND SURVEYOR

Seal