NO. 70

21505172000

U. S. PUBLIC LAND SURVEY MONUMENT RECORD

SECTION 16 T 15 N, R 5 W, TOWN OF Washington

LA CROSSE COUNTY

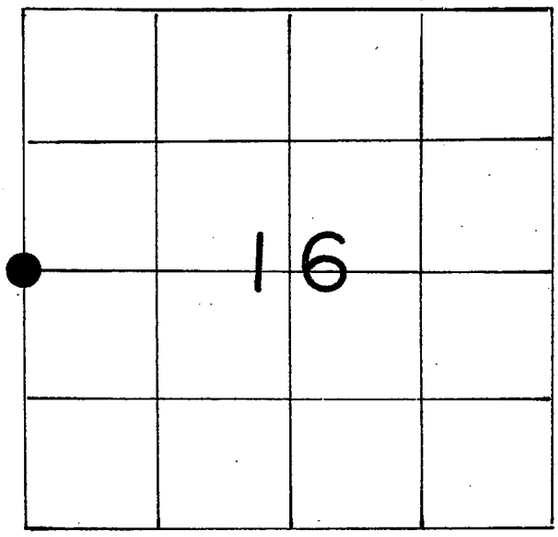

LOCATION OF LANDMARK

WISCONSIN COORDINATE SYSTEM	
North	648,906.999
East	1,706,861.651
Theta Angle	
Horiz. Order	
Vert. Order	
Datum:	1983('91)

TYPE OF LANDMARK

~~Railroad Spike~~ P.K. nail

BEARINGS ARE REFERENCED TO

Assumed North

Crew: William C. Jung
Peter Follansbee

Date: 12/7/89

Crew: William C. Jung
Peter Follansbee

Date: 4/10/97

Describe any record evidence, monument evidence, testimonial evidence or any other material evidence you considered and whether the monument was found or restored through acceptance of an obliterated evidence location.

I set the corner on line with the fence to the West and in the road centerline. This occupied corner location fits the old highway map and the section measurements. The corner is only off line 9" between the section corners.I accepted this location as the best available evidence of the original government corner position.

The railroad spike was knocked out during repaving of "162" last year. We set a P.K. nail at the corner location.

Describe or show any material discrepancy between the location of the restored corner and that of the corner previously restored or reestablished.

None known.

RECORD OF DURABLE WITNESS MONUMENTS

NO	DESCRIPTION	BEARING	DISTANCE
1	Set 1"x28" iron pipe South of wood R/W post	West±	45.00
2	Set 3/4"x24" round iron bar at top of slope	-----	49.31
3	" " " " "	-----	59.91
4	" " " " "	East±	50.03

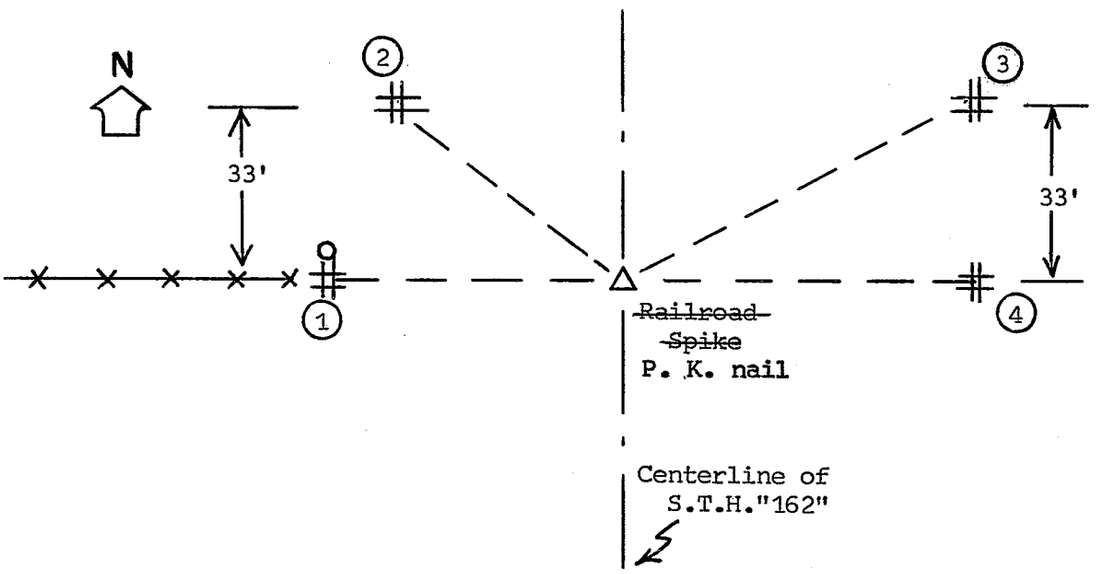

PLAN VIEW DRAWING OF REFERENCE TIES

MAP SHOWING DISTANCE AND DIRECTION TO OTHER PUBLIC LAND SURVEY CORNERS USED FOR REESTABLISHING THE CORNER

(not to scale)

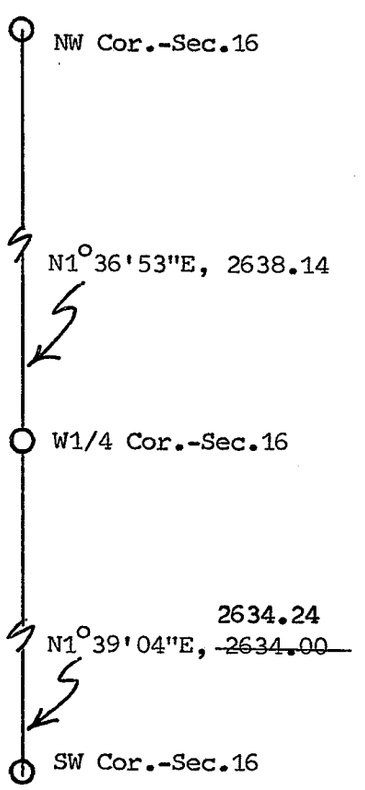

I, William C. Jung, ~~Deputy~~ County Surveyor,

HEREBY CERTIFY THAT THE CORNER LOCATION SHOWN ON THIS RECORD WAS DETERMINED BY ME OR UNDER MY DIRECTION AND CONTROL AND THAT THIS U. S. PUBLIC LAND SURVEY MONUMENT RECORD IS CORRECT AND COMPLETE TO THE BEST OF MY KNOWLEDGE AND BELIEF.

William C. Jung — December 14,1989

Signature — Date

Revised: June 13, 1997 wcj

Seal