No. 37

21506060000

U. S. PUBLIC LAND SURVEY MONUMENT RECORD

SECTION 6 T 15 N, R 6 W, TOWN OF SHELBY

LA CROSSE COUNTY

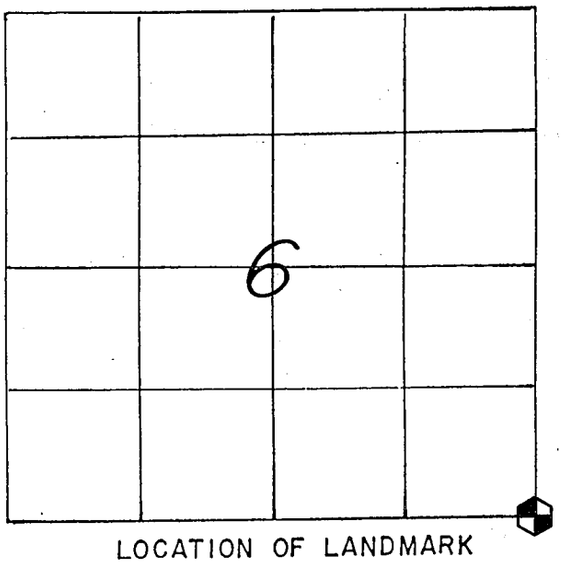

LOCATION OF LANDMARK

CREW: WILLIAM C. JUNG
PETER F. FOLLANSBEE
DATE: 12/03/1998

WISCONSIN COORDINATE SYSTEM
North
East
Theta Angle
Horiz. Order
Vert. Order
TYPE OF LANDMARK *BRASS CAP LUNDE MARKER.*
BEARINGS ARE REFERENCED TO

Describe any record evidence, monument evidence, testimonial evidence or any other material evidence you considered and whether the monument was found or restored through acceptance of an obliterated evidence location.

Paul Fairchild and I agreed on the location of this corner after he traversed in the four surrounding sections. We agreed to accept the occupied evidence and conditions as the best available evidence of the original government corner position. Paul set an iron bar at the corner. I removed the bar and replaced it with a Lunde marker.

Describe or show any material discrepancy between the location of the restored corner and that of the corner previously restored or reestablished.

In previous work in Section 8, Steve Solberg did a section "split" in which the location of this corner had to be determined. There was not an existing marker at this corner. Paul and I are not sure what Steve did in regard to this corner.

RECORD OF DURABLE WITNESS MONUMENTS

NO	DESCRIPTION	MAGNETIC BEARING	DISTANCE
1	SET A NAIL IN THE N.E.-SIDE 3" HICKORY	S 67° E	20.37 FT.
2	SET A NAIL IN THE S.W.-SIDE 9" HICKORY	S 46° E	26.68 FT.
3	SET A NAIL IN THE S.W.-SIDE 7" HICKORY	S 30° E	28.77 FT.
4	SET A NAIL IN THE W.-SIDE 7-1/2" HICKORY	S 14° E	SL.= 38.92'

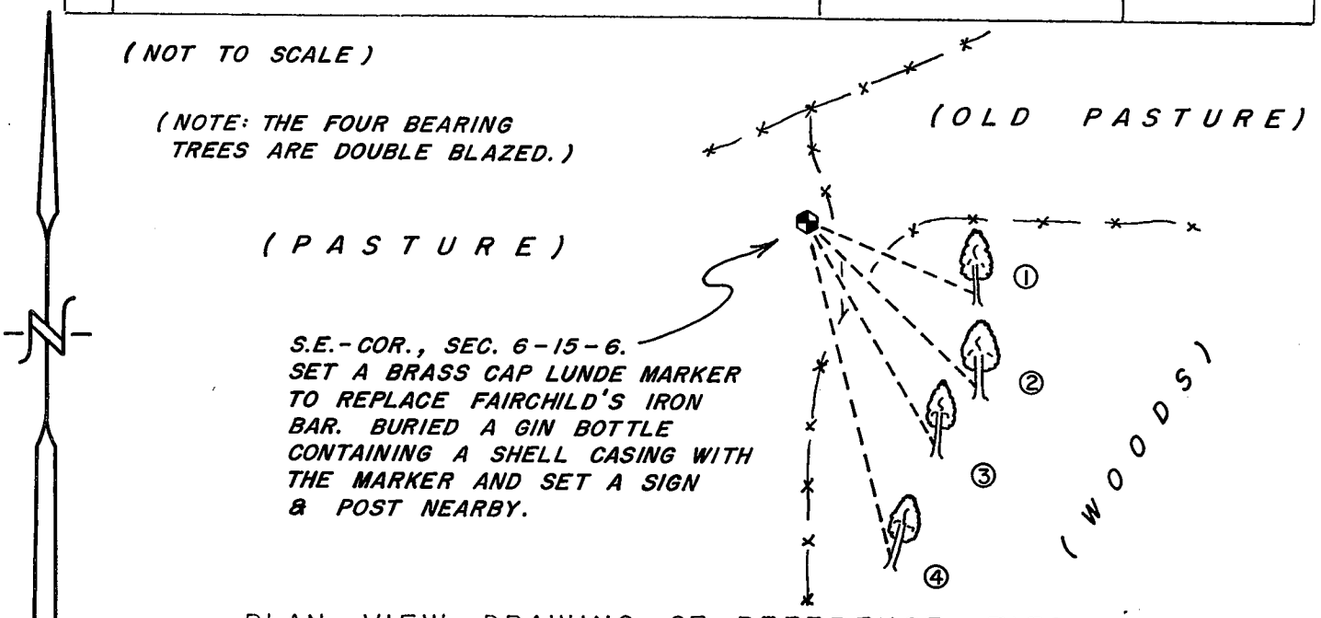

PLAN VIEW DRAWING OF REFERENCE TIES

MAP SHOWING DISTANCE AND DIRECTION TO OTHER PUBLIC LAND SURVEY CORNERS USED FOR REESTABLISHING THE CORNER

No section measurements were made by me at this time. The location of this corner was confirmed by Paul Fairchild.

I, WILLIAM C. JUNG, COUNTY SURVEYOR
HEREBY CERTIFY THAT THE CORNER LOCATION SHOWN ON THIS RECORD WAS DETERMINED BY ME OR UNDER MY DIRECTION AND CONTROL AND THAT THIS U. S. PUBLIC LAND SURVEY MONUMENT RECORD IS CORRECT AND COMPLETE TO THE BEST OF MY KNOWLEDGE AND BELIEF.

William C. Jung — 1/12/99

Signature — Date

WISCONSIN WILLIAM C. JUNG S-1323 ONALASKA, WIS. LAND SURVEYOR

Seal