21507110020

RECEIVED
JUL 26 2005
COUNTY SURVEYOR'S OFFICE

No. 56

LA CROSSE COUNTY
CERTIFIED U.S. PUBLIC LAND SURVEY MONUMENT RECORD

INSTRUCTIONS: THIS RECORD SHALL SHOW THE LOCATION OF THE CORNER AND SHALL INCLUDE ALL OF THE FOLLOWING ELEMENTS (A-I)

(A) IDENTIFY THE CORNER BY REFERENCE TO THE U.S. PUBLIC LAND SURVEY SYSTEM

■ = CORNER MONUMENT RESTORED

WITNESSES TO CORNER LOCATION:
1) Robert M. Lampman
2) Jessica A. Zamor

WIS. STATE PLANE GRID COORDINATES - NAD83(1991) - SURVEY FEET
NORTHING: 652181.929
EASTING: 1657077.753

GEOGRAPHIC COORDINATES - WGS84/GRS80 - NAD83(1991)
Lat: 43°47'00.00924" N
Lon: 91°10'45.41110" W

LA CROSSE COUNTY GRID COORDINATES - NAD83(1991) - SURVEY FEET
NORTHING: 121135.314
EASTING: 464284.593

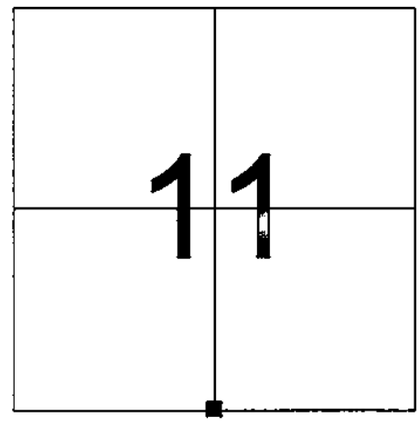

SECTION 11
TOWN 15 NORTH, RANGE 7 WEST

(B) DESCRIBE ANY RECORD EVIDENCE, MONUMENT EVIDENCE, OCCUPATIONAL EVIDENCE, TESTIMONIAL EVIDENCE OR ANY OTHER MATERIAL EVIDENCE YOU CONSIDERED, AND WHETHER THE MONUMENT WAS FOUND OR PLACED.

Visited the corner area initially and found an existing 1" o.d. iron pipe in line with north-south occupation and a field fence to the west. Found no other monumentation in the area. Determined the location of the iron pipe to be approximately 51 feet too far north as per alignment of the SE and SW corners of Section 11. Determined that the section corner should be established on line between the SE and SW corners of Section 11 as no strong east-west occupation or any other evidence could be found to support any other north-south position. This decision being supported by measurements to the Center areas of Sections 11 and 14 as well as rough measurement to occupation at the SW corner of the NW 1/4 of the NE 1/4 of Section 14.

Reestablished the section corner location on line between the SE and SW corners of Section 11 as described above and on line with a found monument at the Center of Section 11 and the found 1" o.d. iron pipe as mentioned above. This location agrees with north-south occupation at the corner area and running across the valley to the north.

(Continued on Reverse)

(C) IN THE PLAN VIEW DRAWING BELOW, PROVIDE REFERENCE TIES TO AT LEAST 4 WITNESS MONUMENTS OR, IF THE LOCATION IS WITHIN A MUNICIPALITY, TO AT LEAST 2 WITNESS MONUMENTS. (WITNESS MONUMENTS SHALL BE MADE OF CONCRETE, NATURAL STONE, IRON, OR OTHER EQUALLY DURABLE MATERIAL.) DESCRIBE WITNESS MONUMENTS.

(D) SHOW A PLAN VIEW DRAWING, DEPICTING THE RELEVANT MONUMENTS AND REFERENCE TIES, WHICH IS SUFFICIENTLY DETAILED TO ENABLE ACCURATE RELOCATION OF THE CORNER MONUMENT IF IT IS DISTURBED.

LEGEND

■ SET 3/4" x 30" ROUND IRON BAR WITH ALUMINUM CAP AT SECTION CORNER

● SET 3/4" x 24" ROUND IRON BAR AS WITNESS MONUMENT

o EXISTING MONUMENT AS SHOWN

NOT TO SCALE

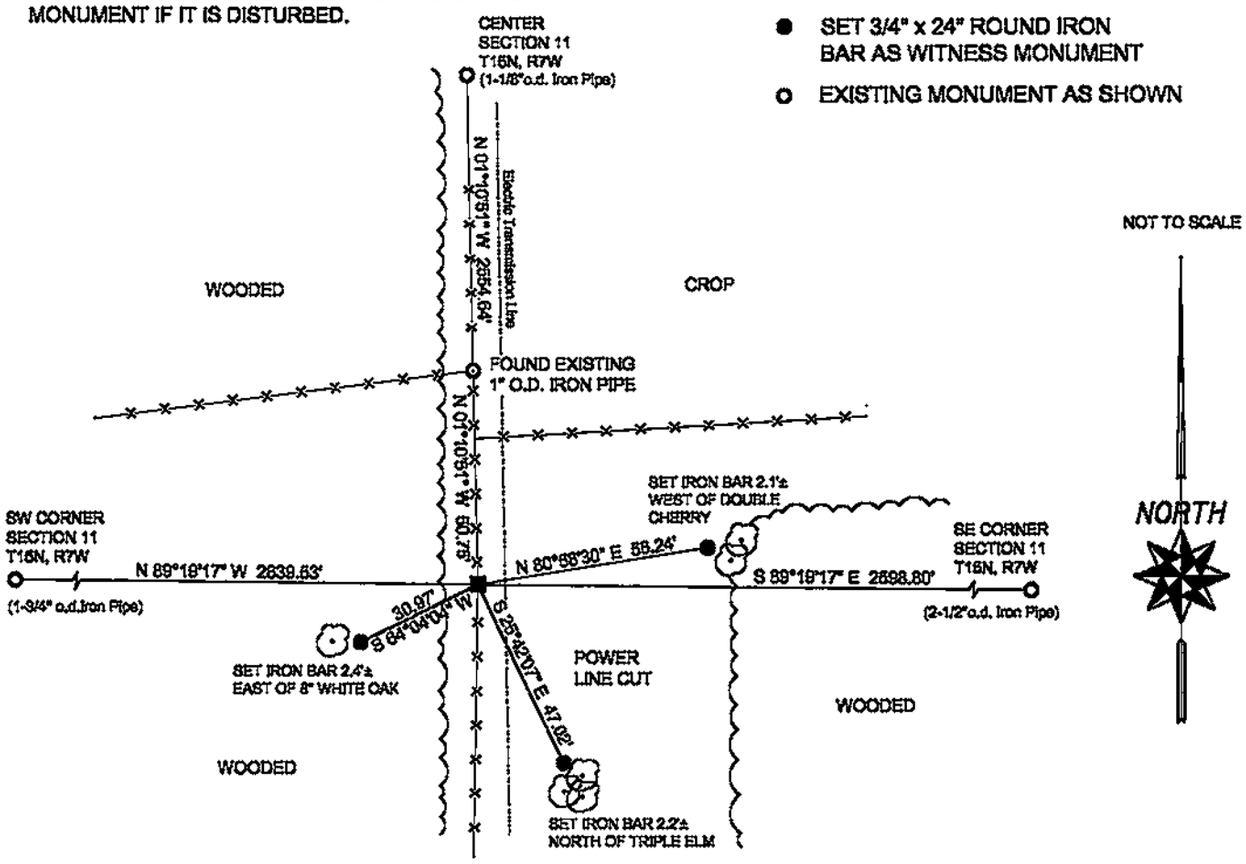

(E) DESCRIBE ANY MATERIAL DISCREPANCY BETWEEN THE LOCATION OF THE CORNER AS RESTORED OR REESTABLISHED AND THE LOCATION OF THAT CORNER AS PREVIOUSLY RESTORED OR REESTABLISHED BY DISTANCE AND DIRECTION. SHOW THE DISCREPANCY ON THE PLAN VIEW DRAWING UNDER (D), ABOVE. SHOW THE DISTANCES BETWEEN THE CORNER AS PREVIOUSLY RESTORED OR REESTABLISHED AND (1) THE CORNER AS RESTORED OR REESTABLISHED, AND (2) TO AT LEAST 2 OF THE WITNESS MONUMENTS AS SHOWN ON THE DRAWING IN (D), ABOVE.

N/A

(F) WAS THE CORNER RESTORED THROUGH ACCEPTANCE OF (1) AN OBLITERATED EVIDENCE LOCATION, OR (2) A FOUND PERPETUATED LOCATION?

(1) A FOUND PERPETUATED LOCATION (PERPETUATED BY EVIDENCE OF OCCUPATION AND INFORMATION FROM PRIOR SURVEYS)

(G & H) WAS THE CORNER REESTABLISHED THROUGH LOST CORNER PROPORTIONATE METHODS? IF SO SHOW THE METHOD, INCLUDING THE DIRECTIONS AND DISTANCES TO OTHER PUBLIC LAND SURVEY CORNERS USED AS EVIDENCE OR USED FOR PROPORTIONING IN DETERMINING THE CORNER LOCATION.

N/A

Corner location was not reestablished by proportionate methods. However, the corner was reestablished on line between section corners to the east and west. See sketch on reverse.

(**) ANY ADDITIONAL INFORMATION RELATED TO CORNER LOCATION

(B) EVIDENCE CONSIDERED - CONTINUED FROM REVERSE

The decision to reestablish the section corner in line with north-south occupation included consideration given to a Certified Survey Map prepared by Gregory J. Hofmeister, located in Sections 14 and 15 and dated 1980. Computing outward from Lot 2 of said Certified Survey Map it was possible to determine that the North-South one quarter line utilized in said survey would have extended north to match occupation at this corner area. (Mr. Hofmeister's survey did not include enough information to determined if a north-south position for this corner was reestablished in 1980. A thorough but unsuccessful search for an existing monument was made.)

It is also worth noting that the occupied Center of Section 14 (found marked with and existing iron pipe - see Connell survey in Section 14) and the monumented Center of Section 11 are both located east of lines run to this corner from the one-quarter corners to the north and south. Thus, to shift this corner west to a position by equal proration of distance would only increase these discrepancies.

The Center of Section 11 was apparently established by Gregory Hofmeister as an irregular Center in 1979. Bill Jung showed me county resurvey records supporting Mr. Hofmeister's decision regarding said Center. Thus, this one-quarter corner location was reestablished with the understanding that the existing Center of Section 11 would be held and that the reestablished location of this quarter corner would have no impact on the location of said Center.

As to the Center of Section 14, Bill Jung showed me county resurvey records indicating that said Center should be on a straight line. This is consistant with the fact that computations from Mr. Hofmeister's survey were found to disagree with the existing iron pipe found at the occupied Center of Section 14 and agree with North-South occupation at this one-quarter corner area.

CORNER HISTORY:

-Original government corner location established by A.L.Brown in 1846.

-Gregory J. Hofmeister apparently subdivided Section 14 as part of a Certified Survey Map located in Sections 14 and 15 and dated 1980.

-Gregory J. Hofmeister reestablished the Center of Section 11 as part of Certified Survey Map located in said Section 11 and dated 1979.

AFFIX LAND SURVEYOR SEAL

(I) I, JESSICA A. ZAMOR, CERTIFY THAT THE LOCATION SHOWN ON THIS RECORD WAS DETERMINED BY ME OR UNDER MY DIRECTION AND CONTROL AND THAT THIS U.S. PUBLIC LAND SURVEY MONUMENT RECORD IS CORRECT AND COMPLETE TO THE BEST OF MY KNOWLEDGE AND BELIEF.

Jessica A Zamor
SIGNATURE

7-23-2005
DATE

WISCONSIN
JESSICA A. ZAMOR
S-2310
DESOTO, WI
LAND SURVEYOR