No. 78

21605132000

No. 78

CERTIFICATE

I, Michael J. Harding, do hereby certify that on the 21st day of April 19 99, I found (~~evidence~~) (no evidence) of the W 1/4 corner of Section 18, T 16 N, R 4W Fourth Principal Meridian, and I re-established said corner according to the Wisconsin Statutes as shown and described hereon.

Dated this 21 day of April 19 99.

Michael J. Harding

Registered Land Surveyor

Title

CERTIFIED LAND CORNER

No. 54

History of corner establishment since Original Government Survey

Description of corner evidence found:

Rodney Maxwell has used this calculated position on surveys in the area. He has searched for the corner here as well as myself. We have found nothing. I contacted Rodney Maxwell and obtained his control points in the area and I have set a Harrison Monument. I agree with Rodney Maxwell's calculated corner.

WISCONSIN
MICHAEL J. HARDING
S-2296
LA CROSSE
WIS
LAND SURVEYOR

COUNTY SURVEYOR FORM NO. 1

Description of corner and witness monuments, references and accessories used to perpetuate the original or re-established location of this corner:

Witnesses to corner location:

MICHAEL J. HARDING

SCOTT DUNNUM

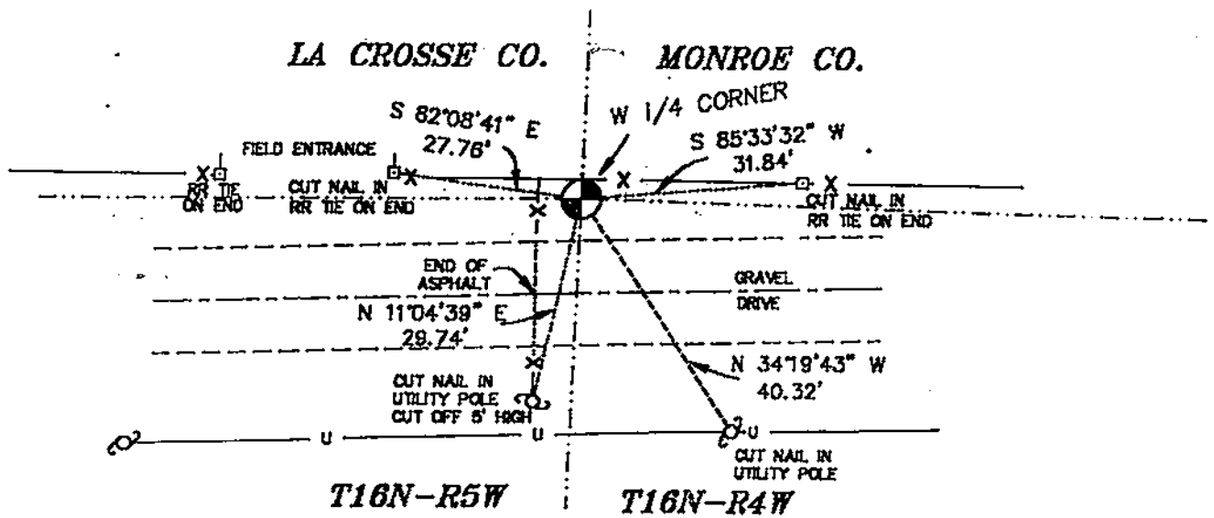

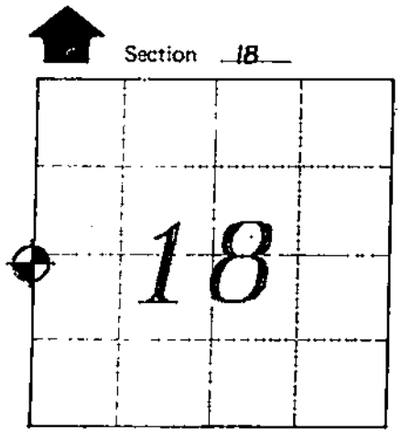

O = LOCATION CORNER

T 16 N R 4 W

WISCONSIN

SURVEY CONTROL ORDER

Horizontal	
Vertical	

WISCONSIN COORDINATE SYSTEM

Corner	East (X)	North (Y)	Elevation (Z)	Zone
Control Sta. Name				

City, Village or Town LEON

County of MONROE