FORM NO. 985-A

NO. 55

21606110000

" TIE " SHEET - TEMPORARY / RANDOM SECTION CORNER
SE CORNER - SECTION 11-T16N-R6W, TOWN OF HAMILTON

This is not the final section corner but is a survey point at a temporary/random section corner. I set this pipe at a computed location where I feel that the section corner should be. However, the distance should be measured East to the pipe at the 1/4 corner before a final decision can be reached. The distances going West up to two miles fit the original notes very well. There are no line fences going North or South from this corner. The existing East-West fence at this point looks very good for location. I could find no other evidence of the original government corner location, even after thoroughly searching the area. This iron pipe survey point should be preserved.

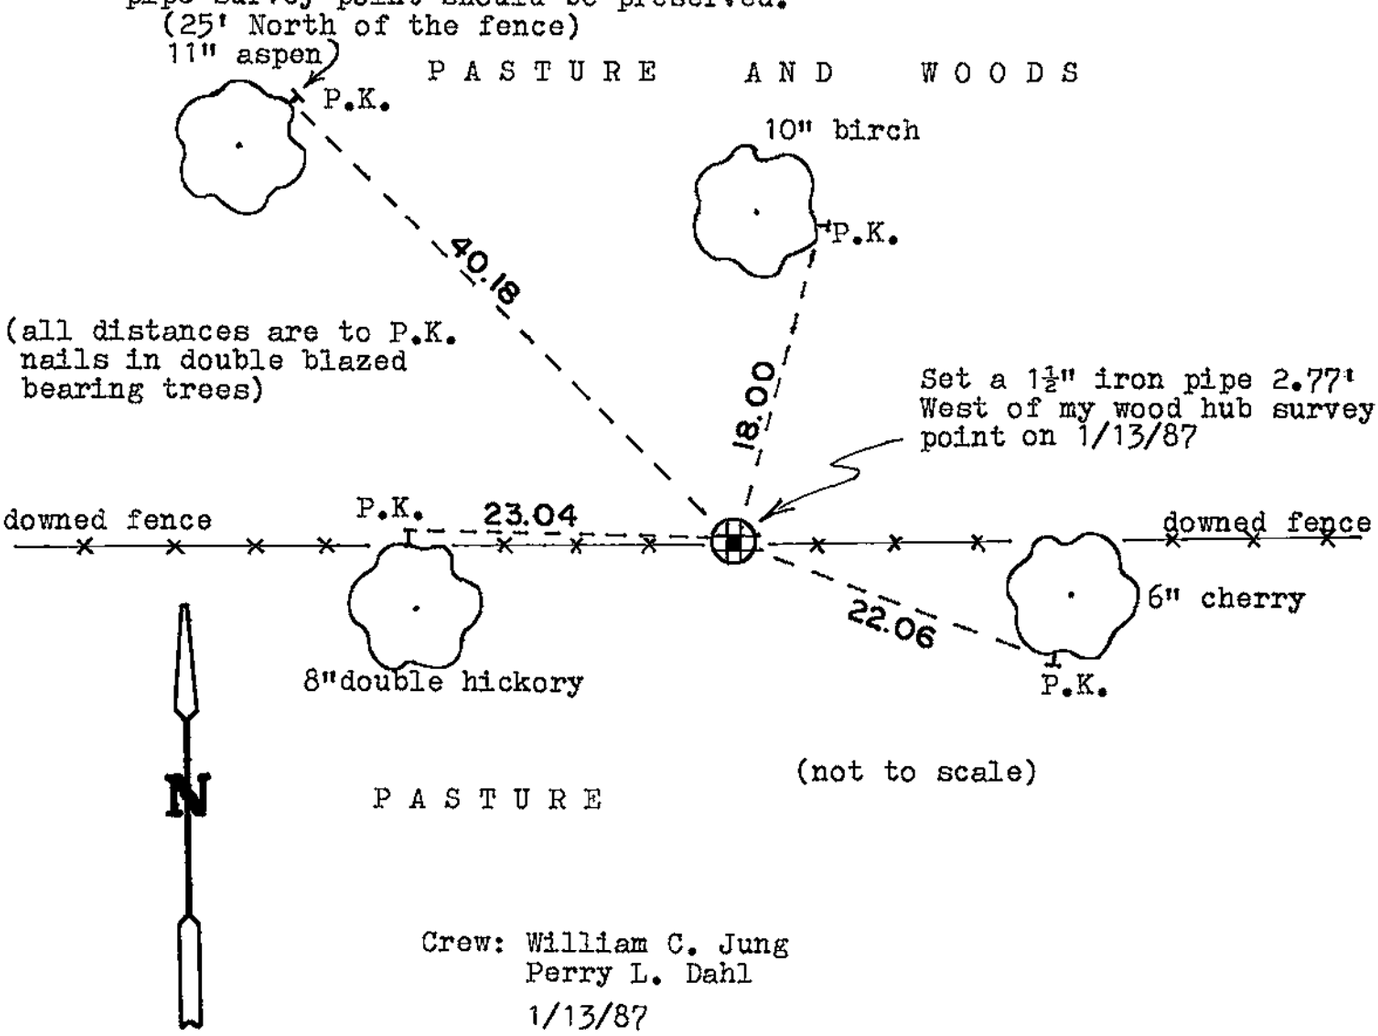

Crew: William C. Jung
Perry L. Dahl
1/13/87

William C. Jung 1/16/87
William C. Jung, RLS
Deputy County Surveyor

WISCONSIN
WILLIAM C. JUNG
S-1323
ONALASKA, WIS.
LAND SURVEYOR