NO. 84

21606150020

U. S. PUBLIC LAND SURVEY MONUMENT RECORD

SECTION 22 T 16 N, R 6 W, TOWN OF BARRE

LA CROSSE COUNTY

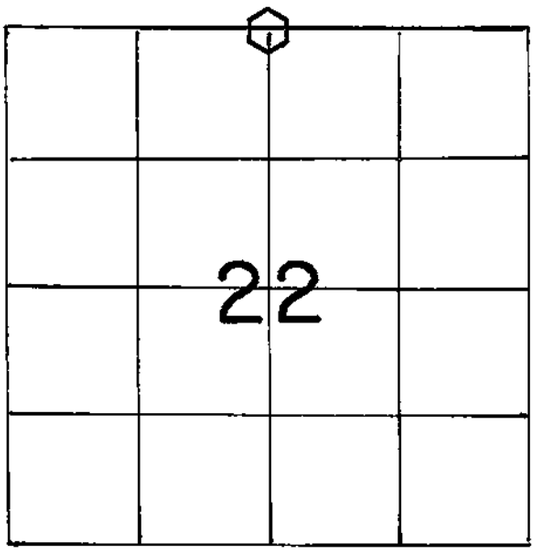

LOCATION OF LANDMARK

WISCONSIN COORDINATE SYSTEM
North
East
Theta Angle
Horiz. Order
Vert. Order
TYPE OF LANDMARK Set brass cap Lunde marker.
BEARINGS ARE REFERENCED TO

Crew: WILLIAM C. JUNG
C. SUTTON

Date: 7/07/1993

Describe any record evidence, monument evidence, testimonial evidence or any other material evidence you considered and whether the monument was found or restored through acceptance of an obliterated evidence location.

I found a pipe at the old occupied fence corner and accepted it as the best available evidence of the original government corner position. The pipe had been used in previous survey work. I removed the pipe and replaced it with a brass capped Lunde marker.

Describe or show any material discrepancy between the location of the restored corner and that of the corner previously restored or reestablished.

None Known

RECORD OF DURABLE WITNESS MONUMENTS

NO	DESCRIPTION	MAGNETIC BEARING	DISTANCE
1	Set P.K. Nail in NE-side 3" Hickory	Northwesterly	13.73 Ft.
2	Set P.K. Nail in NE-side 4" Hickory	Northwesterly	26.05 Ft.
3	Set P.K. Nail in East side 4" Hickory	Northwesterly	13.48 Ft.
4	Set P.K. Nail in North side 6" Black Walnut (?)	S 70°E	35.00 Ft.

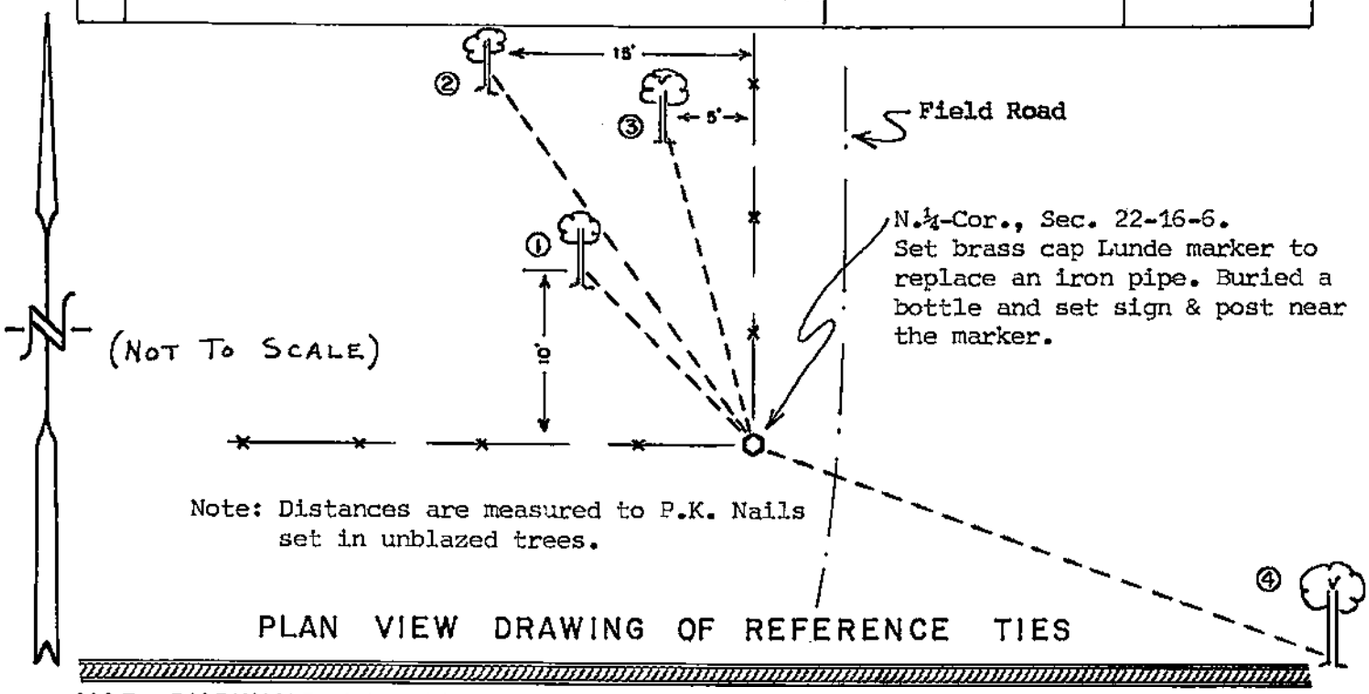

PLAN VIEW DRAWING OF REFERENCE TIES

MAP SHOWING DISTANCE AND DIRECTION TO OTHER PUBLIC LAND SURVEY CORNERS USED FOR REESTABLISHING THE CORNER

No section measurements were made by me at this time. The corner position was confirmed by previous survey work by others.

I, William C. Jung, County Surveyor
HEREBY CERTIFY THAT THE CORNER LOCATION SHOWN ON THIS RECORD WAS DETERMINED BY ME OR UNDER MY DIRECTION AND CONTROL AND THAT THIS U. S. PUBLIC LAND SURVEY MONUMENT RECORD IS CORRECT AND COMPLETE TO THE BEST OF MY KNOWLEDGE AND BELIEF.

William C. Jung — 1/14/94

Signature — Date

WISCONSIN WILLIAM C. JUNG S-1323 ONALASKA, WIS. LAND SURVEYOR

Seal