NO. 133

21606260000

U. S. PUBLIC LAND SURVEY MONUMENT RECORD

SECTION 25 T 16 N, R 6 W, TOWN OF BARRE

LA CROSSE COUNTY

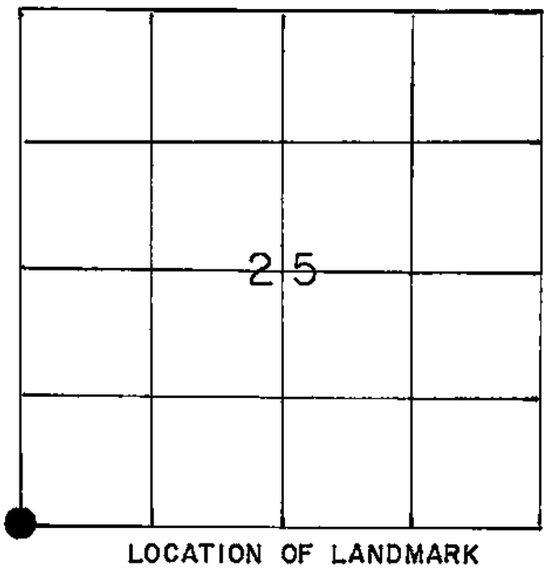

LOCATION OF LANDMARK

WISCONSIN COORDINATE SYSTEM
North
East
Theta Angle
Horiz. Order
Vert. Order

TYPE OF LANDMARK
Railroad spike over 1/2" rebar

BEARINGS ARE REFERENCED TO

Crew: William Jung
Perry Dahl

7/30/85

Describe any record evidence, monument evidence, testimonial evidence or any other material evidence you considered and whether the monument was found or restored through acceptance of an obliterated evidence location.

In July of 1984 I found a nail, down 6", which was set at the occupied corner in 1949 by surveyors from the LaCrosse County Highway Department. I removed the nail and replaced it with a 1/2"x16" reinforcing rod. The highway was repaved in 1985 and the rebar was buried. I set a railroad spike over the rebar. I accepted the occupied corner as the best available evidence of the original government corner. The old highway survey also shows this location as the corner. Bob Chalsma used this point as the corner also in Aug. of 1984.

Describe or show any material discrepancy between the location of the restored corner and that of the corner previously restored or reestablished.

None known.

RECORD OF DURABLE WITNESS MONUMENTS

NO	DESCRIPTION	BEARING	DISTANCE
1	Set 11/16"x24" round iron bar 2.3' E.of	power pole,N72°W	±, 98.50
2	Set 1/2"x16½" rebar	South±	24.75
3	To center @ base of telephone pedestal	-------	40.6
4			

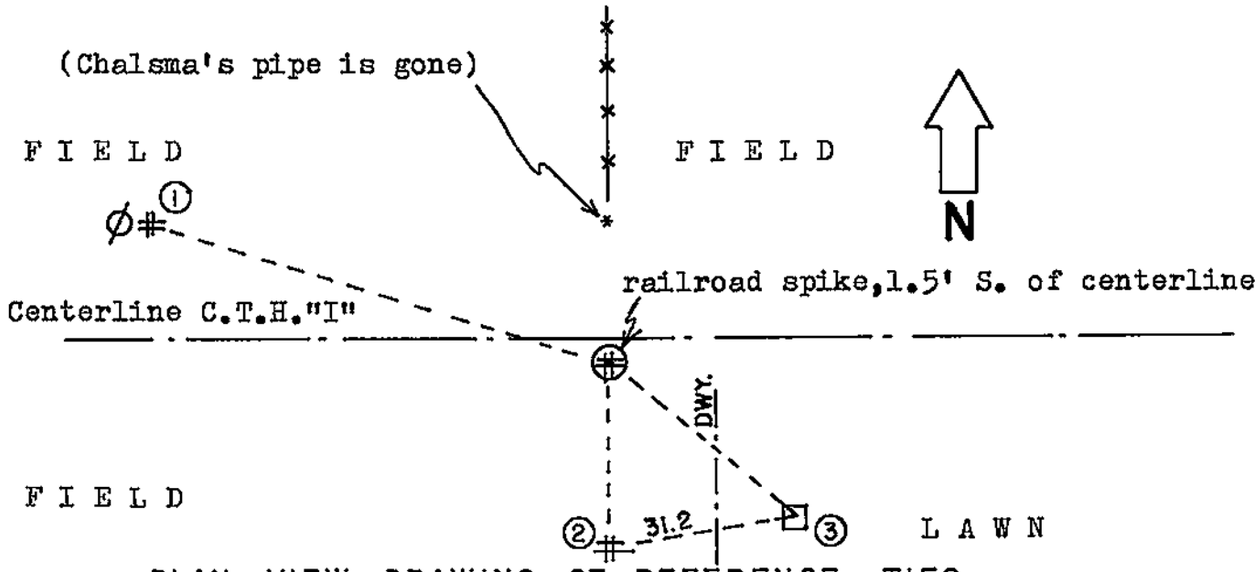

PLAN VIEW DRAWING OF REFERENCE TIES

MAP SHOWING DISTANCE AND DIRECTION TO OTHER PUBLIC LAND SURVEY CORNERS USED FOR REESTABLISHING THE CORNER

I tied in enough field evidence to verify this corner:

(1) 2646.66' to a temporary or preliminary 1/4 location to the East. I have an iron pipe at that point.

(2) 2638.6'± to a temporary or preliminary 1/4 location to the West. I have an iron pipe at that point over an existing nail.

(3) Chalsma measured 5258.97' to a stone to the North.

(4) I also measured to the section corner 1 mile to the East. As I did not have an EDM, I triangulated.

I, William C, Jung, Deputy County Surveyor,
HEREBY CERTIFY THAT THE CORNER LOCATION SHOWN ON THIS RECORD WAS DETERMINED BY ME OR UNDER MY DIRECTION AND CONTROL AND THAT THIS U. S. PUBLIC LAND SURVEY MONUMENT RECORD IS CORRECT AND COMPLETE TO THE BEST OF MY KNOWLEDGE AND BELIEF.

William C. Jung — 2/11/86

Signature — Date

WISCONSIN WILLIAM C. JUNG S-1323 ONALASKA, WIS. LAND SURVEYOR

Seal